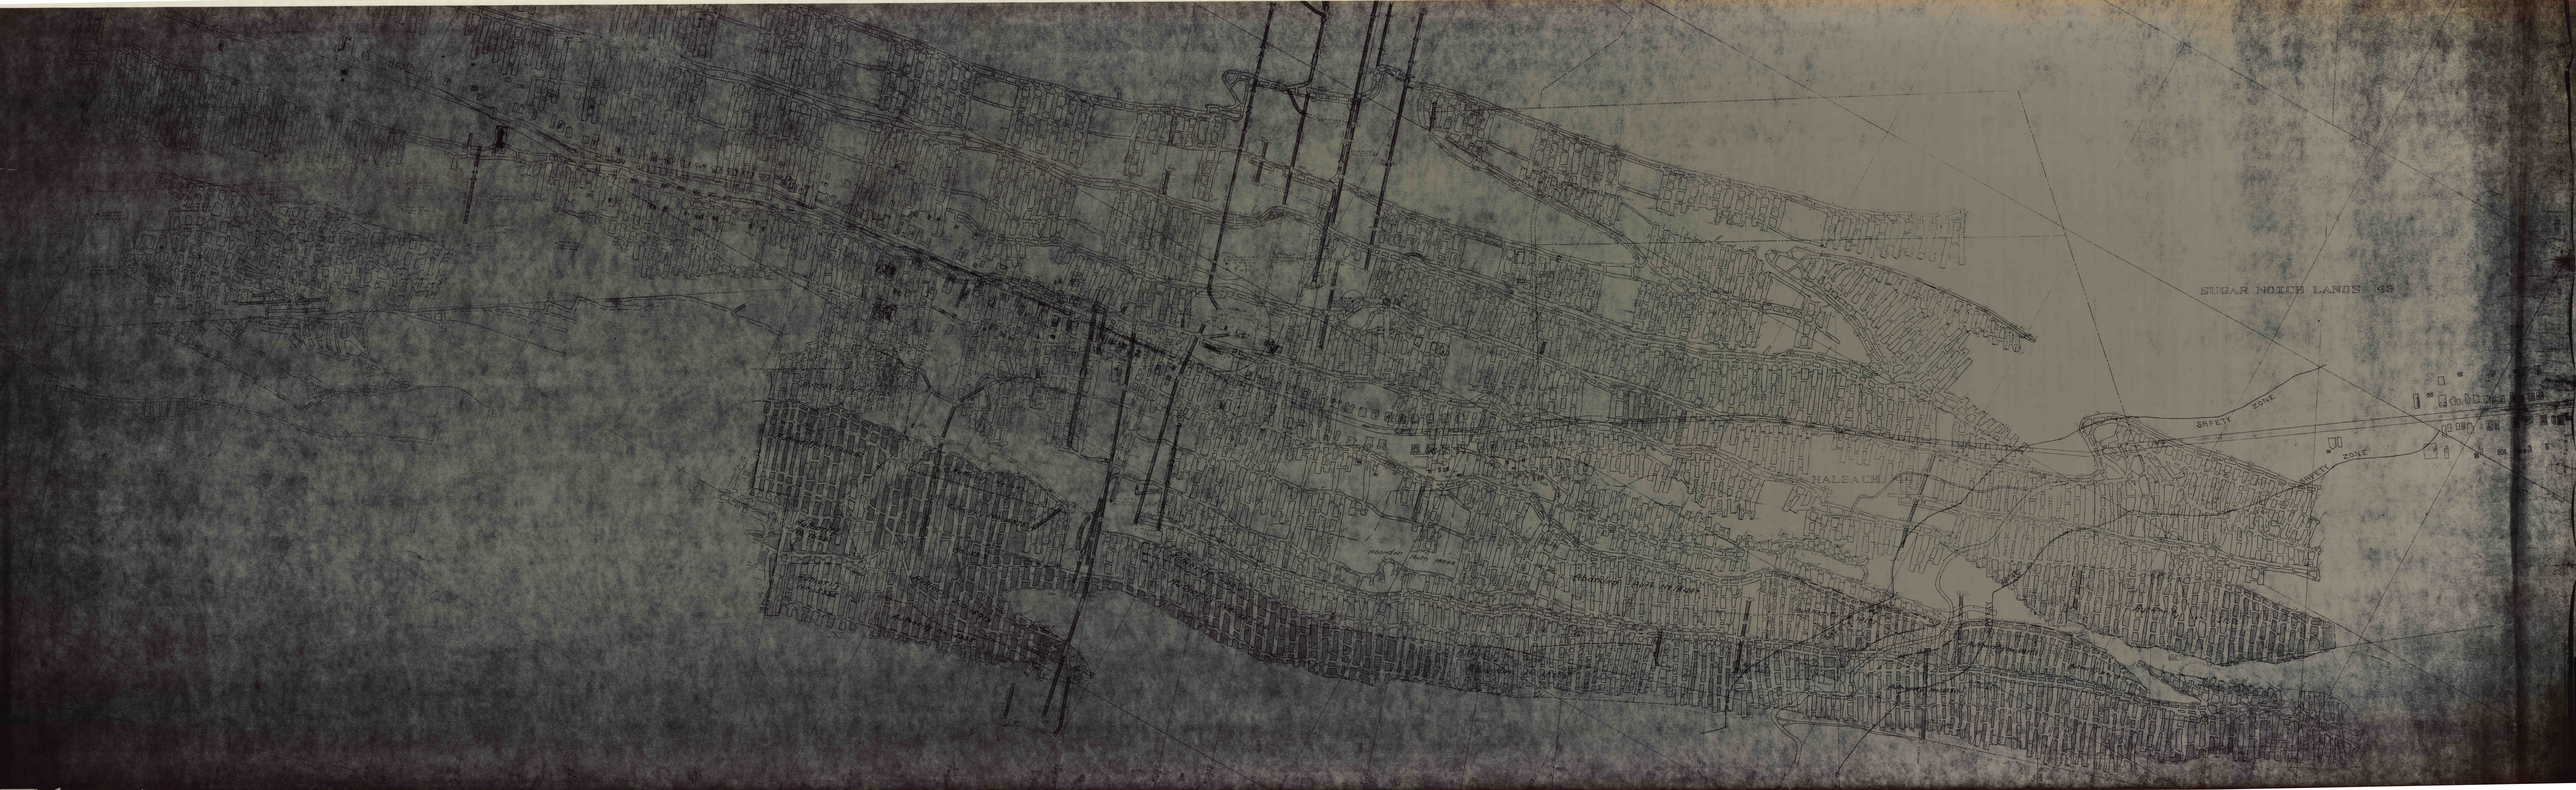
SUGAR NOTCH LANDS
SAFETY ZONE
SAFETY ZONE
HALEACH