


DAVID BROWN TRACT JESSUP

DAVID BROWN TRACT JESSUP

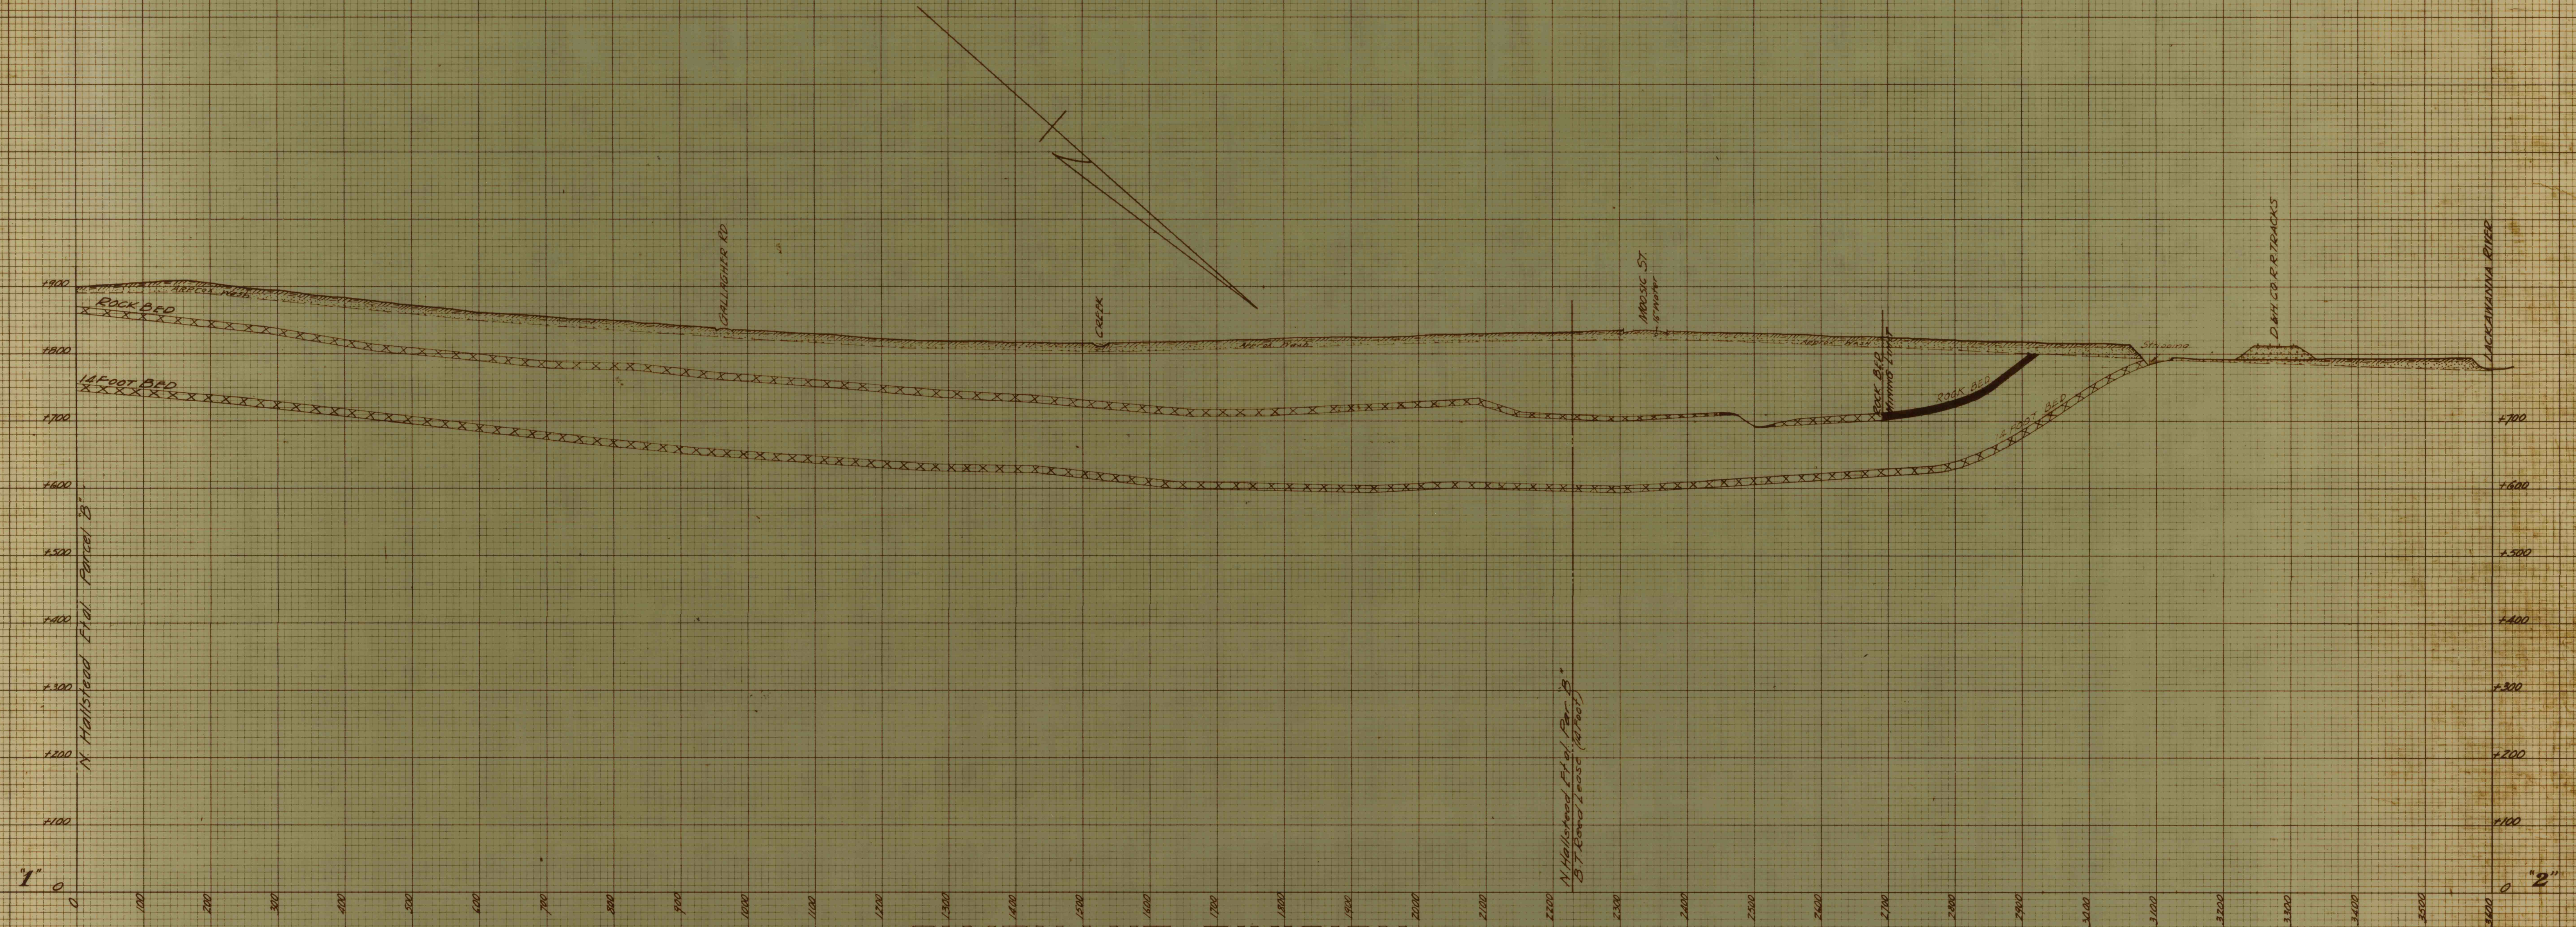

POSTED			
DATE	BY WHOM	DATE	BY WHOM
Feb. 19, 1930	K.M.		
Mar. 20, 1931	K.M.		
Nov. 21, 1932	K.M.		
June 21, 1934	K.M.		
June 25, 1935	K.M.		
Apr. 2, 1936	K.M.		
Sept. 7, 1937	K.M.		
Apr. 29, 1948	J.R.		

OLYPHANT DIVISION
CROSS SECTION

1-2

S.W. THRU COAL MEASURES
ON THE DAVID BROWN TRACT JESSUP
SCALE 1"=100' FEB. 19, 1930.

