


(17) (28) 8517 NORTH COAST IN TOWNSHIP

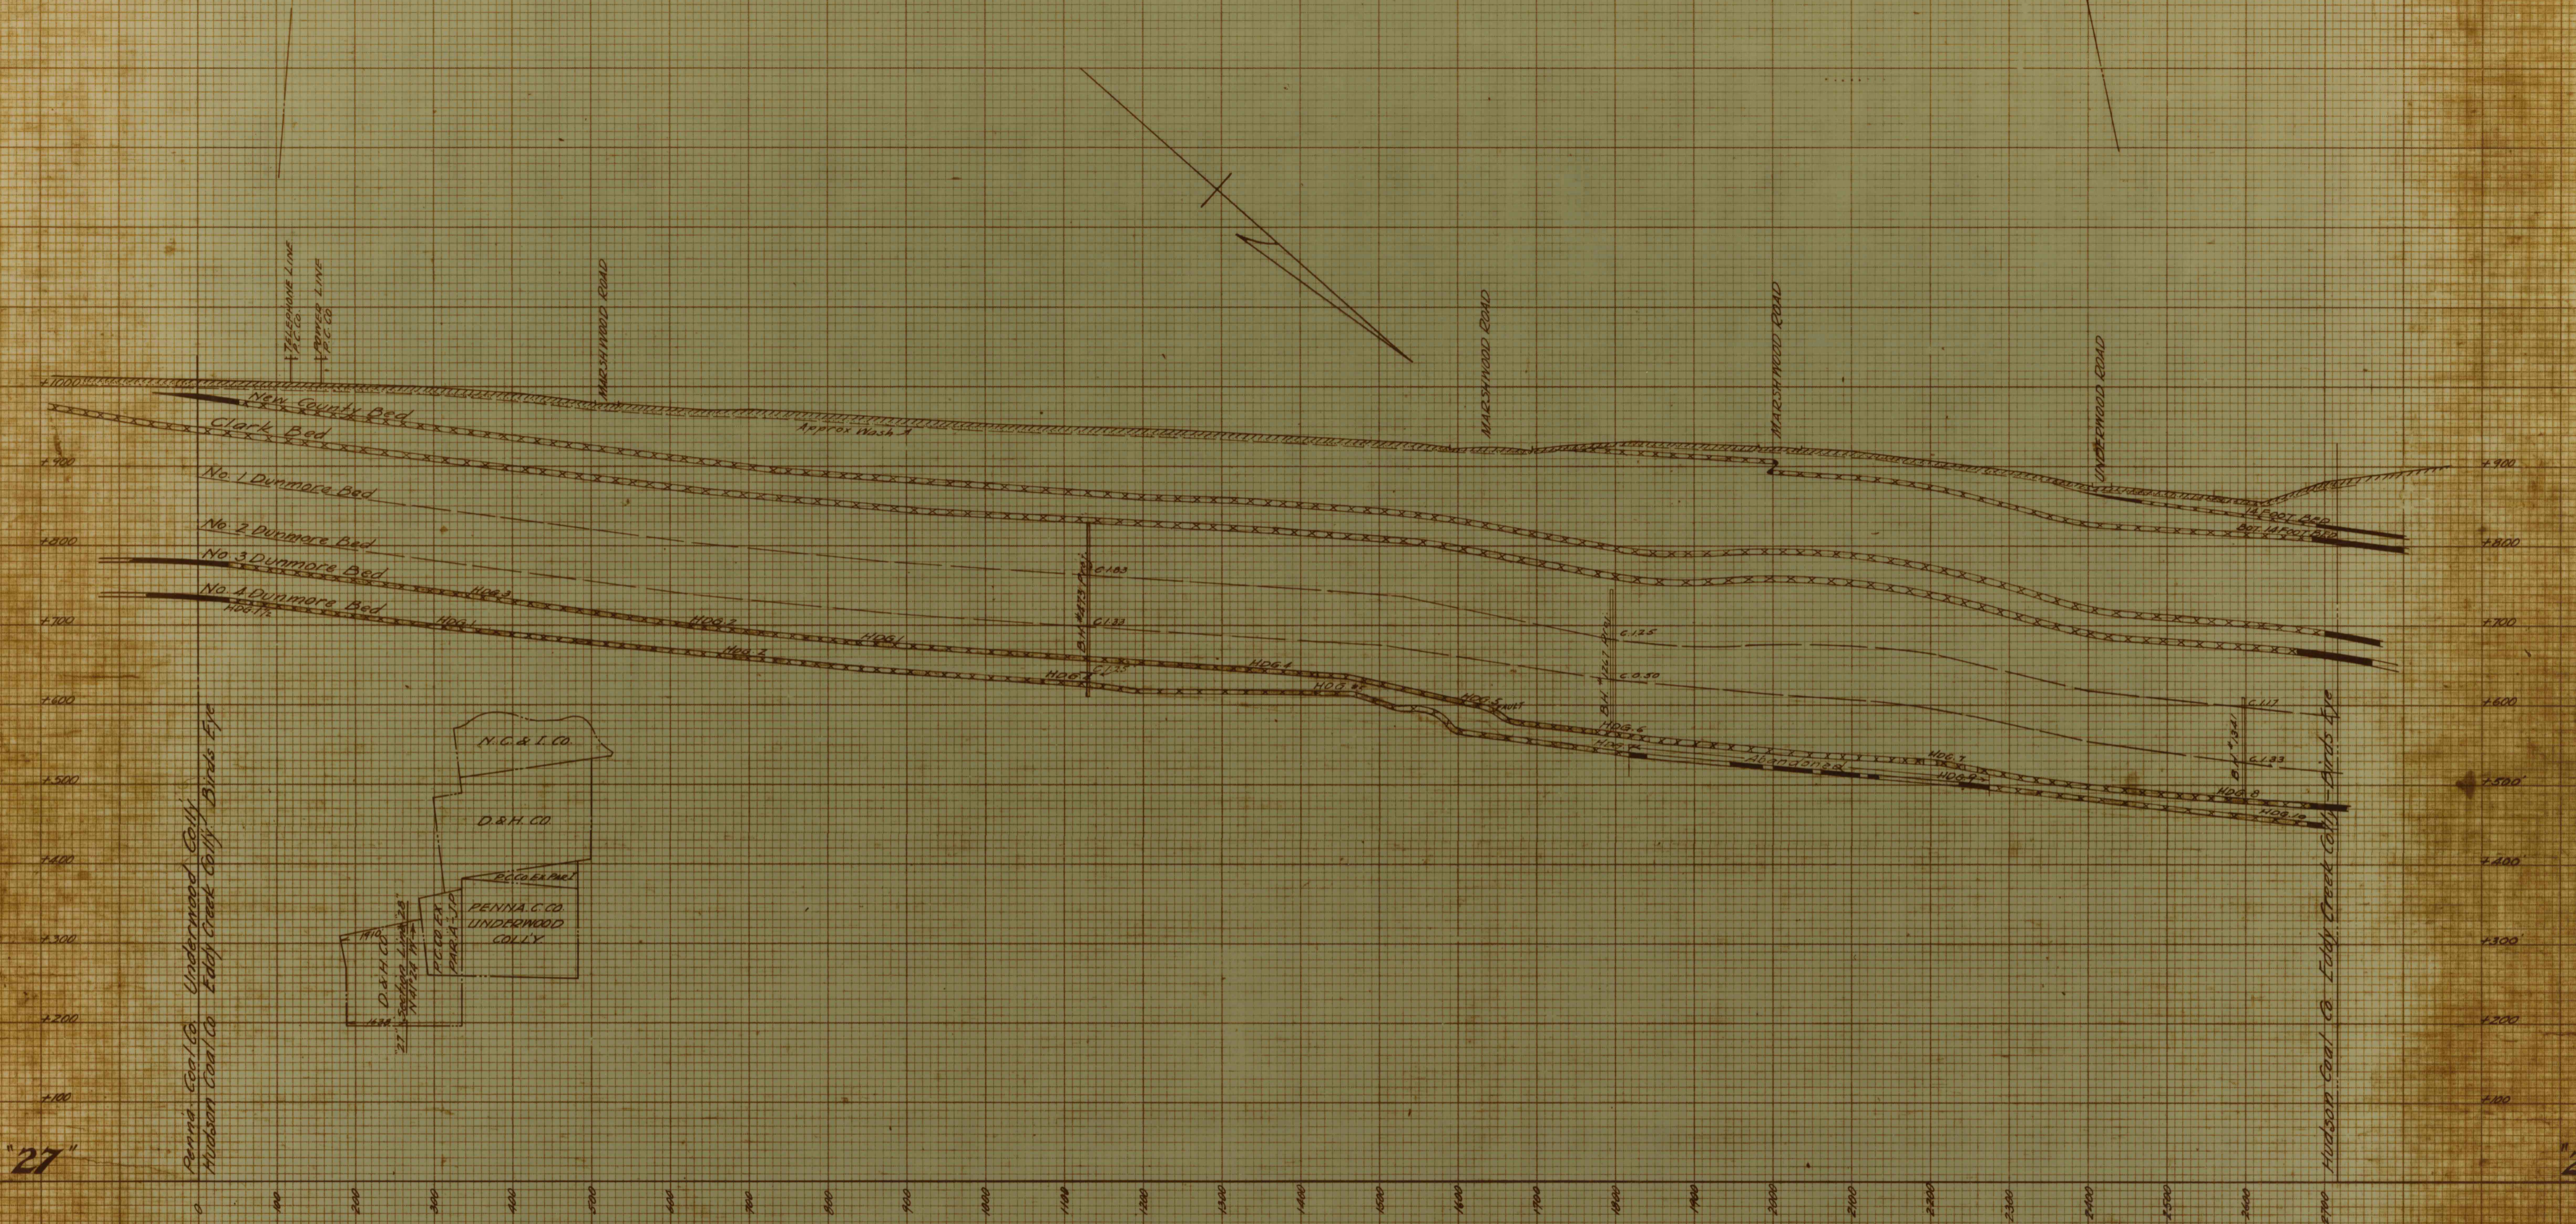

OLYPHANT DIVISION
 CROSS SECTION
 27-28

THRU COAL MEASURES LOOKING S.W.
 THRU PROPERTY AT BIRDS EYE
 SCALE 1"=100'
 MAY 21 1931

POSTED	DATE	POSTED	DATE
K.C.M.	10-17-32		
K.C.M.	11-21-32		
K.C.M.	6-2-34		
K.C.M.	12-31-34		
K.C.M.	7-25-35		
K.C.M.	7-27-36		
K.C.M.	10-27-37		
K.C.M.	12-21-38		
J.K.L.	3-18-40		
K.C.M.	5-21-41		
I.R.	4-10-45		
I.R.	5-19-54		