


OLYPHANT DIV. CROSS SECTION 29-30 (BIRDS EYE)

OLYPHANT DIV. CROSS SECTION 29-30 (BIRDS EYE)

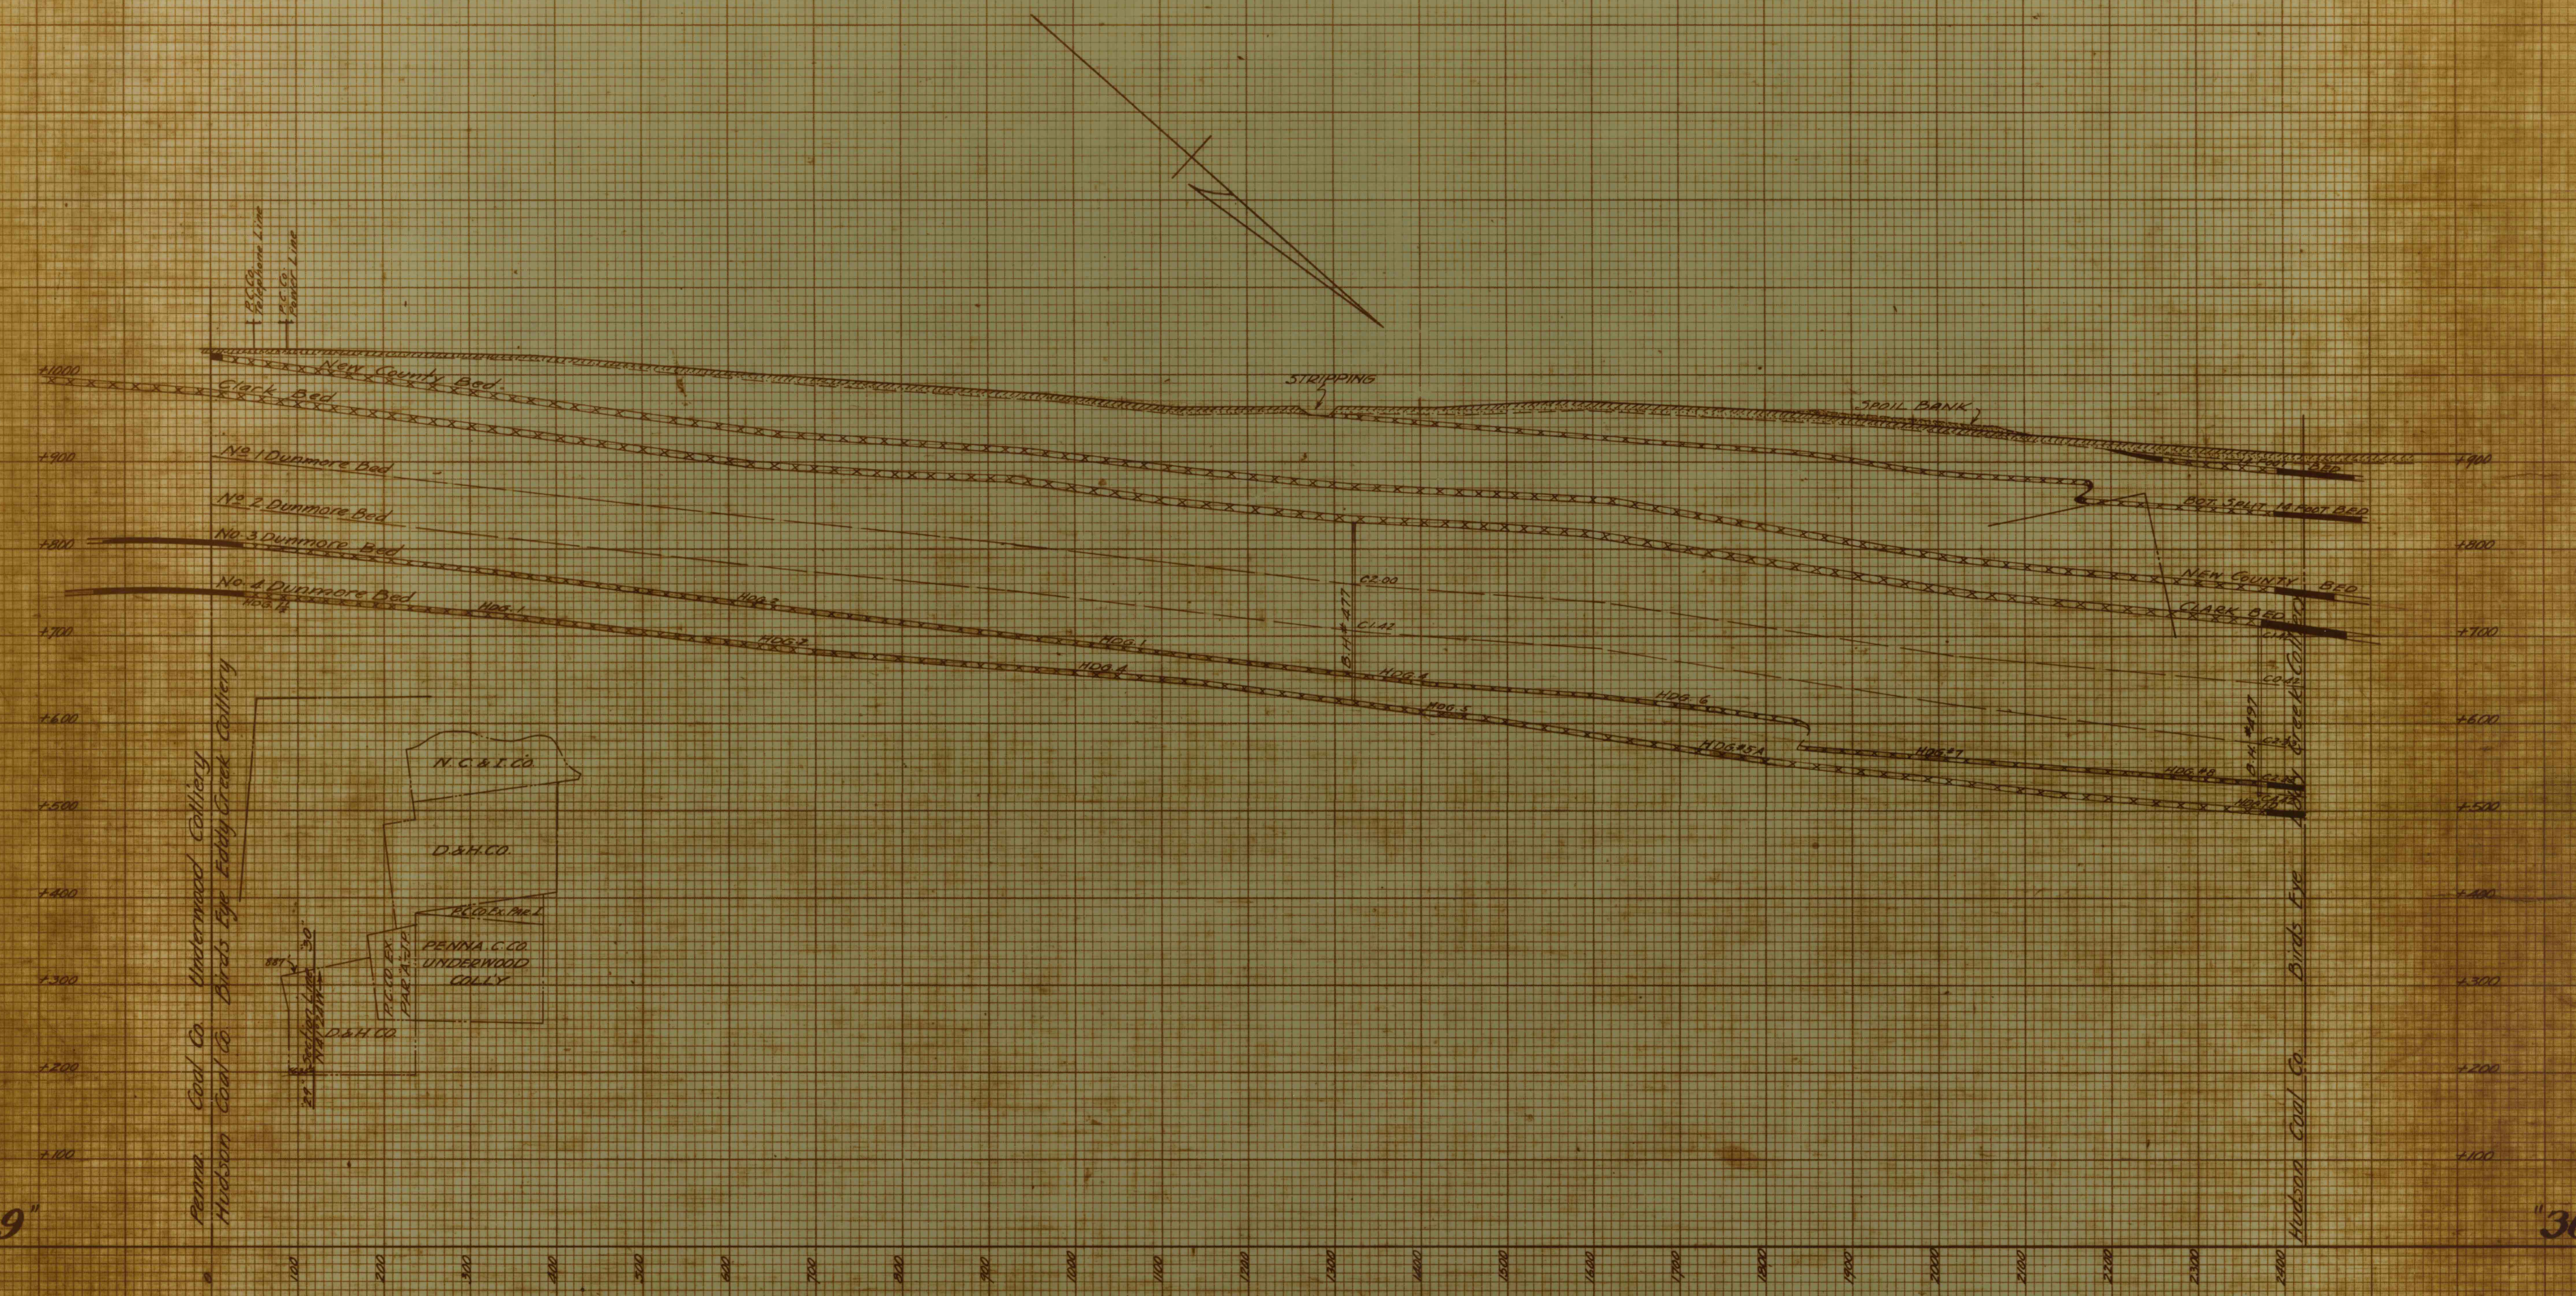

OLYPHANT DIVISION  
CROSS SECTION  
29-30

THRU COAL MEASURES LOOKING S.W.  
THRU PROPERTY AT BIRDS EYE  
SCALE 1"=100'  
MAY 21, 1931.

POSTED	DATE	POSTED	DATE
K.G.M.	10-17-32		
K.G.M.	11-21-32		
K.G.M.	6-2-32		
K.G.M.	12-31-32		
K.G.M.	7-25-35		
K.G.M.	7-27-36		
K.G.M.	10-26-37		
K.G.M.	12-21-38		
K.G.M.	5-18-40		
K.G.M.	5-21-41		
H.R.	4-11-43		