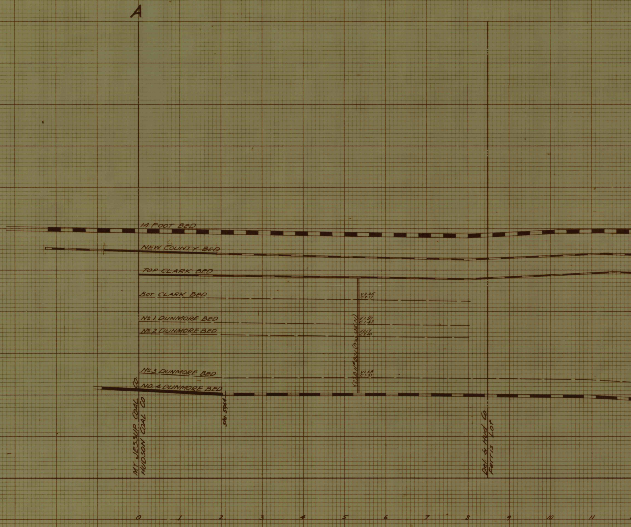
A
14 FOOT BED
NEW COUNTY BED
TOP CLARK BED
BOT. CLARK BED
Nº 1 DUNMORE BED
Nº 2 DUNMORE BED
Nº 3 DUNMORE BED
NO. 4 DUNMORE BED
V 2.25
C 2.17
V 1.50
C 1.42
V 2.17
C 2.00
V 1.58
C 1.33
(2) B.H. #803 (Prob. 158 N)
MT. JESSUP COAL CO.
HUDSON COAL CO.
Sta. 5964
Del. & Hud. Co.
Ferris Lot
0
1
2
3
4
5
6
7
8
9
10
11

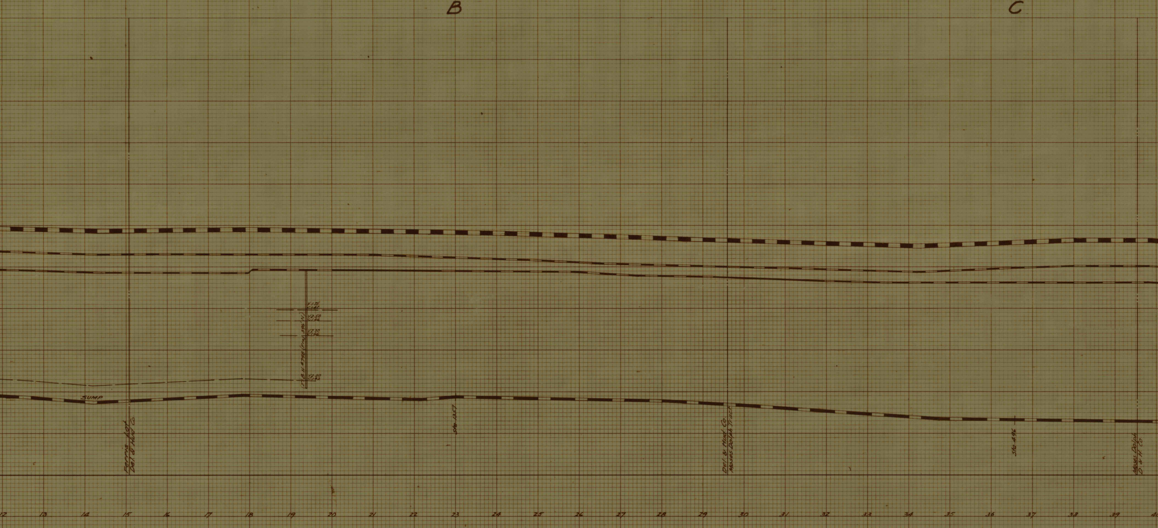
B
C
SUMP
Ferris Lot
Del. & Hud. Co.
B.H. #798 (Proj. 396' N)
V.1.75
C.1.82
V2.50
C1.66
V2.30
C1.66
V2.50
C1.42
Sta. 13.57
Del. & Hud. Co.
Moses Dolph Tract
Sta. 4.96
Moses Dolph
D. & H. Co.
12
13
14
15
16
17
18
19
20
21
22
23
24
25
26
27
28
29
30
31
32
33
34
35
36
37
38
39

D

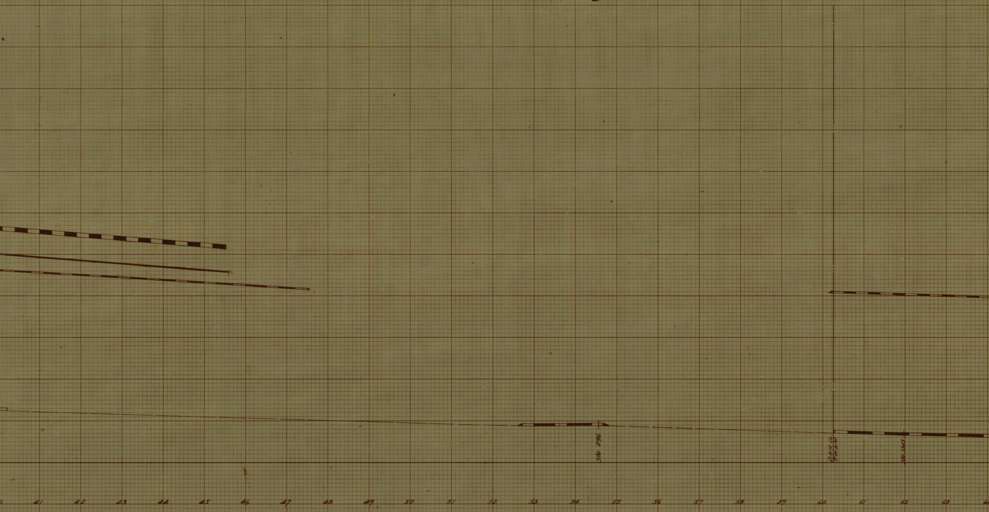

Sta. 296
D.&H. Co.
F.W.&M.
Sta. 3363
41
42
43
44
45
46
47
48
49
50
51
52
53
54
55
56
57
58
59
60
61
62
63

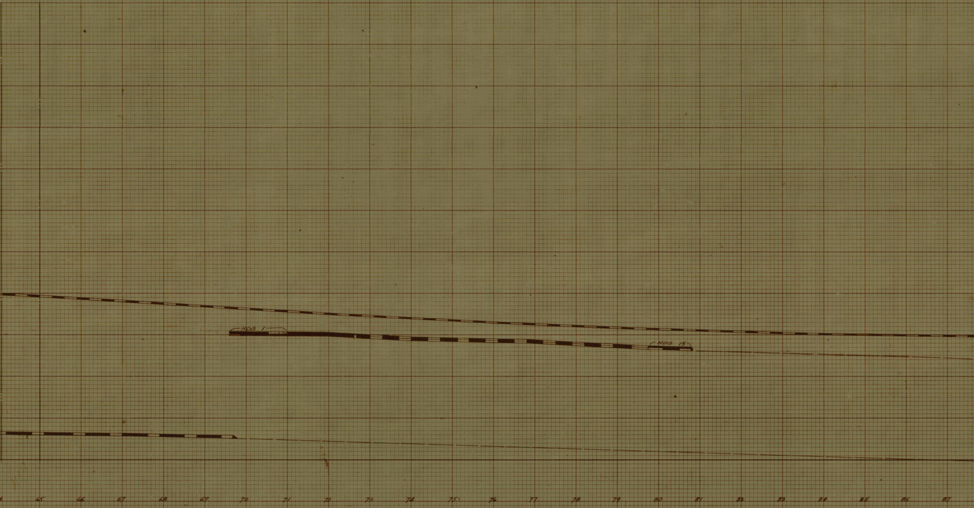
HDG 1
HDG 15
65
66
67
68
69
70
71
72
73
74
75
76
77
78
79
80
81
82
83
84
85
86
87

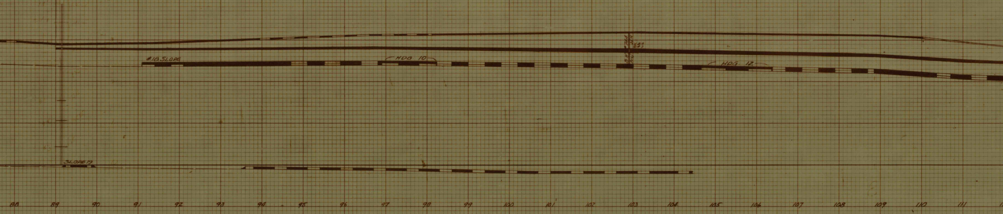
#18 SLOPE
HDG 10
HDG 12
SLOPE 19
88
89
90
91
92
93
94
95
96
97
98
99
100
101
102
103
104
105
106
107
108
109
110
111

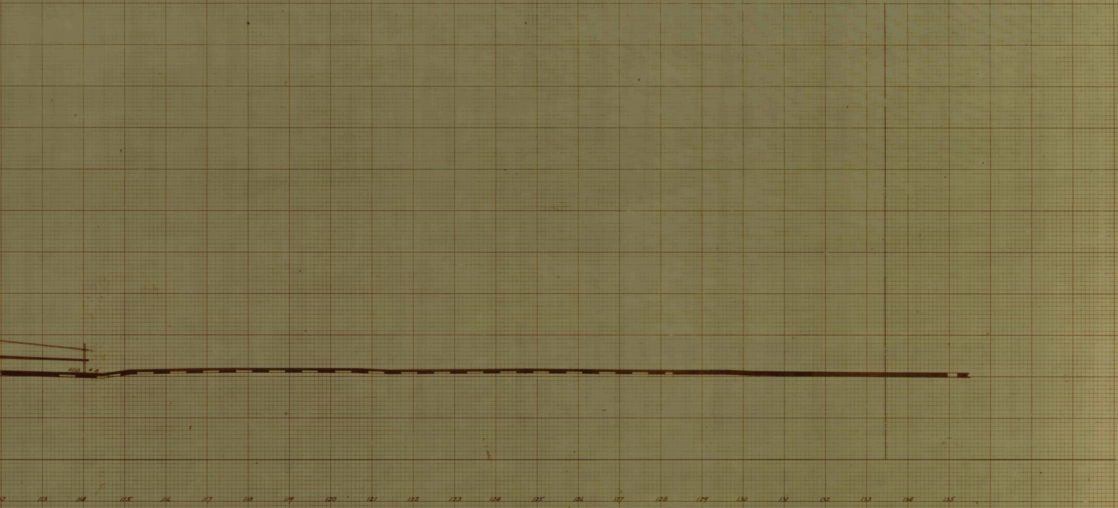
H.O.G. # 8
2
113
114
115
116
117
118
119
120
121
122
123
124
125
126
127
128
129
130
131
132
133
134
135