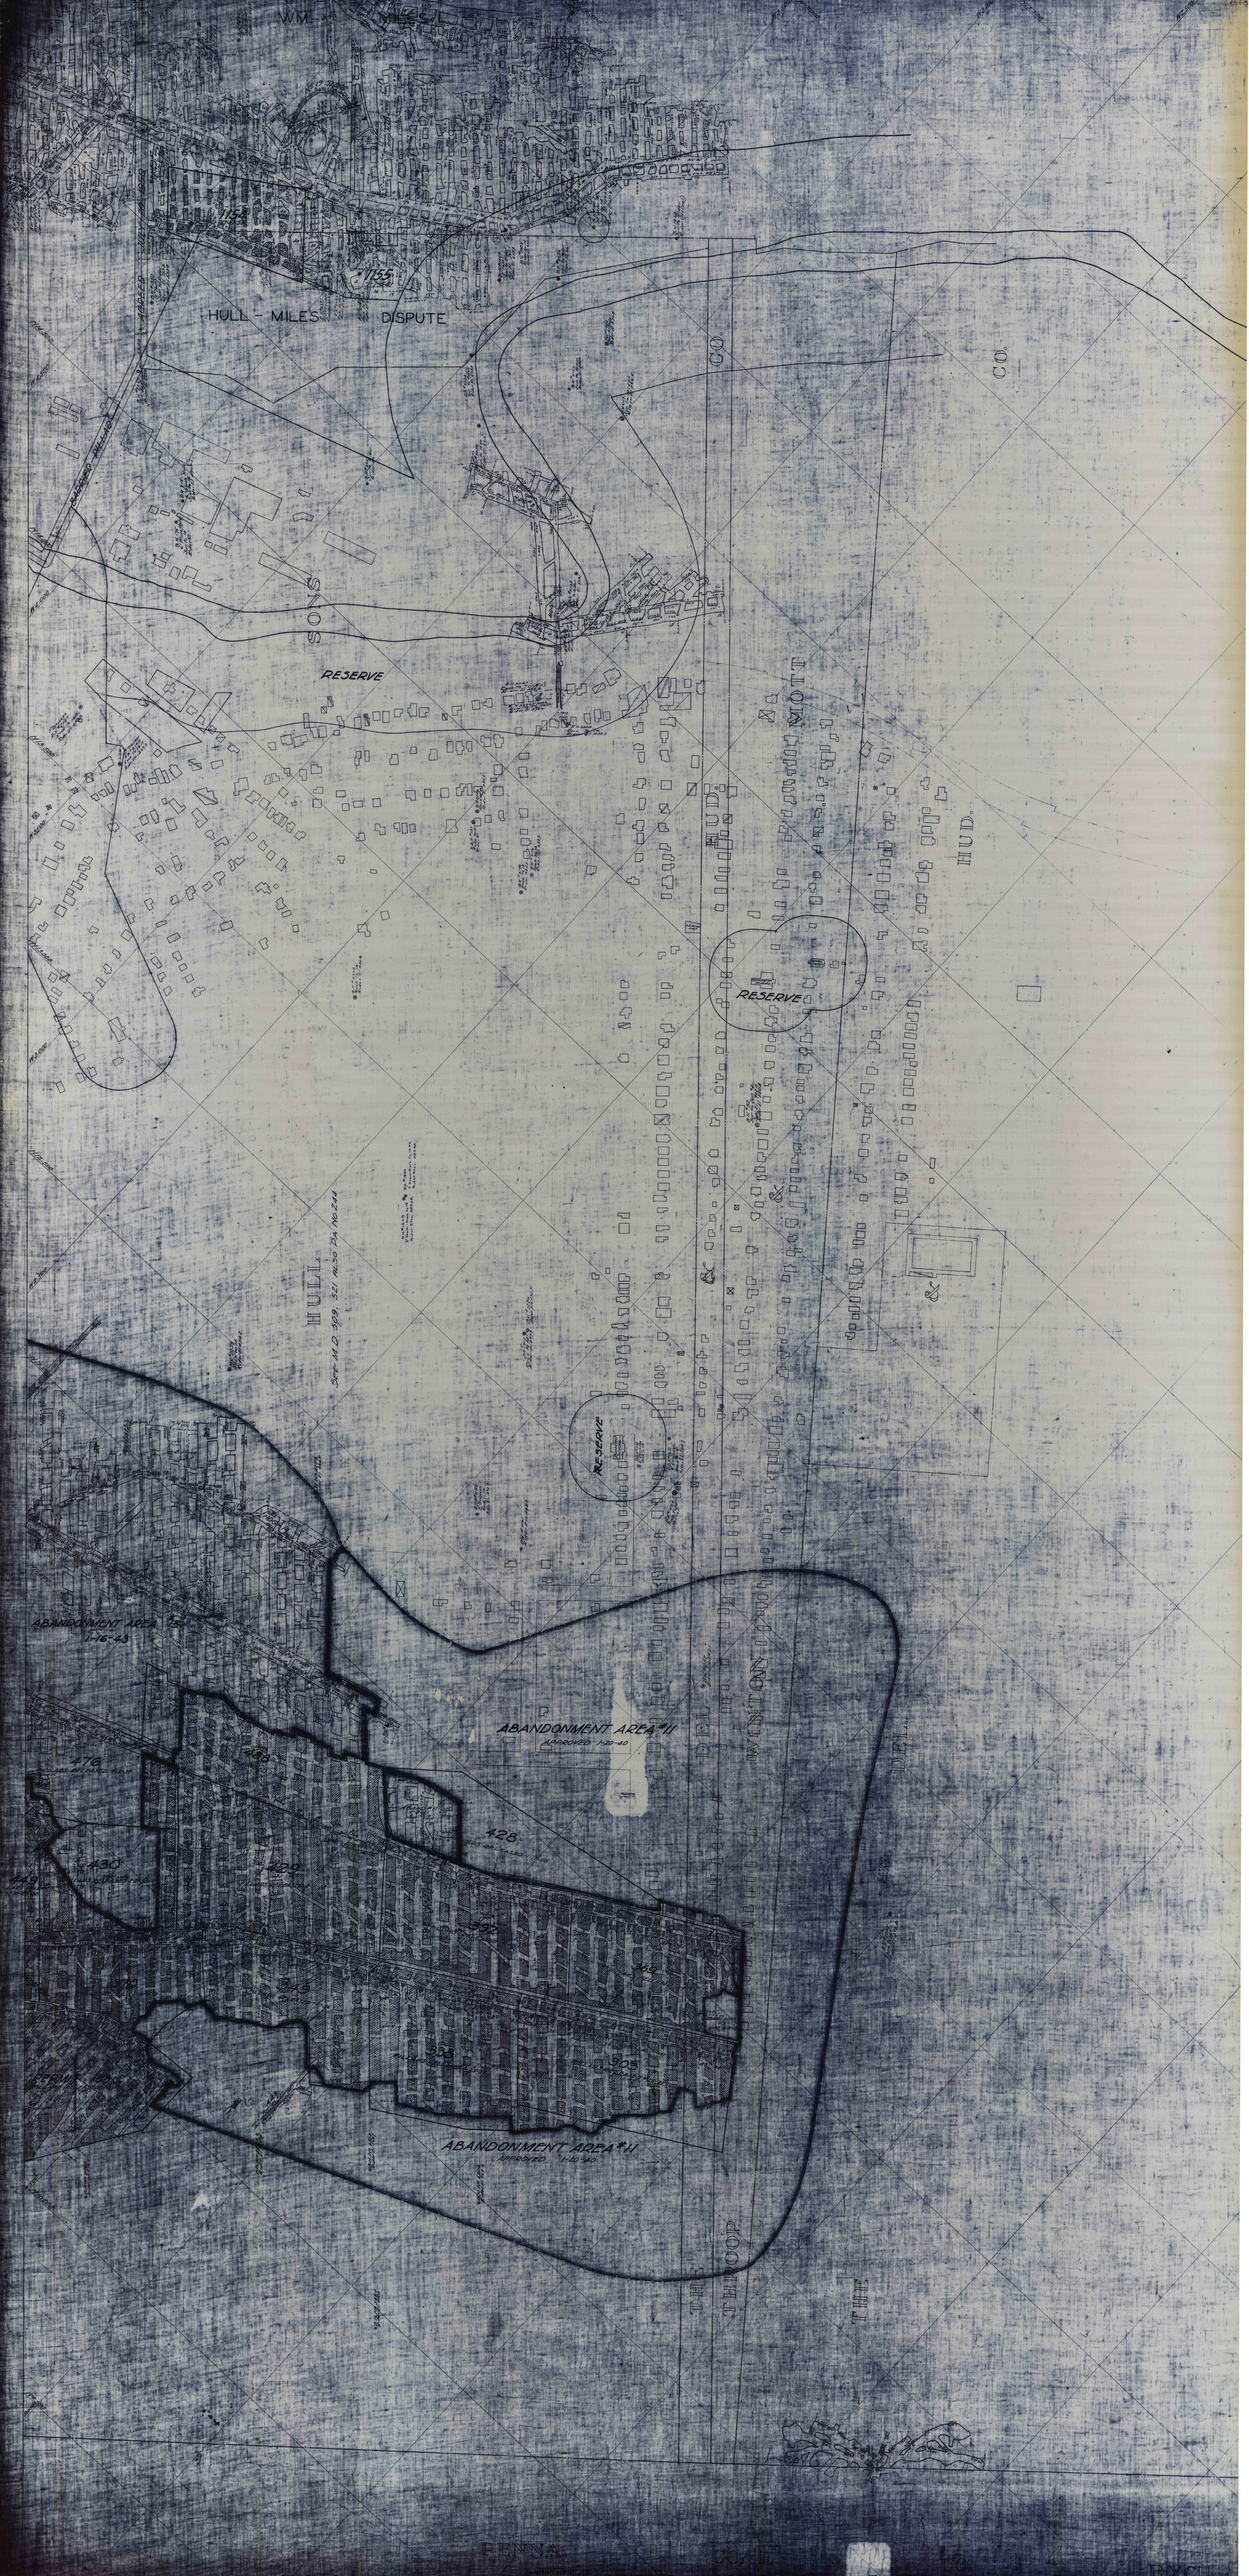

HULL
SEE M.D. 509, 521 ALSO PA. NO. 244
B.H. #2050 Rock to 14 Rider El. 454.2
B.H. #1849 3" Drain.-Rock to 14' Rider Elev. 483.68
B.H. #1850 3" Drain.-Rock to 14 Ft. Rider Elev. 483.92
ABANDONMENT AREA #11 APPROVED 1-20-40
ABANDONMENT AREA #11 APPROVED 1-20-40
B.H. No. 6818 Rider El. 768.7
B.H. No. 6808 Rider El. 769.4
338
392
305
369
428
430
B.H. #1157 Rider El. 547.1
RESERVE
RESERVE
RESERVE
SONS
THROOP
THE
DEL.
WINTON
&
HUD.
CO.
&
MOTT
THE
DEL.
&
HUD.
CO.
HULL - MILES DISPUTE
AGREED JULY 20, 1950
B.H. #2060 Sur. to Rider Rider El. 523.9
B.H. #1550 (2" Test) Sur. to Rider Sur. El. 753.8 Rider El. 573.9
B.H. #1547 (2" Test) Sur. to Rider Rider El. 643.5
B.H. #1567 (2" Test) Sur. to Rider Sur. El. 780.0 Rider El. 659.2
B.H. #1499 (3" Drain) Rock to 14 Rider El. 667.3
B.H. #2277 Rider to 14 Ft. Rider El. 625.0
B.H. #2033 Sur. to Rider Rider El. 633.0
B.H. #2030 Sur. to 14 Ft. Rider El. 571.3
B.H. #1559 (2" Test) Sur. to Rider Sur. El. 762.1 Rider El. 669.8
B.H. #2082 Rider to 14 Rider El. 666.1
1134
1135
No. 19 SLOPE
ROCK BED
W.M.