


0-50-1

WILES GLOBE - RIDER BED

0-50-1

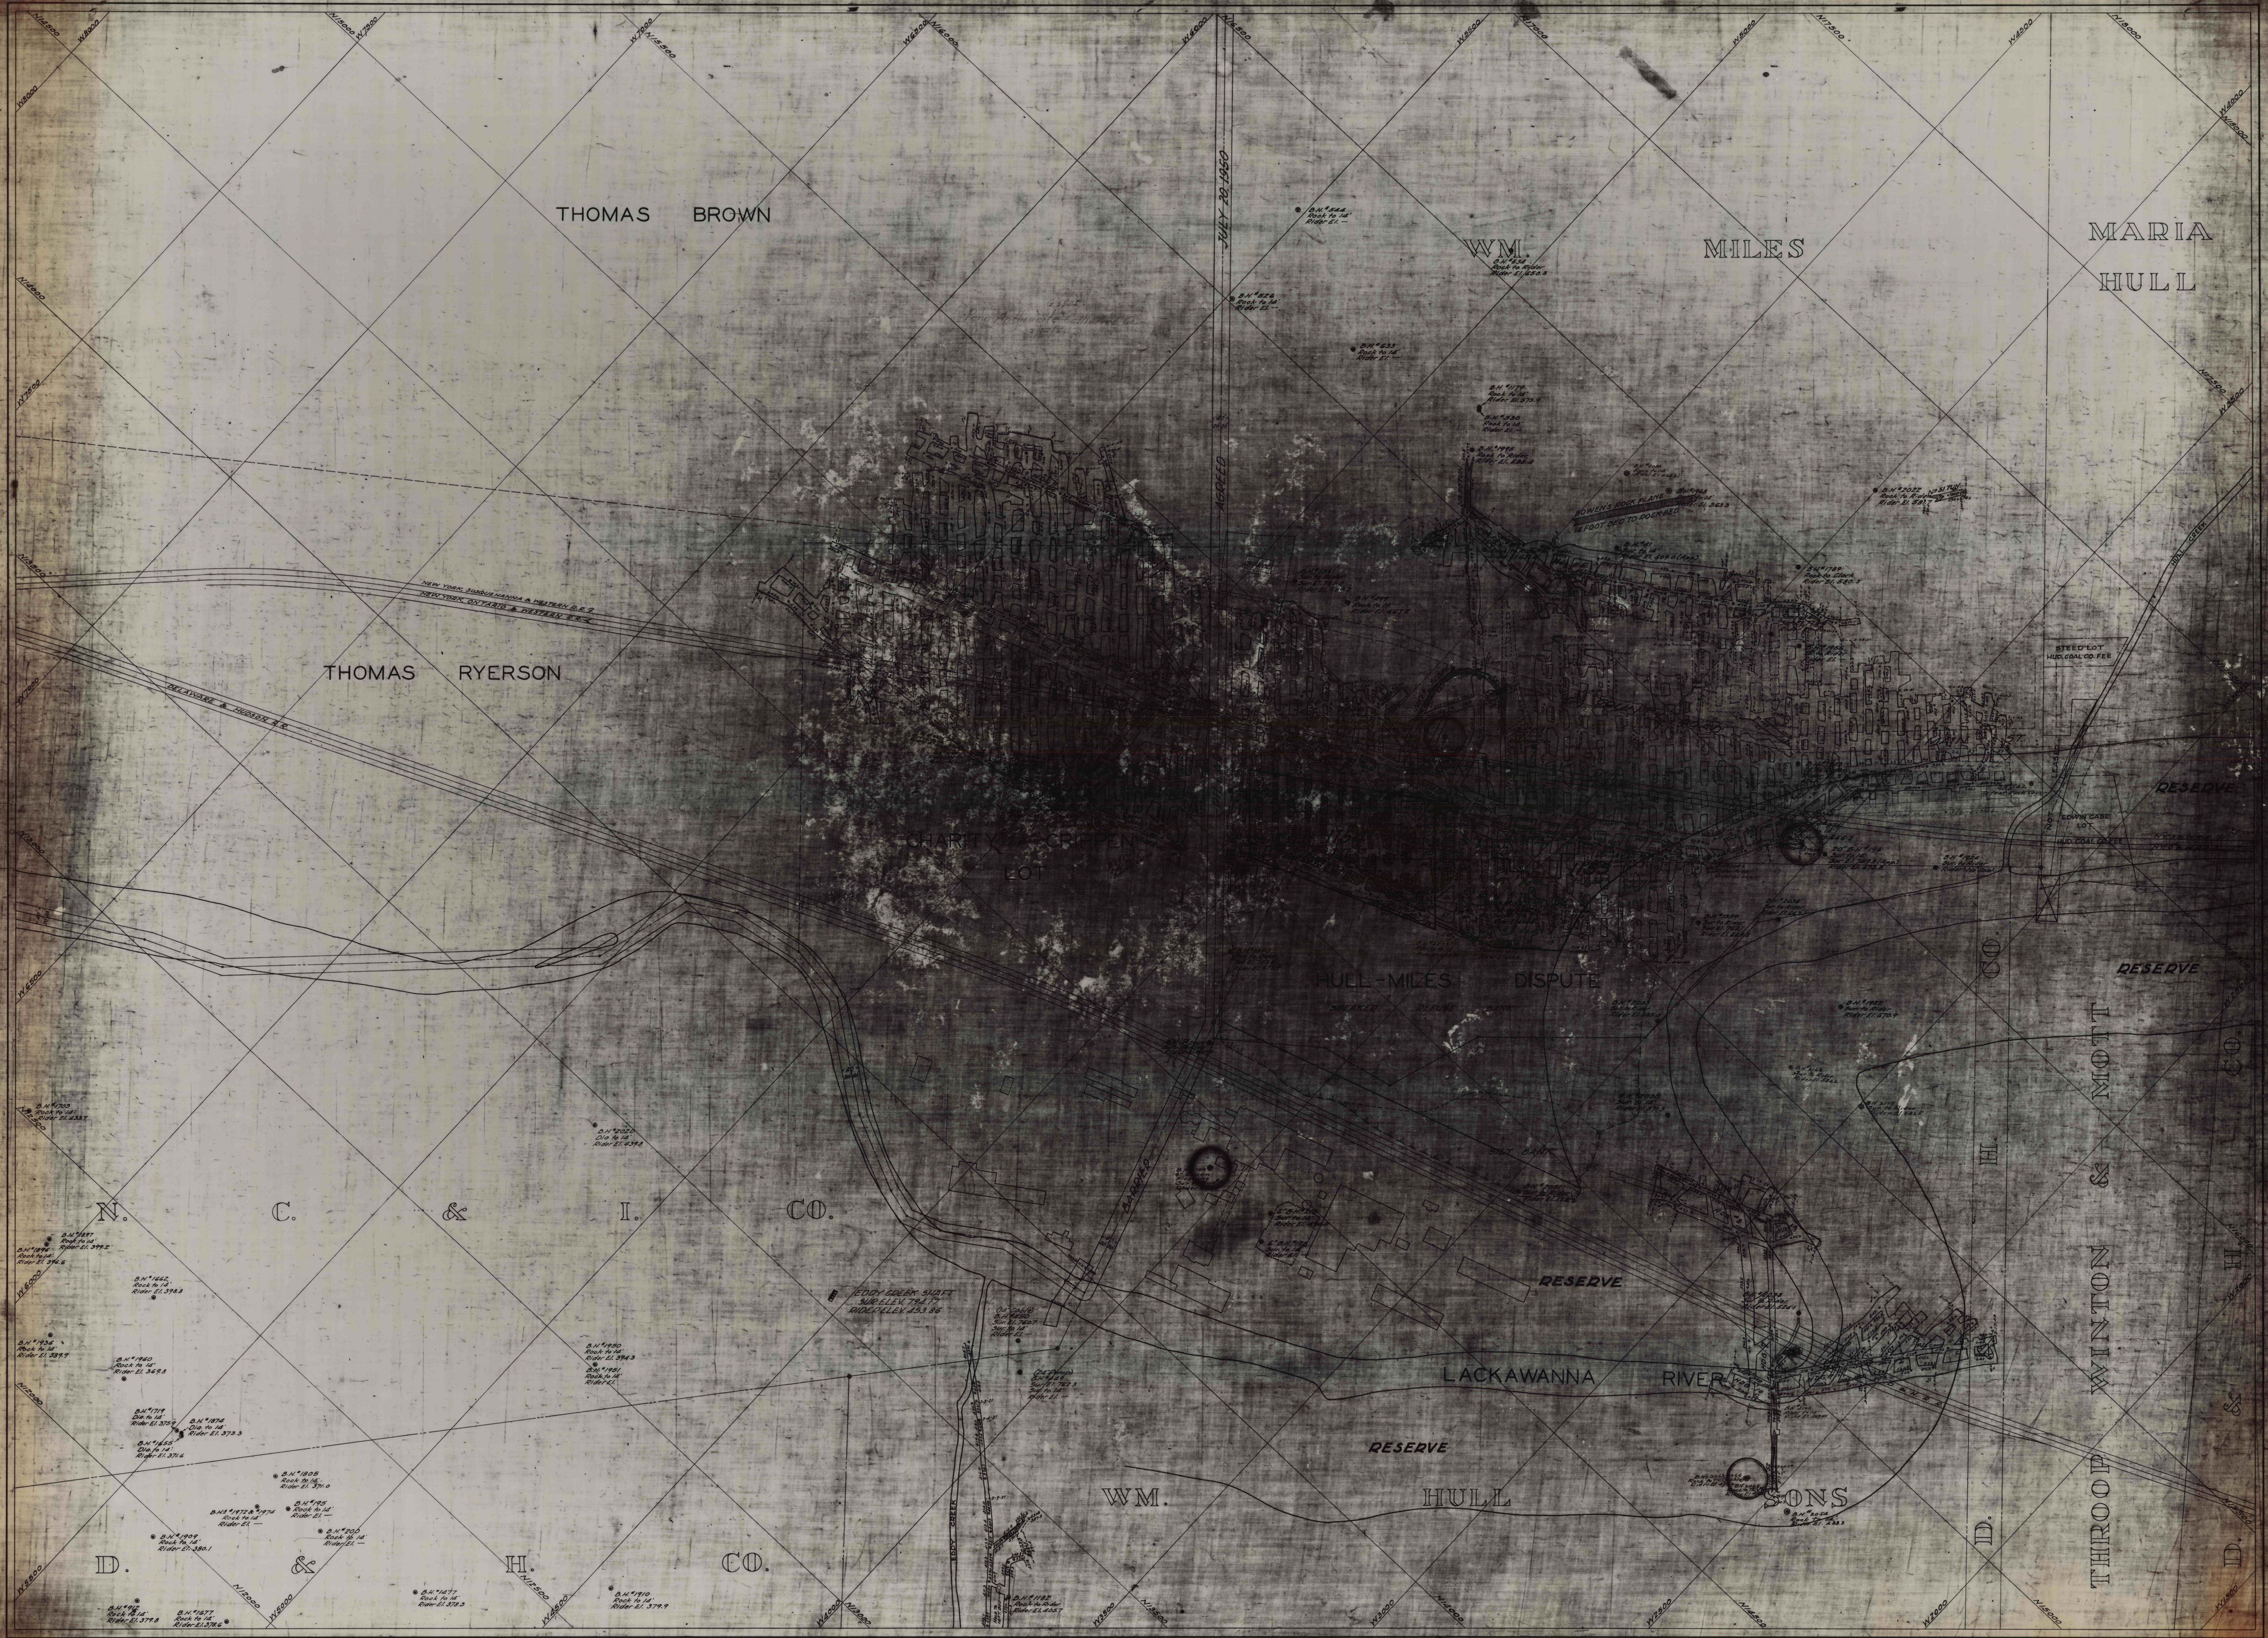

0-50-1

WILES GLOBE - RIDER BED

0-50-1