


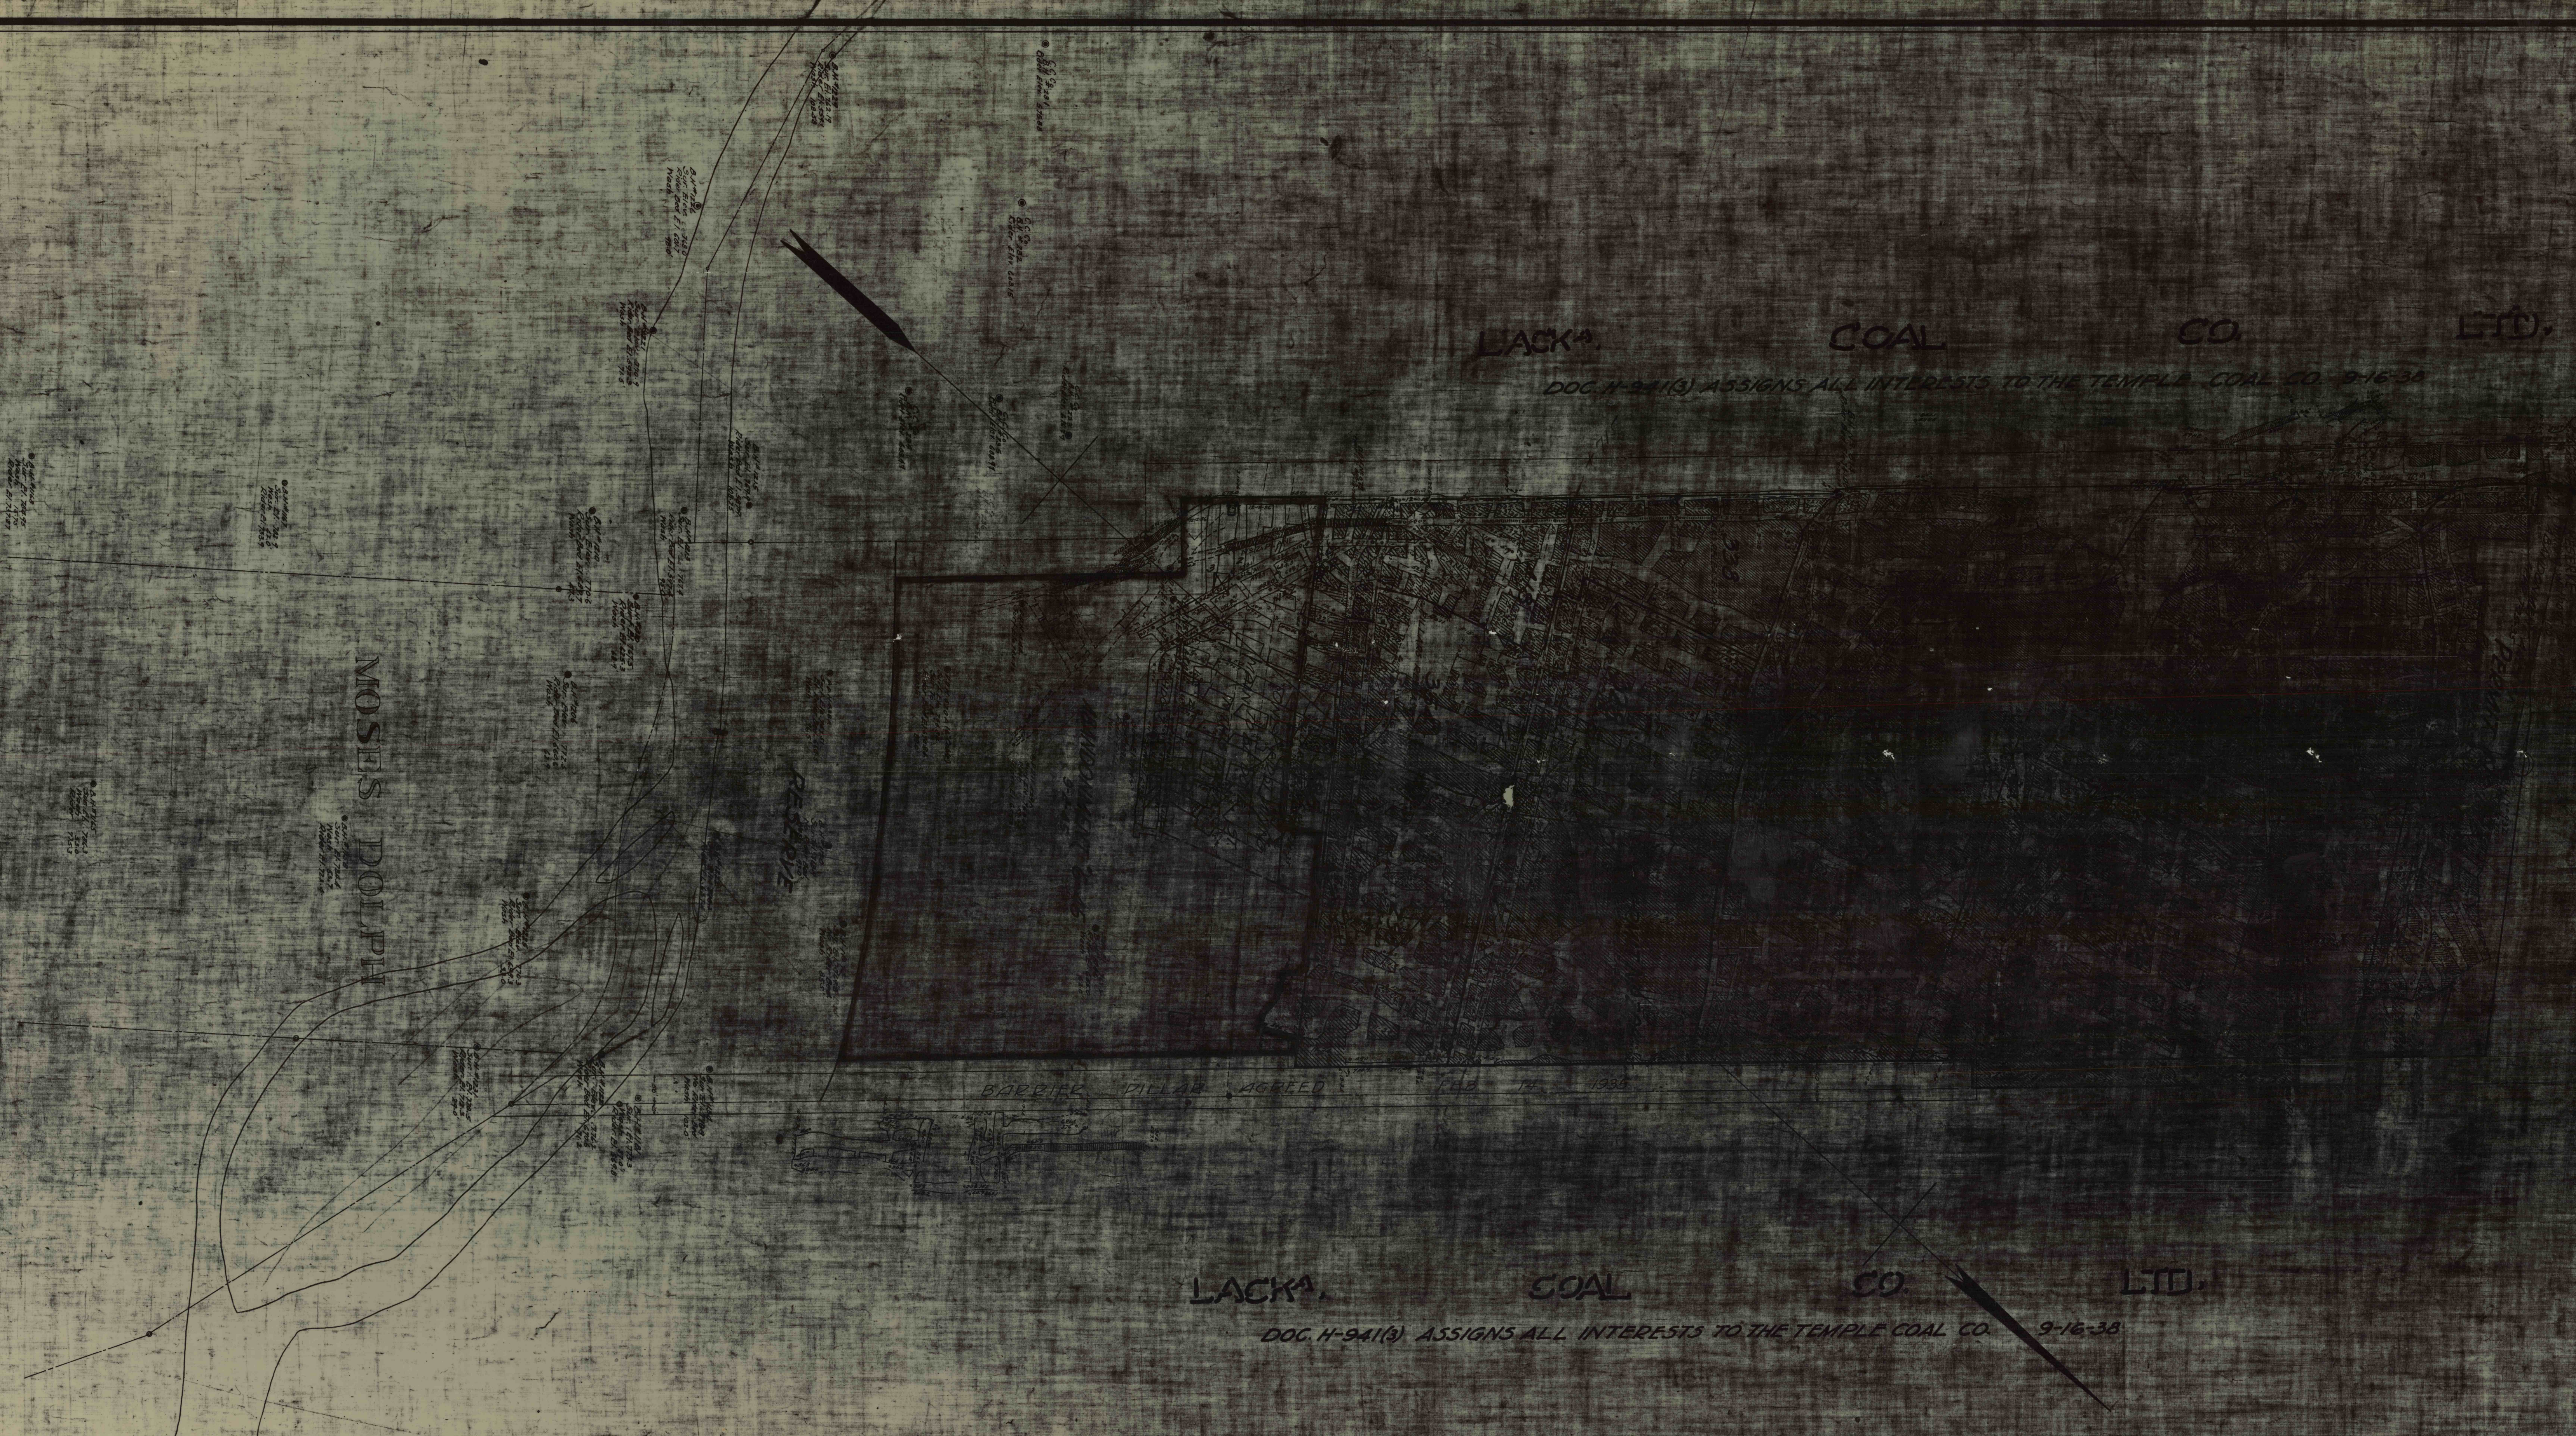

LACK COAL CO. LTD.

DOC. H-941(3) ASSIGNS ALL INTERESTS TO THE TEMPLE COAL CO. 9-16-38



BARRIER PILLAR AGREED FEB 14 1938

LACK COAL CO. LTD.

DOC. H-941(3) ASSIGNS ALL INTERESTS TO THE TEMPLE COAL CO. 9-16-38

