
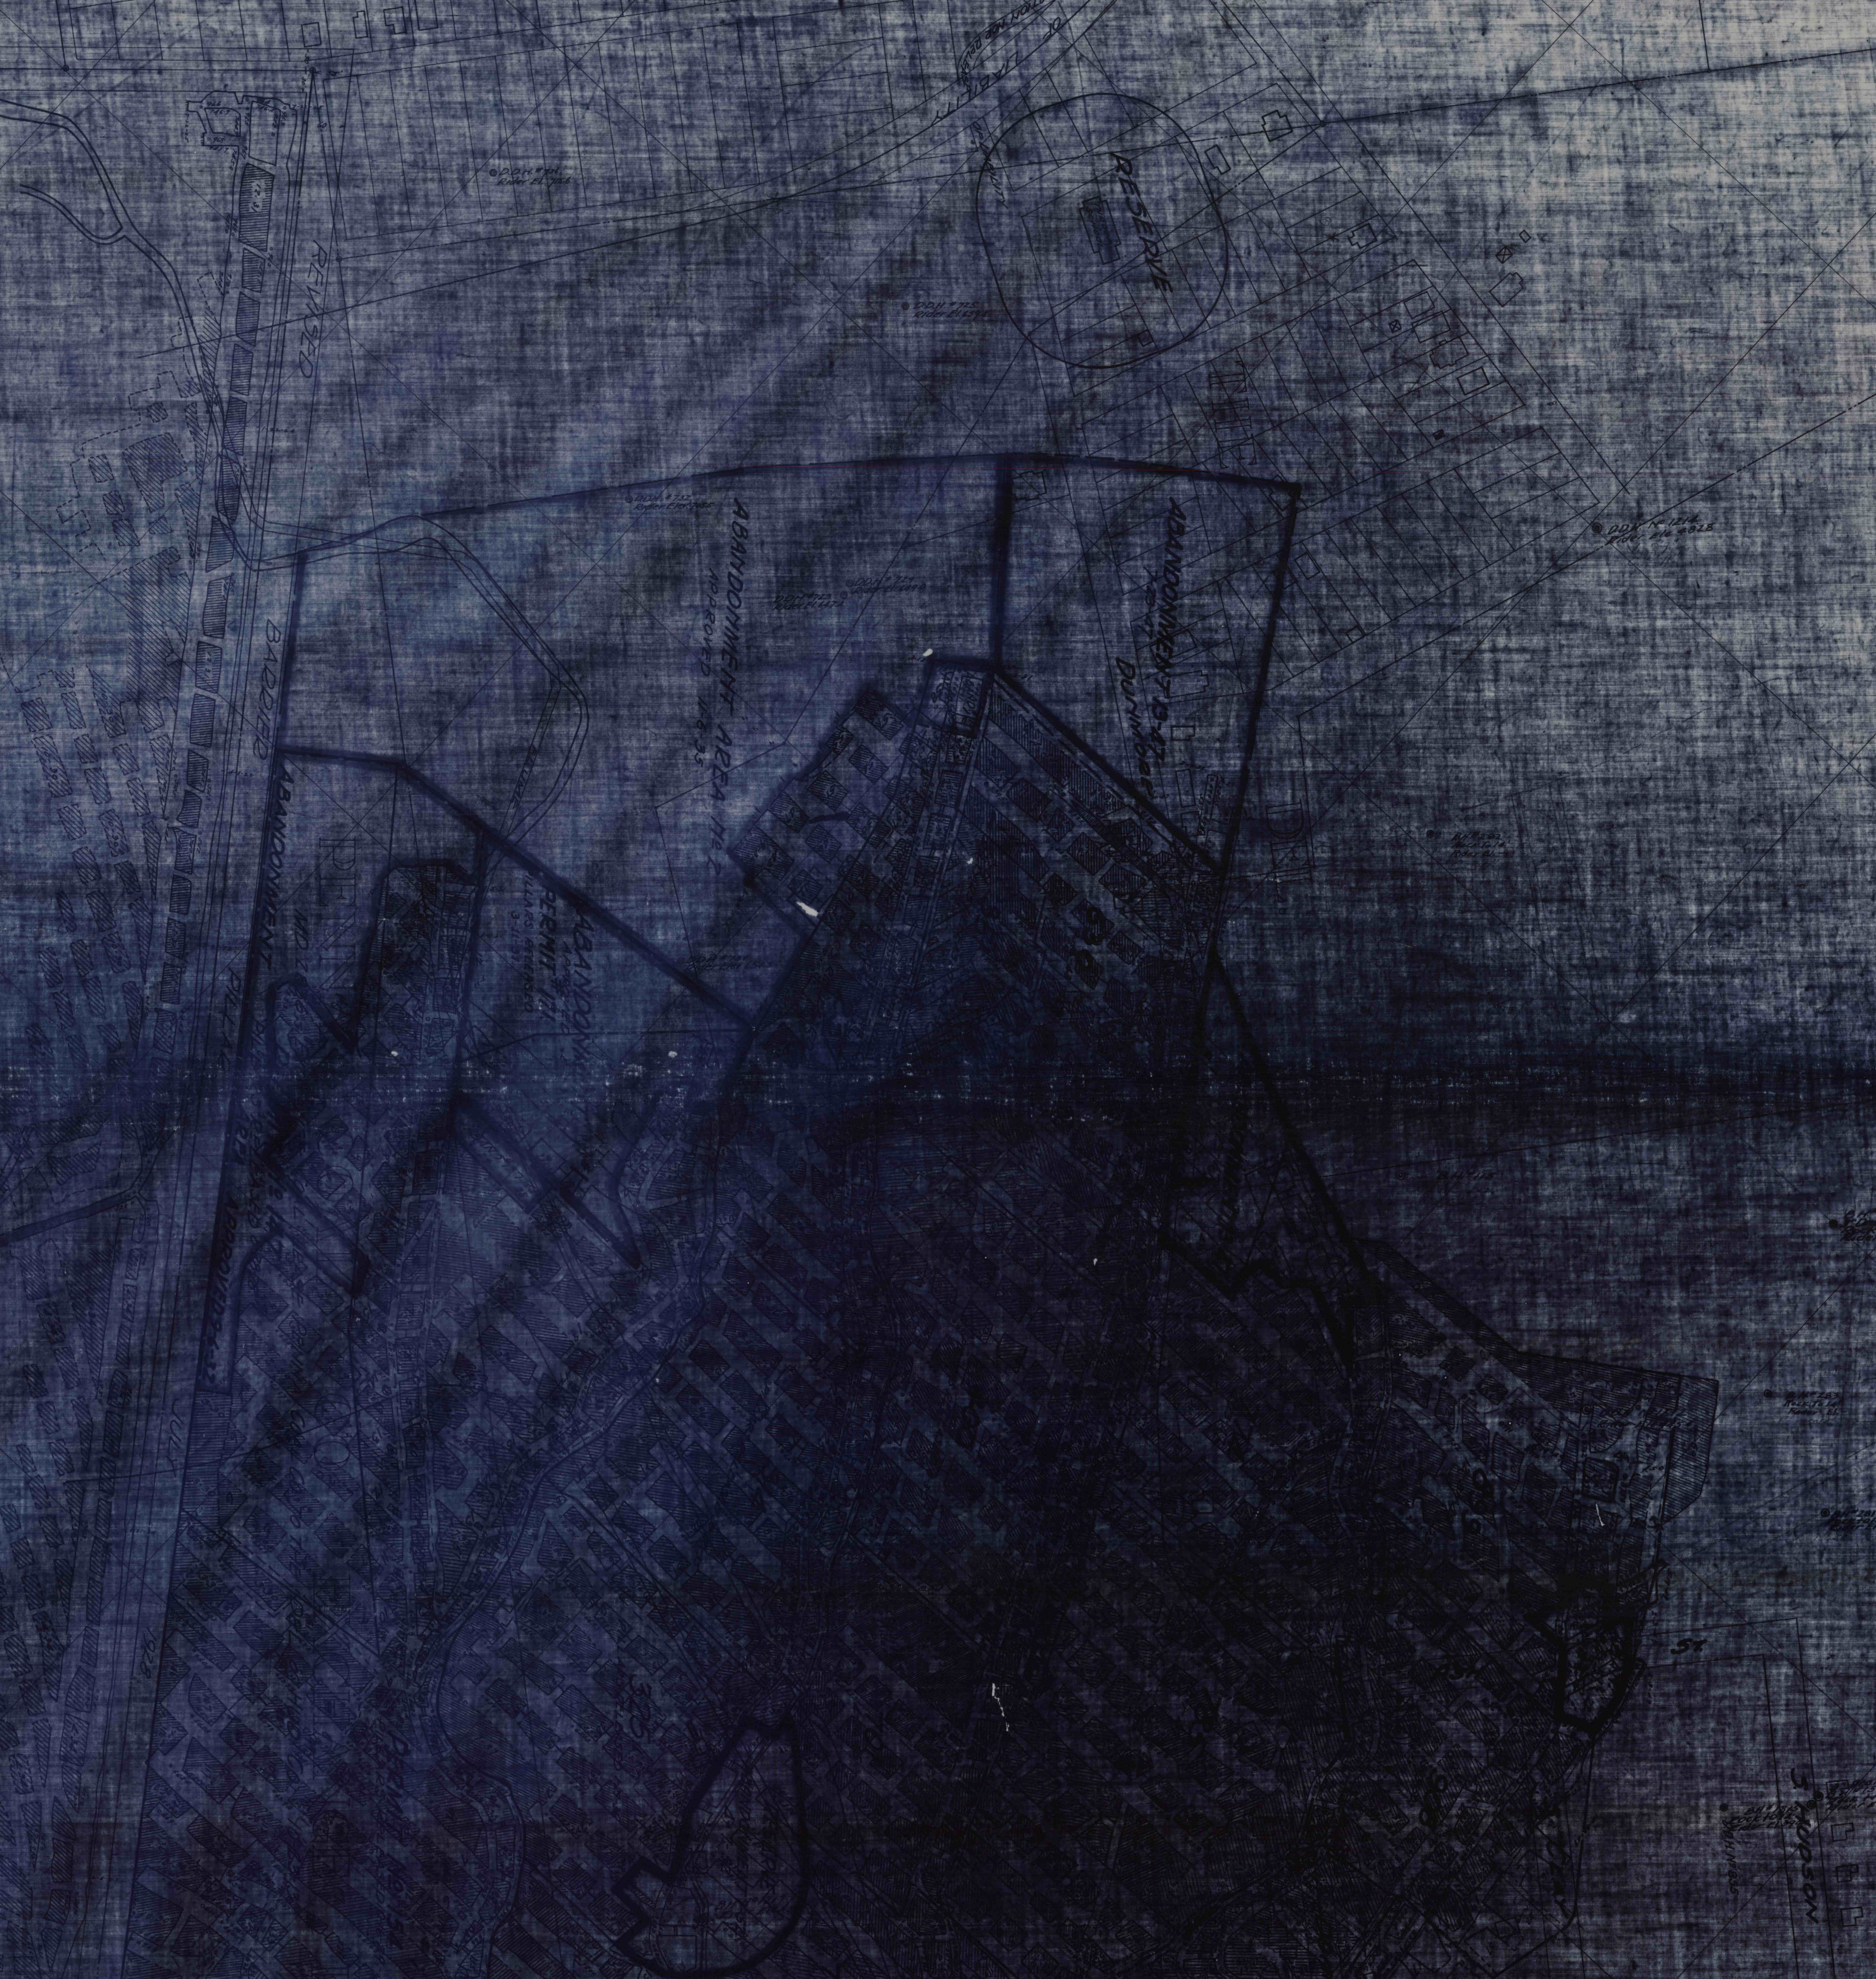


PENNA. COAL CO. EXCHANGE PAR. "A"
MD 2309 - EXCHANGE COAL LEASE PENNA. COAL CO. TO THE DELAWARE CO. 4-11-11

PENNA.

COAL

CO.

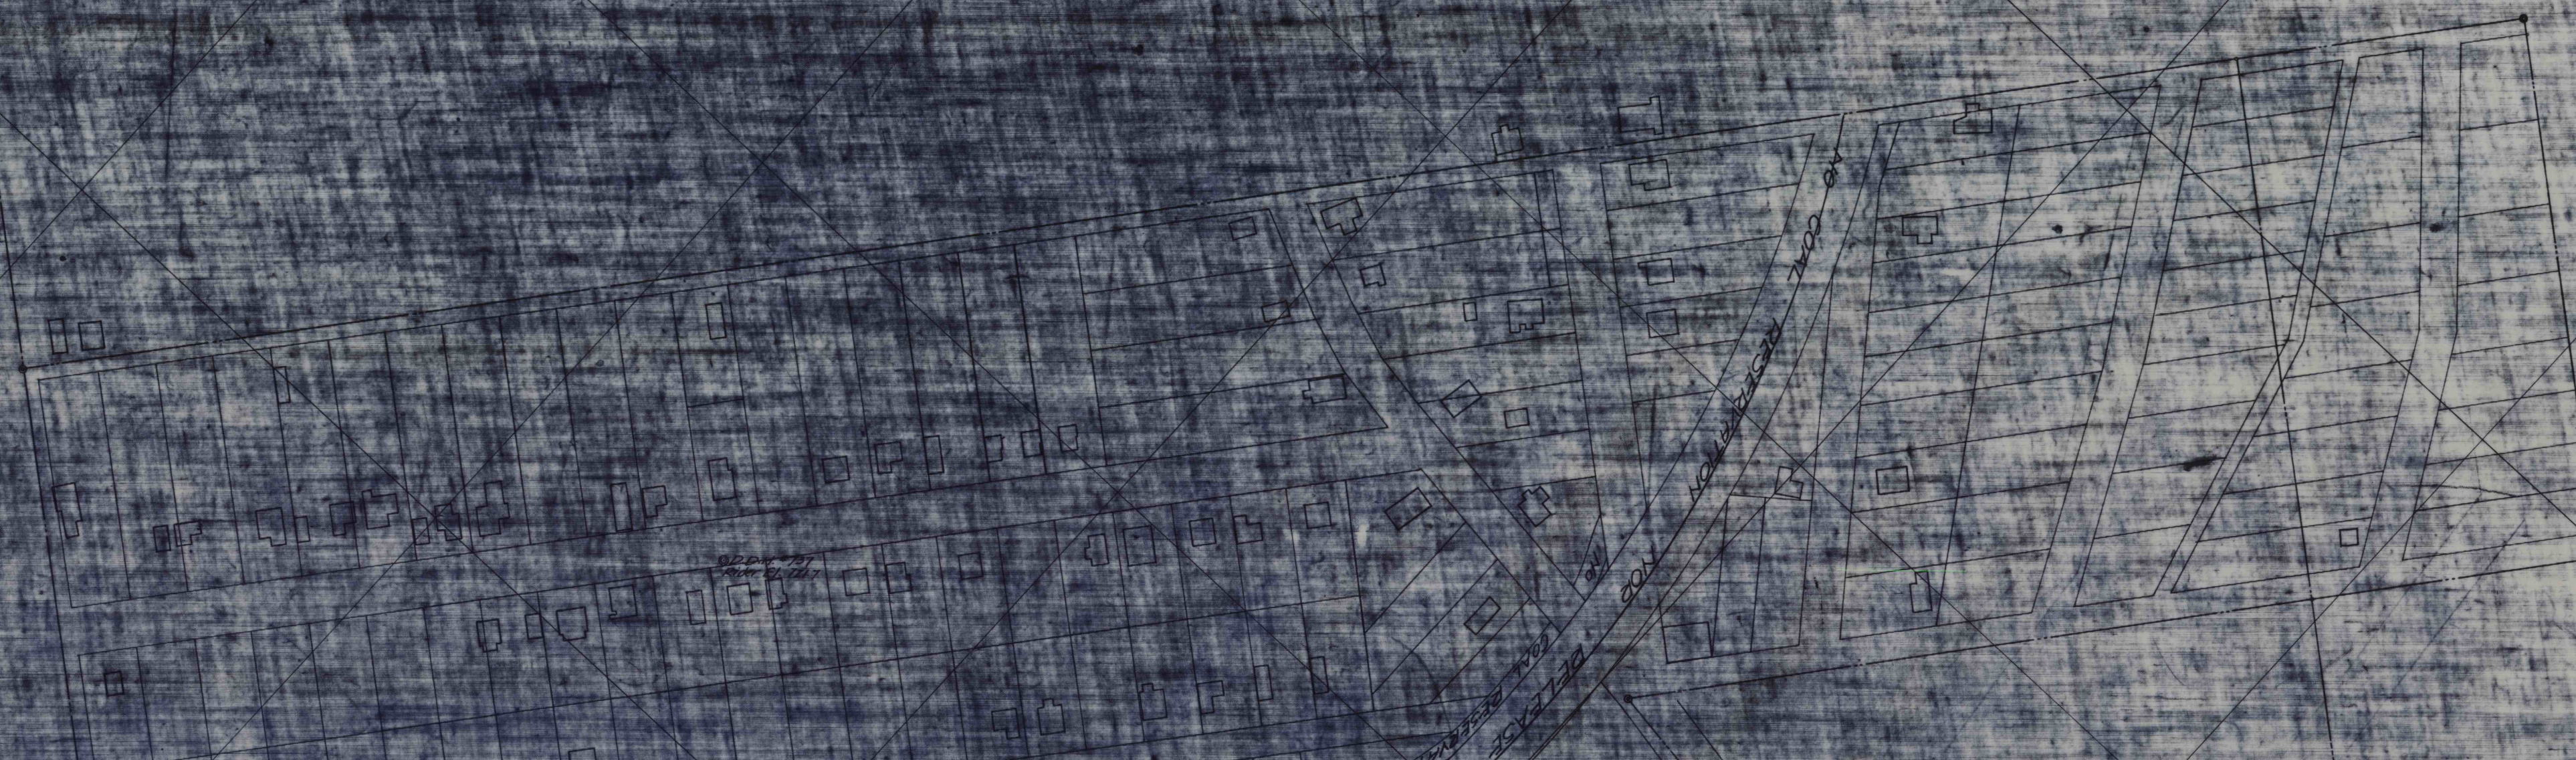

OF RESERVE 2-11-11