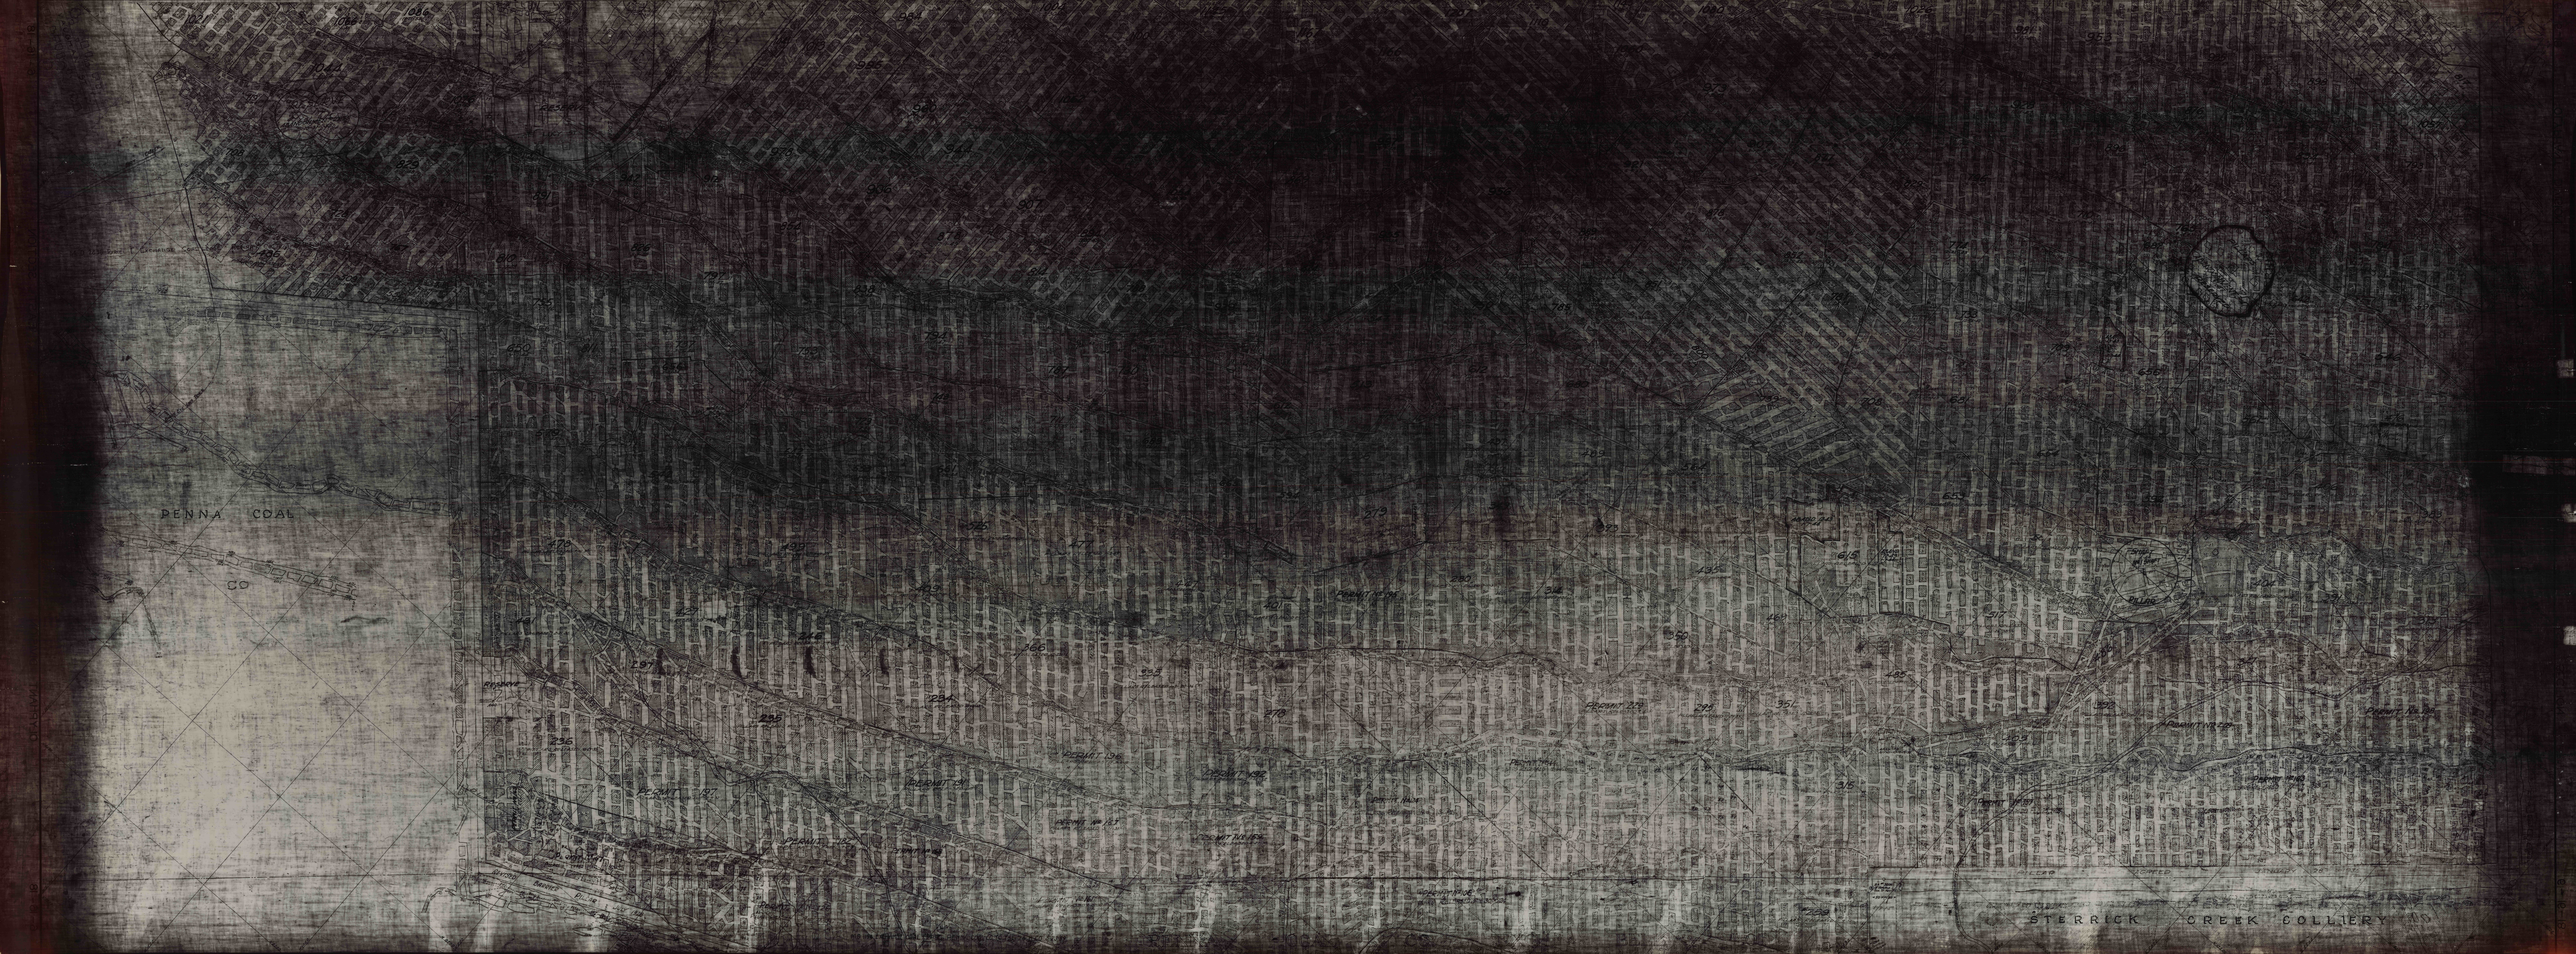

VAUGHAN ST
OLYPHANT
RESERVE
ABANDONMENT PLANS 10-31-44
LUCY ST
RESERVE
M. D. 2838 PARCEL I EXCHANGE COAL LEASE PENNA CO.
JULY 1928
PENNA COAL
CO
RESERVE
PILLAR
REVISED BARRIER PILLAR JULY 1928
PERMIT 197
PERMIT 182
PERMIT No 197
PERMIT No 126
PERMIT 191
PERMIT 196
PERMIT 192
PERMIT No 163
PERMIT No 159
PERMIT No 161
PERMIT No 195
PERMIT No 124
PERMIT 229
PERMIT 194
PERMIT No 108
PERMIT No 209
PERMIT No 198
PERMIT No 183
PERMIT No 157
ABAND 1243 7-7-44
ABAND 12-43 7-7-44
SHAFT
No 1 SHAFT
PILLAR
PILLARS ABANDONMENT RESERVE
COUNTERPANEL
PILLAR AGREED JANUARY 28 1935
STERRICK CREEK COLLIERY
M.D. 1194 EXCHANGE COAL LEASE PENNA COAL CO TO THE D&H CO 3-23-39
PENNA COAL CO
9-16-18
1021
1066
1086
1044
1026
708
829
726
486
503
891
947
912
978
985
906
854
826
810
797
735
838
650
811
737
656
753
579
544
517
723
984
1004
1100
1167
1166
1062
980
944
907
878
894
814
798
969
987
865
965
956
921
973
1060
1090
889
876
851
785
800
794
787
780
748
711
689
661
663
594
279
612
513
680
489
564
343
1026
981
953
925
898
1057
928
896
876
894
793
796
710
763
682
774
733
709
656
681
708
739
852
761
829
877
907
644
696
613
546
567
476
654
653
393
406
383
478
499
431
427
246
297
235
236
526
477
409
447
401
366
335
234
278
280
314
350
435
393
295
615
469
485
351
404
391
313
480
517
392
405
347
315
258