



NOTE:  
BORE HOLE NUMBERS 41, 44, 47, 54, & 73  
COULD NOT BE LOCATED BECAUSE NO CASINGS  
WERE PROVIDED.


NO.	DATE	REVISION	APPR.

DESIGNER  
DISTRICT ENGINEER, WILKES-BARRE  
APPROVED  
DIRECTOR, BUREAU OF ABANDONED MINE RECLAMATION

COMMONWEALTH OF PENNSYLVANIA  
DEPARTMENT OF ENVIRONMENTAL RESOURCES  
OFFICE OF RESOURCES MANAGEMENT

PROJECT NO.  
HYDRAULIC BACKFILLING PROJECT  
OLYPHANT PROJECT AREA  
BOROUGH OF OLYPHANT  
LACKAWANNA COUNTY, PENNSYLVANIA  
OLYPHANT COLLIERY  
4 FOOT BED

DRAWN BY: F.C.S. & A. DATE: 8/9/84 DRAWING NO.: 14 of 20  
CHECKED BY: SCALE: 1 in. = 100 ft.

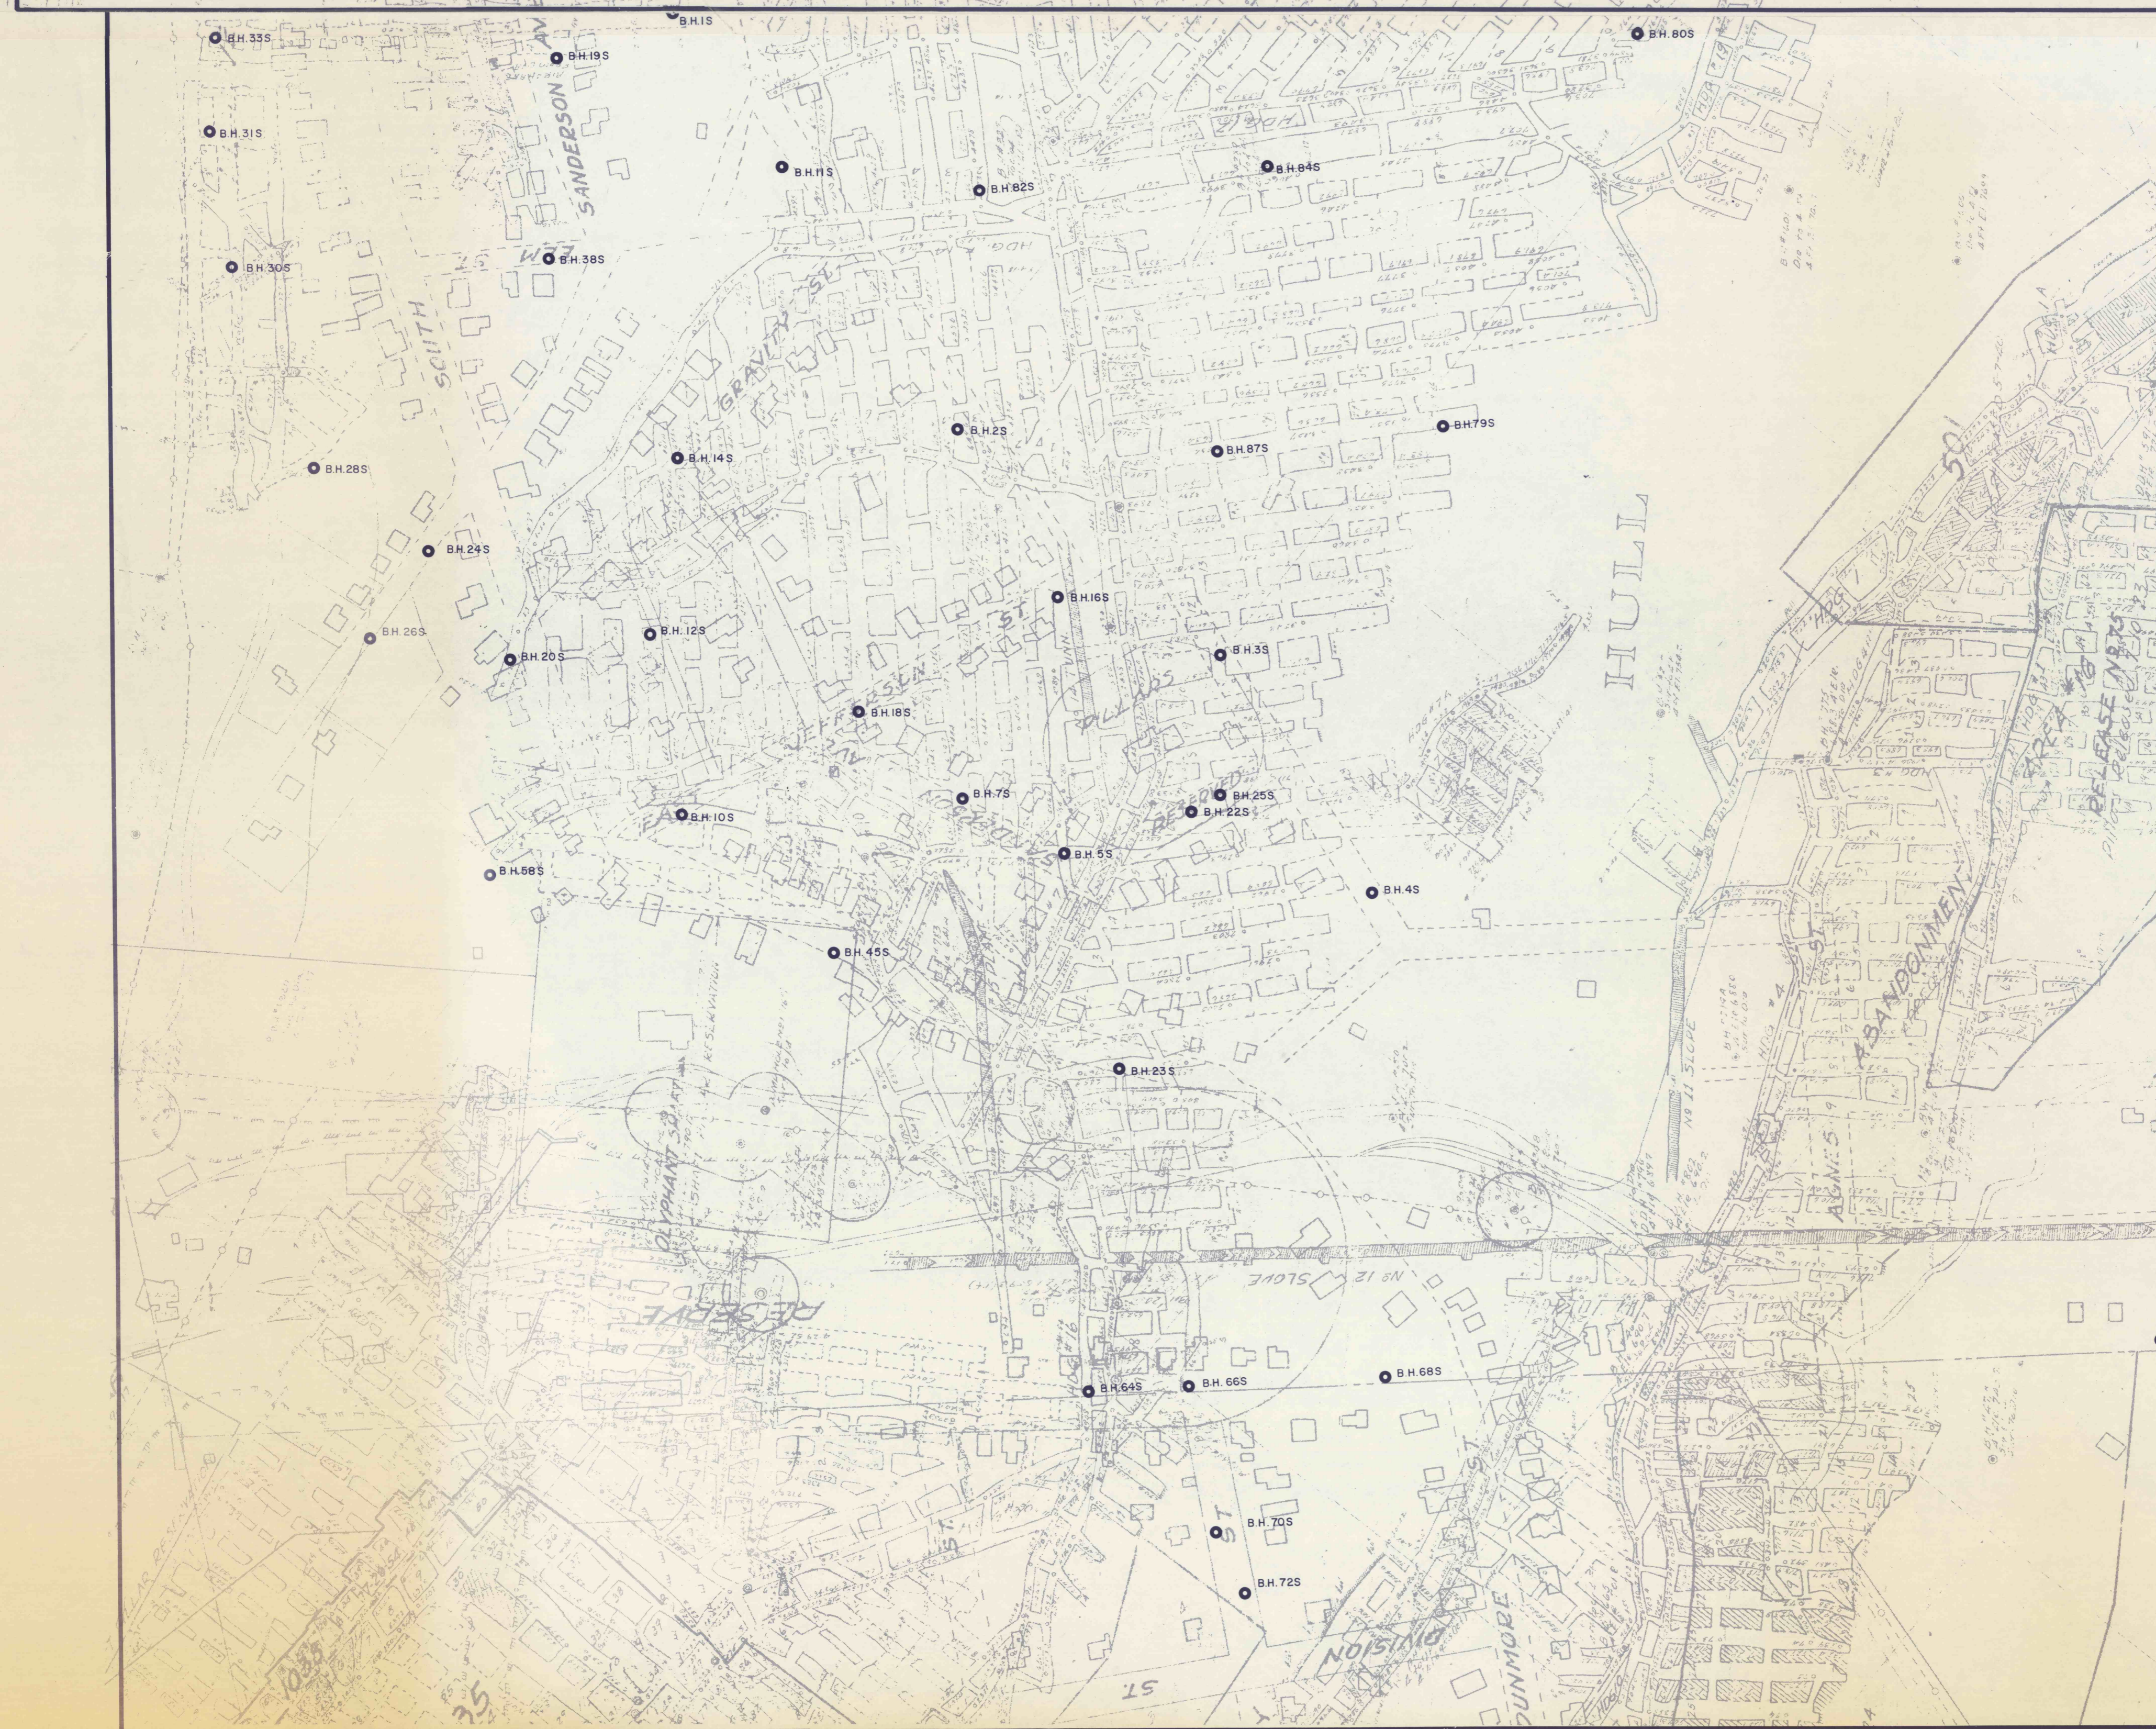

NOTE:  
BORE HOLE NUMBERS 41, 44, 47, 54, & 73  
COULD NOT BE LOCATED BECAUSE NO CASINGS  
WERE PROVIDED.

NO.	DATE	REVISION	APPR.

DESIGNER  
DISTRICT ENGINEER, WILKES-BARRE  
APPROVED  
DIRECTOR, BUREAU OF ABANDONED MINE RECLAMATION

COMMONWEALTH OF PENNSYLVANIA  
DEPARTMENT OF ENVIRONMENTAL RESOURCES  
OFFICE OF RESOURCES MANAGEMENT

PROJECT NO.  
HYDRAULIC BACKFILLING PROJECT  
OLYPHANT PROJECT AREA  
BOROUGH OF OLYPHANT  
LACKAWANNA COUNTY, PENNSYLVANIA  
OLYPHANT COLLIERY  
4 FOOT BED

DRAWN BY: F.C.S. & A. DATE: 8/9/84 DRAWING NO.: 15 of 20  
CHECKED BY: SCALE: 1 in. = 100 ft.