

NOTE:
BORE HOLE NUMBERS 41, 44, 47, 54 & 73
COULD NOT BE LOCATED BECAUSE NO CASINGS
WERE PROVIDED.


NO.	DATE	REVISION	APPR.
SUBMITTED			
DESIGNER			
APPROVED			
DISTRICT ENGINEER, WILKES-BARRE			
APPROVED			
DIRECTOR, BUREAU OF ABANDONED MINE RECLAMATION			

COMMONWEALTH OF PENNSYLVANIA
DEPARTMENT OF ENVIRONMENTAL RESOURCES
OFFICE OF RESOURCES MANAGEMENT

PROJECT NO.
HYDRAULIC BACKFILLING PROJECT
OLYPHANT PROJECT AREA
BOROUGH OF OLYPHANT
LACKAWANNA COUNTY, PENNSYLVANIA

OLYPHANT COLLIERY
ROCK BED

DRAWN BY	DATE	DRAWING NO.
F.C.S. & A.	8/9/84	18 of 20
CHECKED BY	SCALE	1 in. = 100 ft.

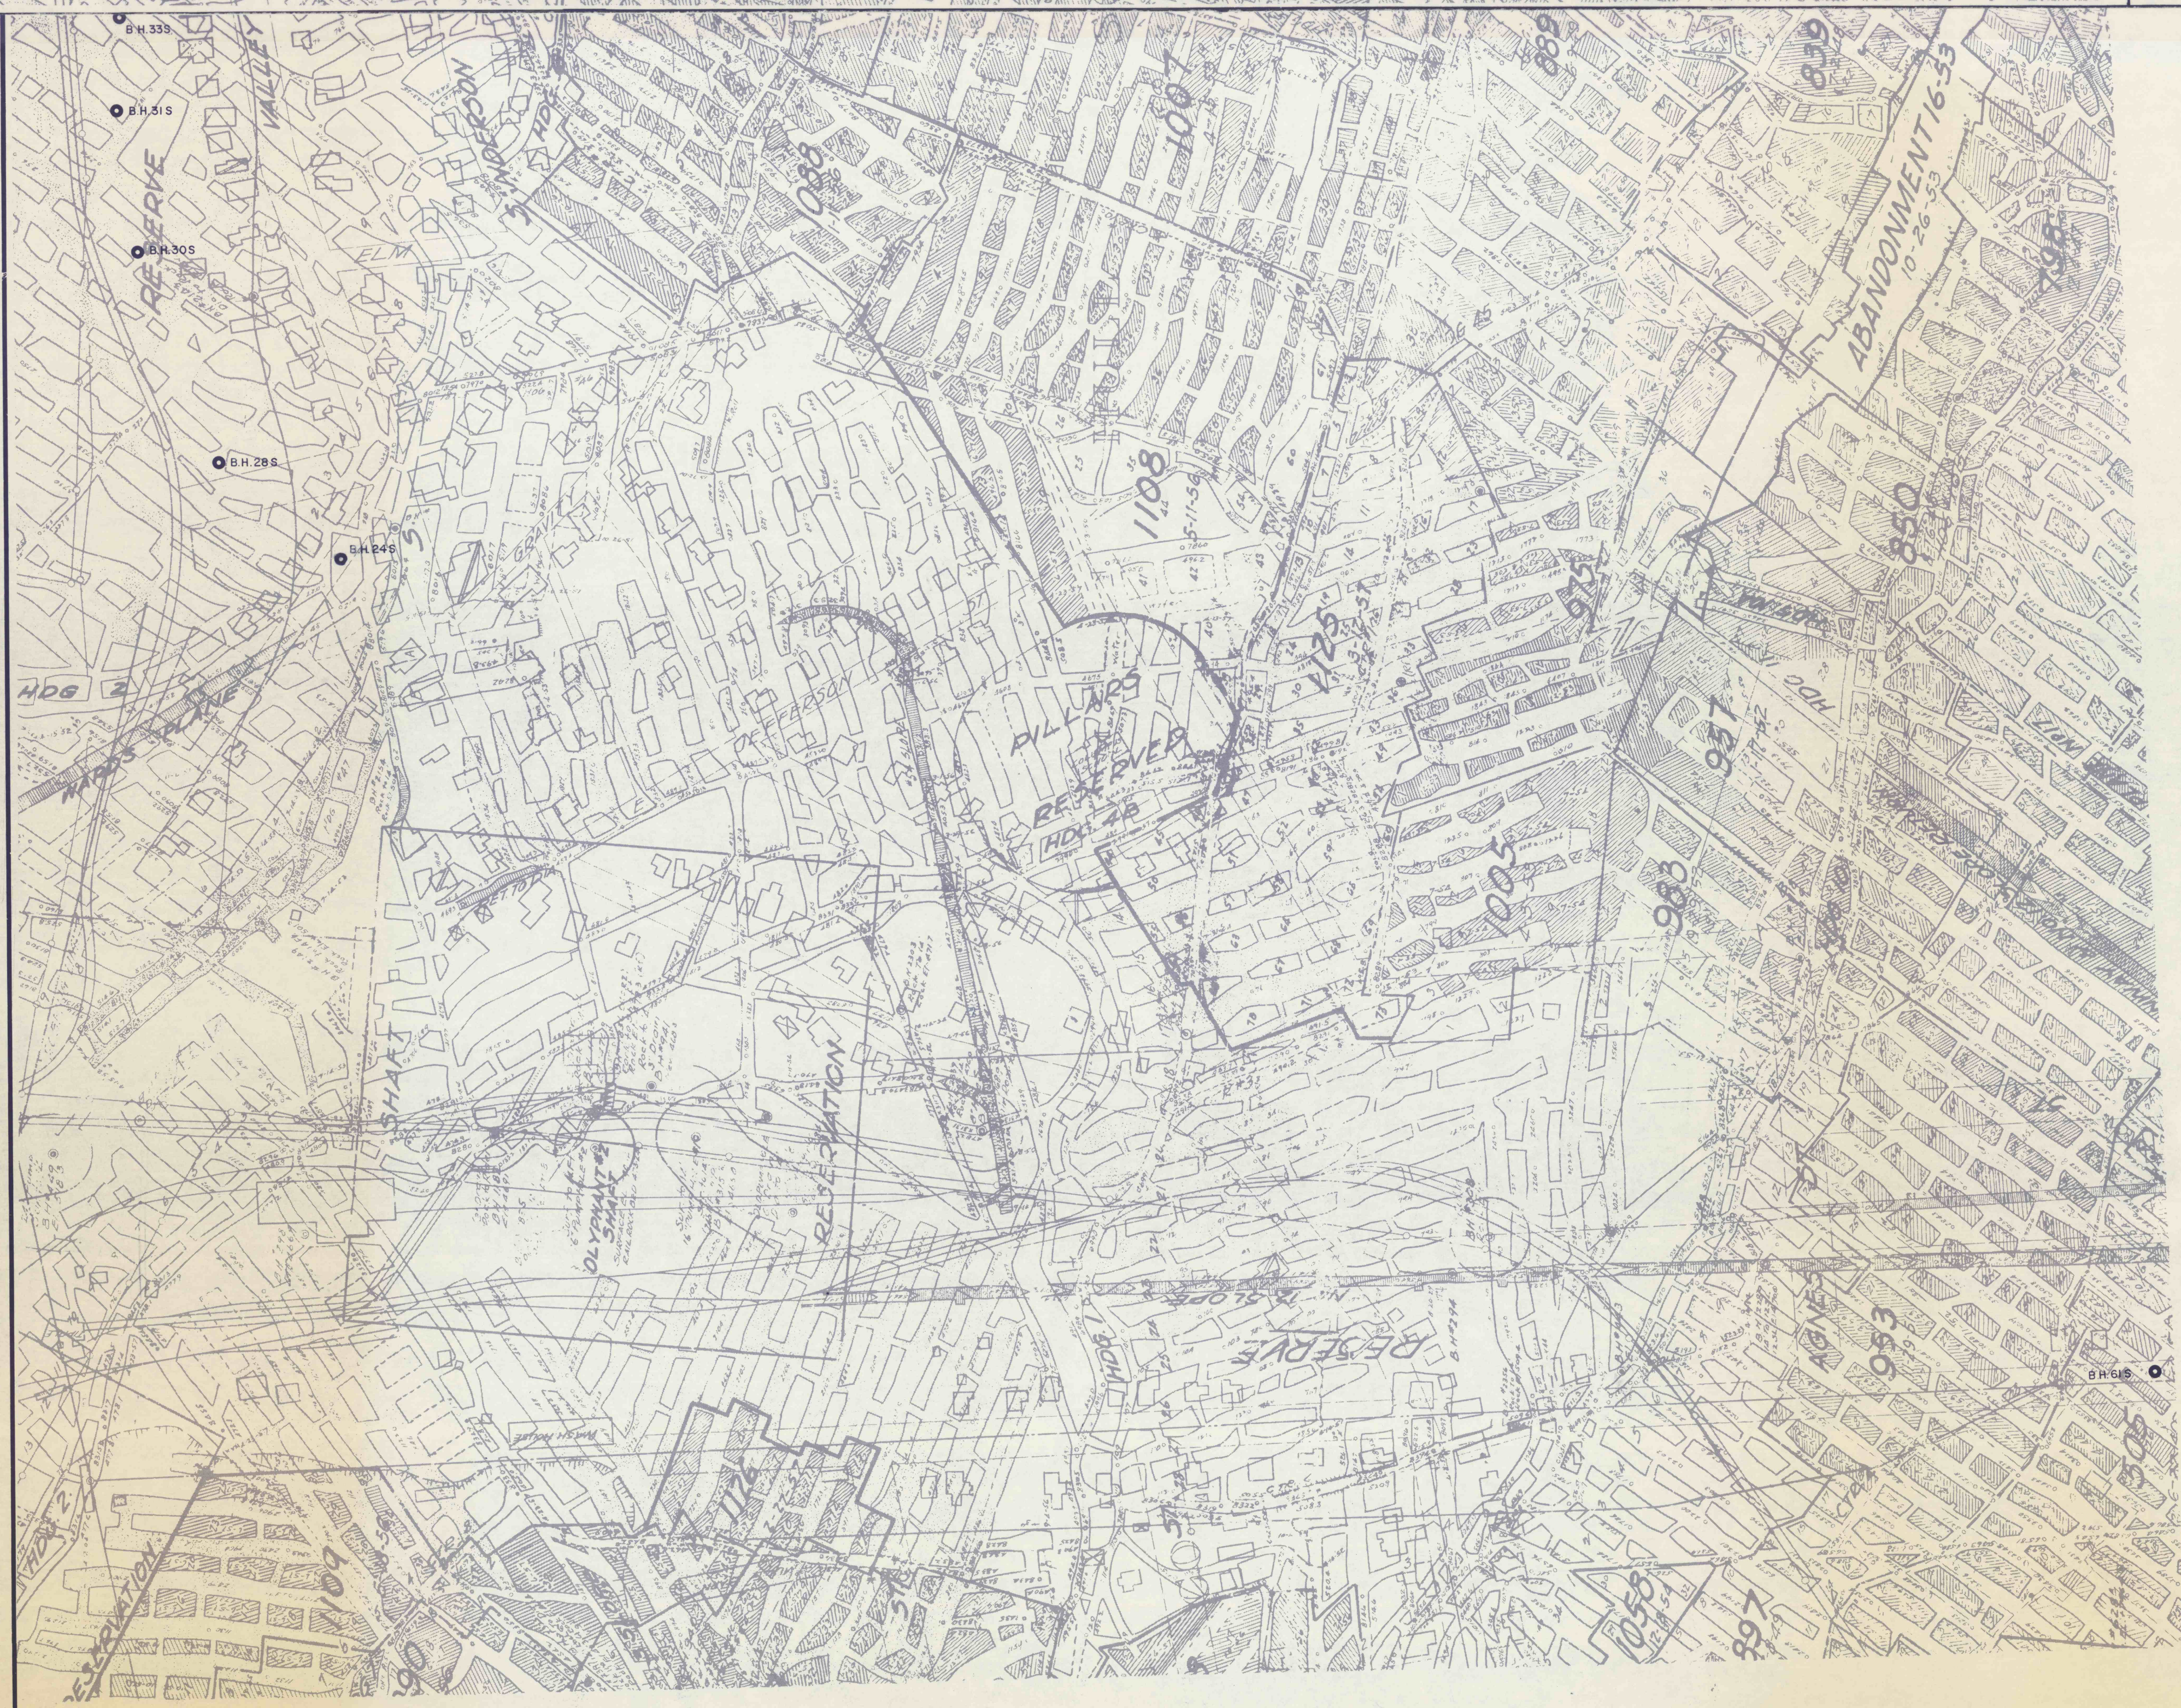

NOTE:
BORE HOLE NUMBERS 41, 44, 47, 54 & 73
COULD NOT BE LOCATED BECAUSE NO CASINGS
WERE PROVIDED.

NO.	DATE	REVISION	APPR.
SUBMITTED			
DESIGNER			
APPROVED			
DISTRICT ENGINEER, WILKES-BARRE			
APPROVED			
DIRECTOR, BUREAU OF ABANDONED MINE RECLAMATION			

COMMONWEALTH OF PENNSYLVANIA
DEPARTMENT OF ENVIRONMENTAL RESOURCES
OFFICE OF RESOURCES MANAGEMENT

PROJECT NO.
HYDRAULIC BACKFILLING PROJECT
OLYPHANT PROJECT AREA
BOROUGH OF OLYPHANT
LACKAWANNA COUNTY, PENNSYLVANIA

OLYPHANT COLLIERY
ROCK BED

DRAWN BY	DATE	DRAWING NO.
F.C.S. & A.	8/9/84	19 of 20
CHECKED BY	SCALE	1 in. = 100 ft.