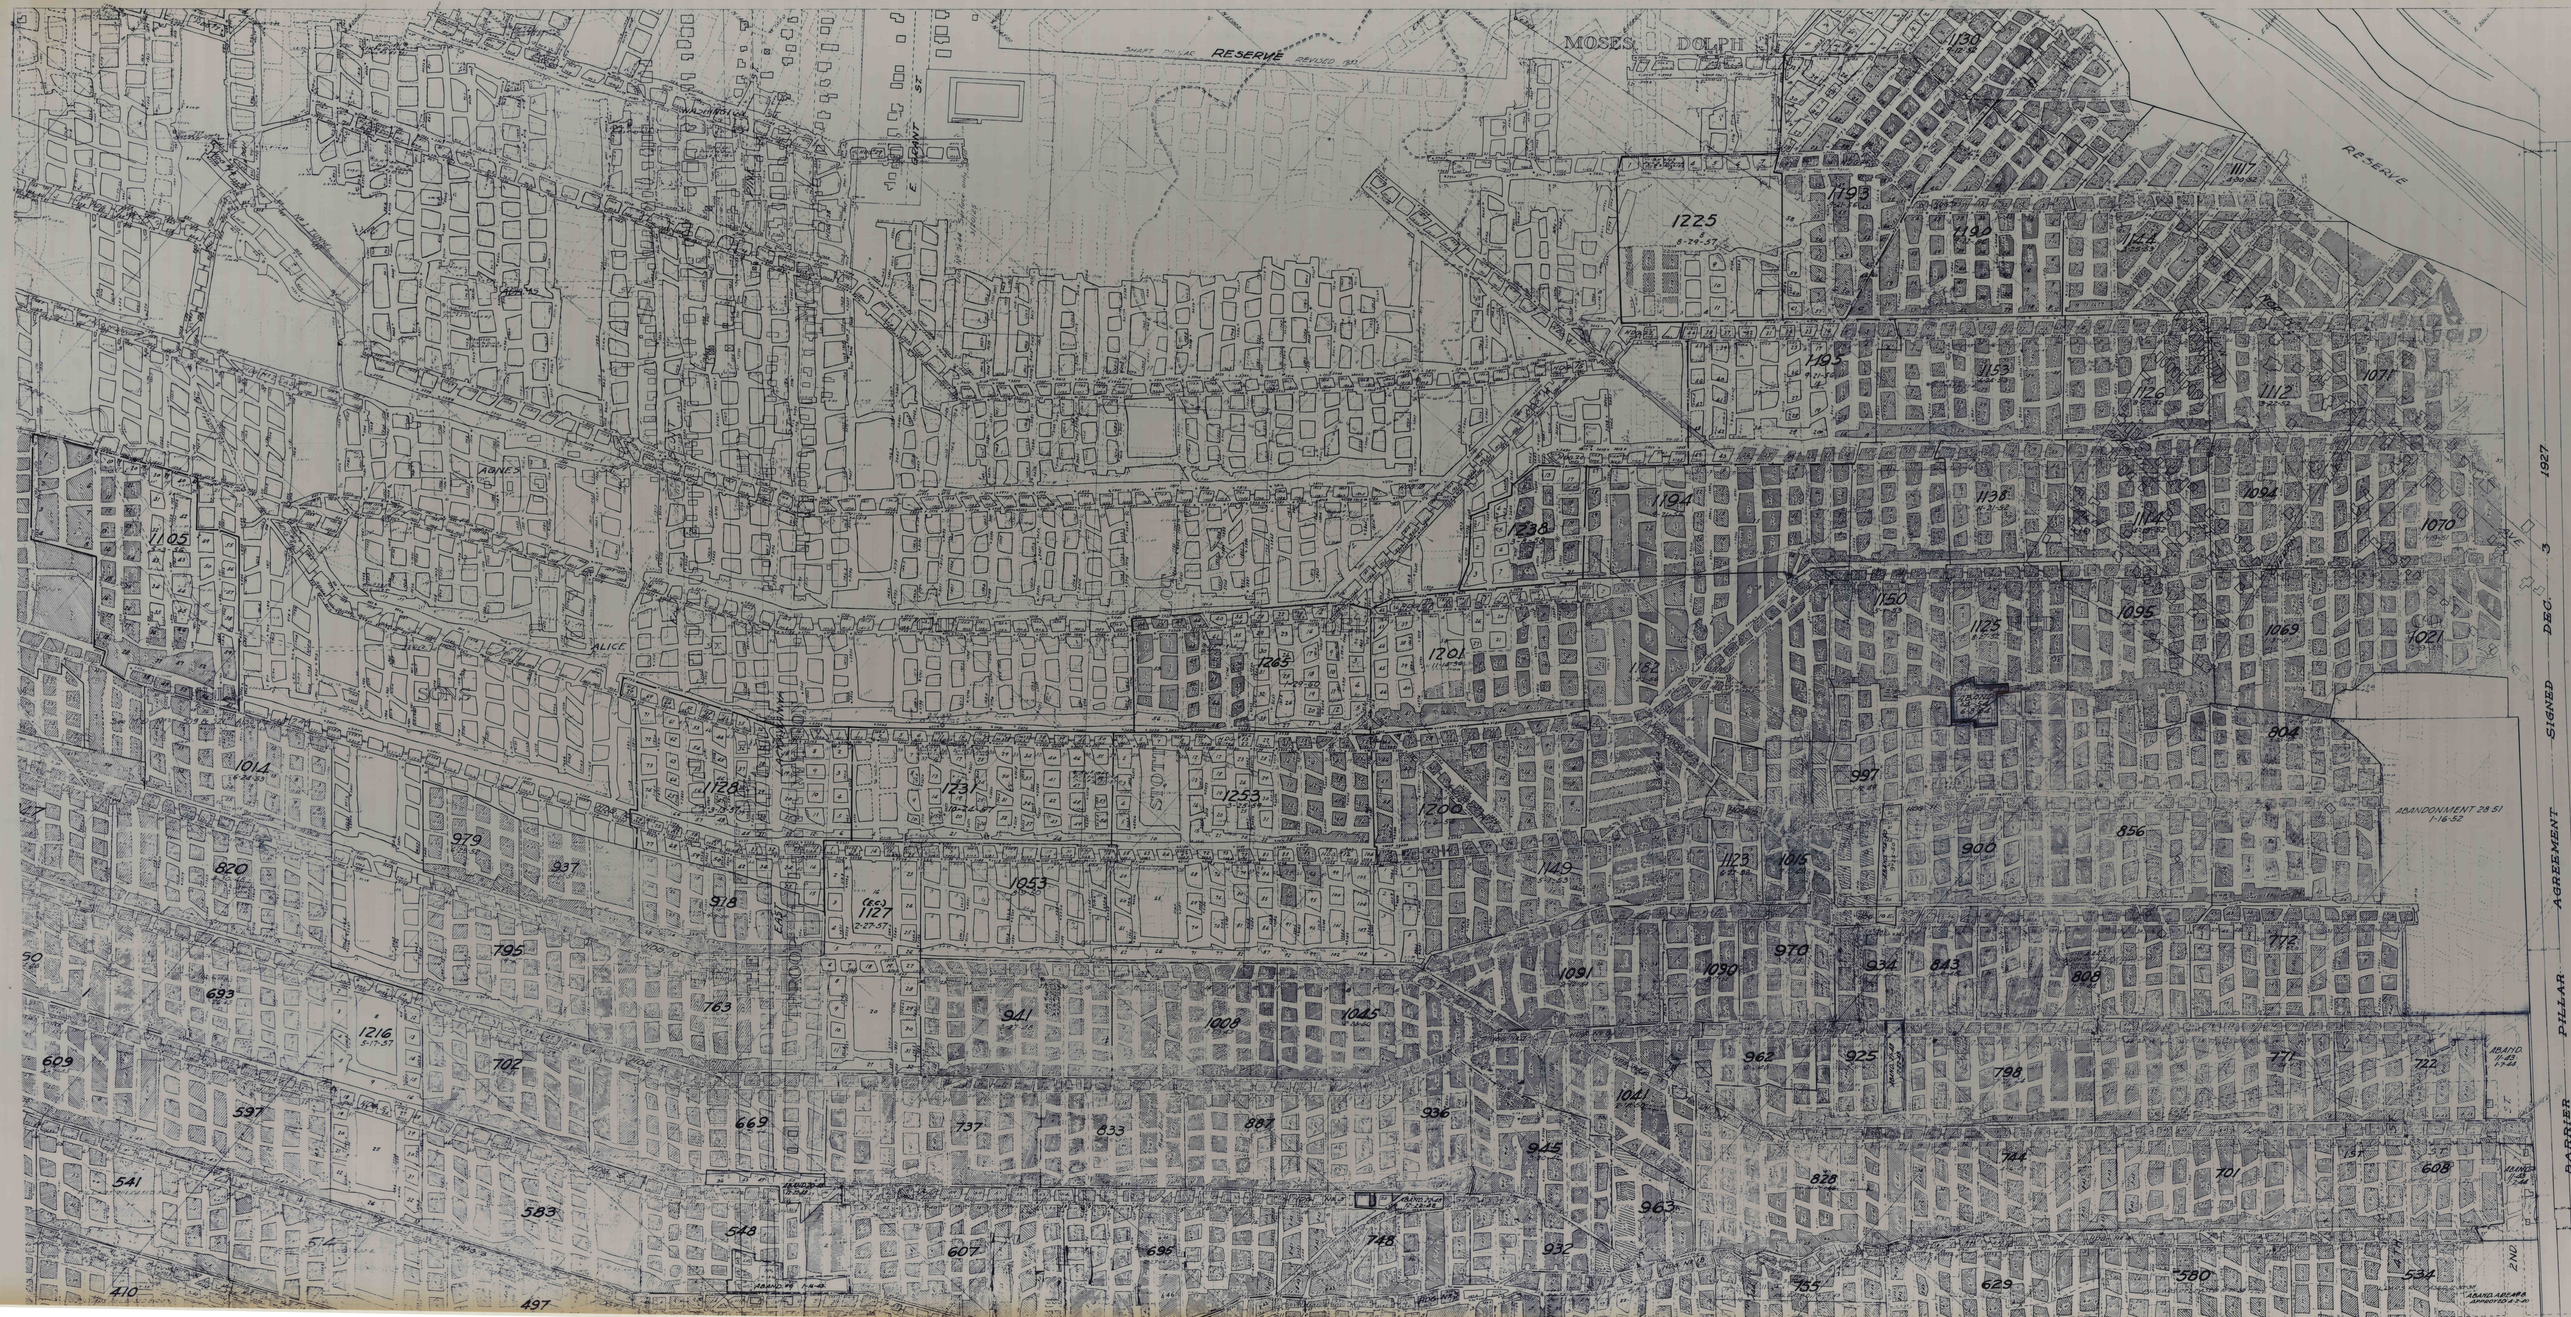

MOSES
DOLPH
SHAFT PILLAR RESERVE REVISED 1933
RESERVE
E. GRANT ST.
WASHINGTON ST.
PINE ST.
ADAMS
AGNES
ALICE
SONS
STOTT
LACKAWANNA
EAST
No 1 TUNNEL
No 8 TUNNEL
No 3644 Surface only 3/20/25
See M.D. Nos 509 & 521 A330 NF244
1225 8-29-57
1130 9-12-52
1117 4-30-52
1193 9-21-56
1190 9-12-52
1144 3-25-53
1195 9-21-56
1153 6-24-53
1126 8-27-52
1112 3-22-52
1071
1105 5-3-56
1238 3-8-58
1194 9-21-56
1138 11-21-52
1114 12-19-52
1094
1070 1-19-51
1150 5-7-53
1125 8-27-52
1095
1069
1021
1201 11-14-56
1265 1-29-60
1182 3-22-54
ABAND. 34-54 6-8-54
804
1014 6-24-53
1128 3-13-57
1231 10-24-57
1253 3-25-59
1200 11-6-56
997 1-12-49
979 6-25-52
820 8-30-46
937
918
(E.C.) 1127 2-27-57
1053
1149 5-7-53
1123 6-27-52
1015
ABAND. 9-25-50
900
856
ABANDONMENT 28.51 1-16-52
795
HDG. 10
1091
1090
970
934
843 10-9-45
808
772
693
763
1216 5-17-57
941
1008
1045
962
925
ABAND. 12-22-48
798
771
722
ABAND. 11-43 1-7-44
609
702
HDG. 7
597
669
737
833
887
936
1041
945
828
744
701
608
ABAND. 11-43 1-7-44
541
HDG. 4
583
548
ABAND. 20-48 12-22-48
ABAND. 22-48 12-22-48
HDG. No 5
963
514
HDG. 3
607
695
748
932
HDG. No 18
755
629
580
534
410
497
646
658
ABAND #9 1-16-43
PILLARS RELEASED 10-15-39
PILLARS RELEASED 11-30-38
ABAND. AREA #8 APPROVED 4-2-40
GALLAGHER
1ST ST.
2ND
3RD ST.
4TH
AVE
BARRIER PILLAR AGREEMENT SIGNED DEC. 3 1927