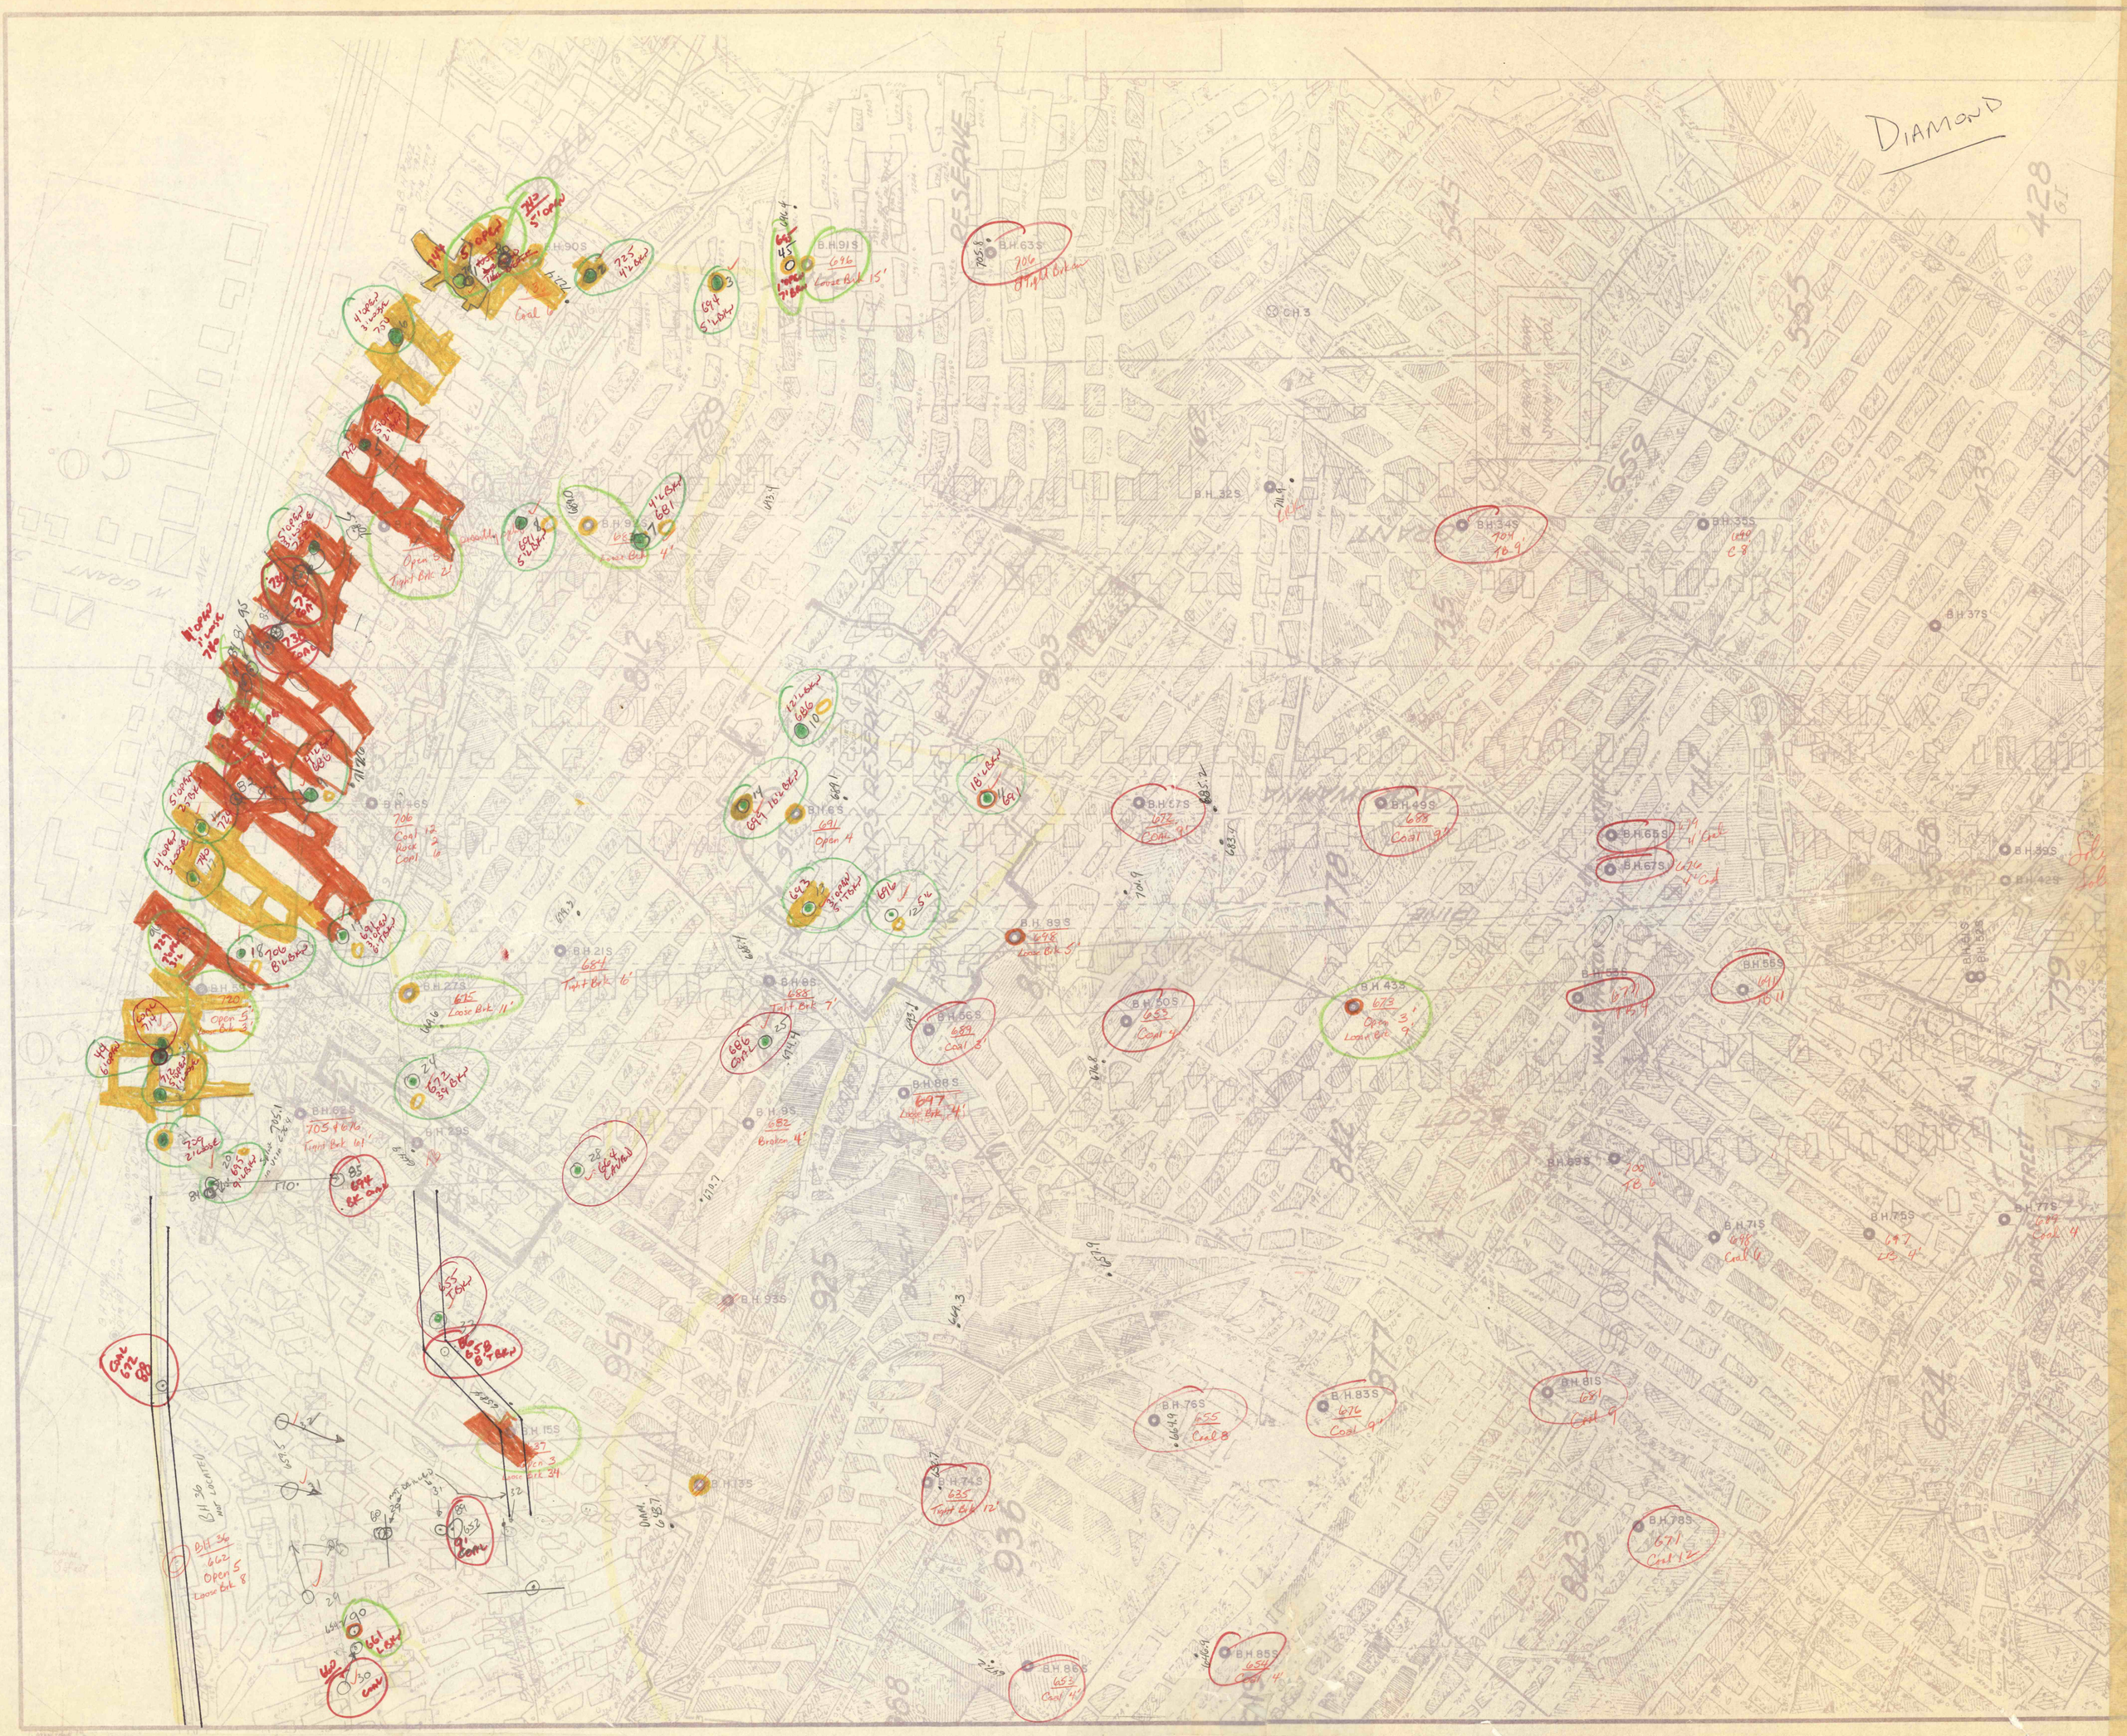
DIAMOND
RESERVE
W GRANT
B.H.90S
B.H.91S
B.H.63S
B.H.32S
B.H.34S
B.H.35S
B.H.37S
B.H.46S
B.H.6S
B.H.57S
B.H.49S
B.H.65S
B.H.67S
B.H.39S
B.H.42S
B.H.89S
B.H.21S
B.H.8S
B.H.27S
B.H.56S
B.H.50S
B.H.43S
B.H.53S
B.H.55S
B.H.88S
B.H.9S
B.H.62S
B.H.29S
B.H.69S
B.H.71S
B.H.75S
B.H.77S
B.H.93S
B.H.15S
B.H.13S
B.H.76S
B.H.83S
B.H.81S
B.H.74S
B.H.78S
B.H.86S
B.H.85S
BH 36 NOT LOCATED
BH 36 662 Open 5 Loose Brk 8
ADAMS STREET