


TOP-ROCK BED  
CAPOUSE COLLIERY  
SCALE 1"=100'

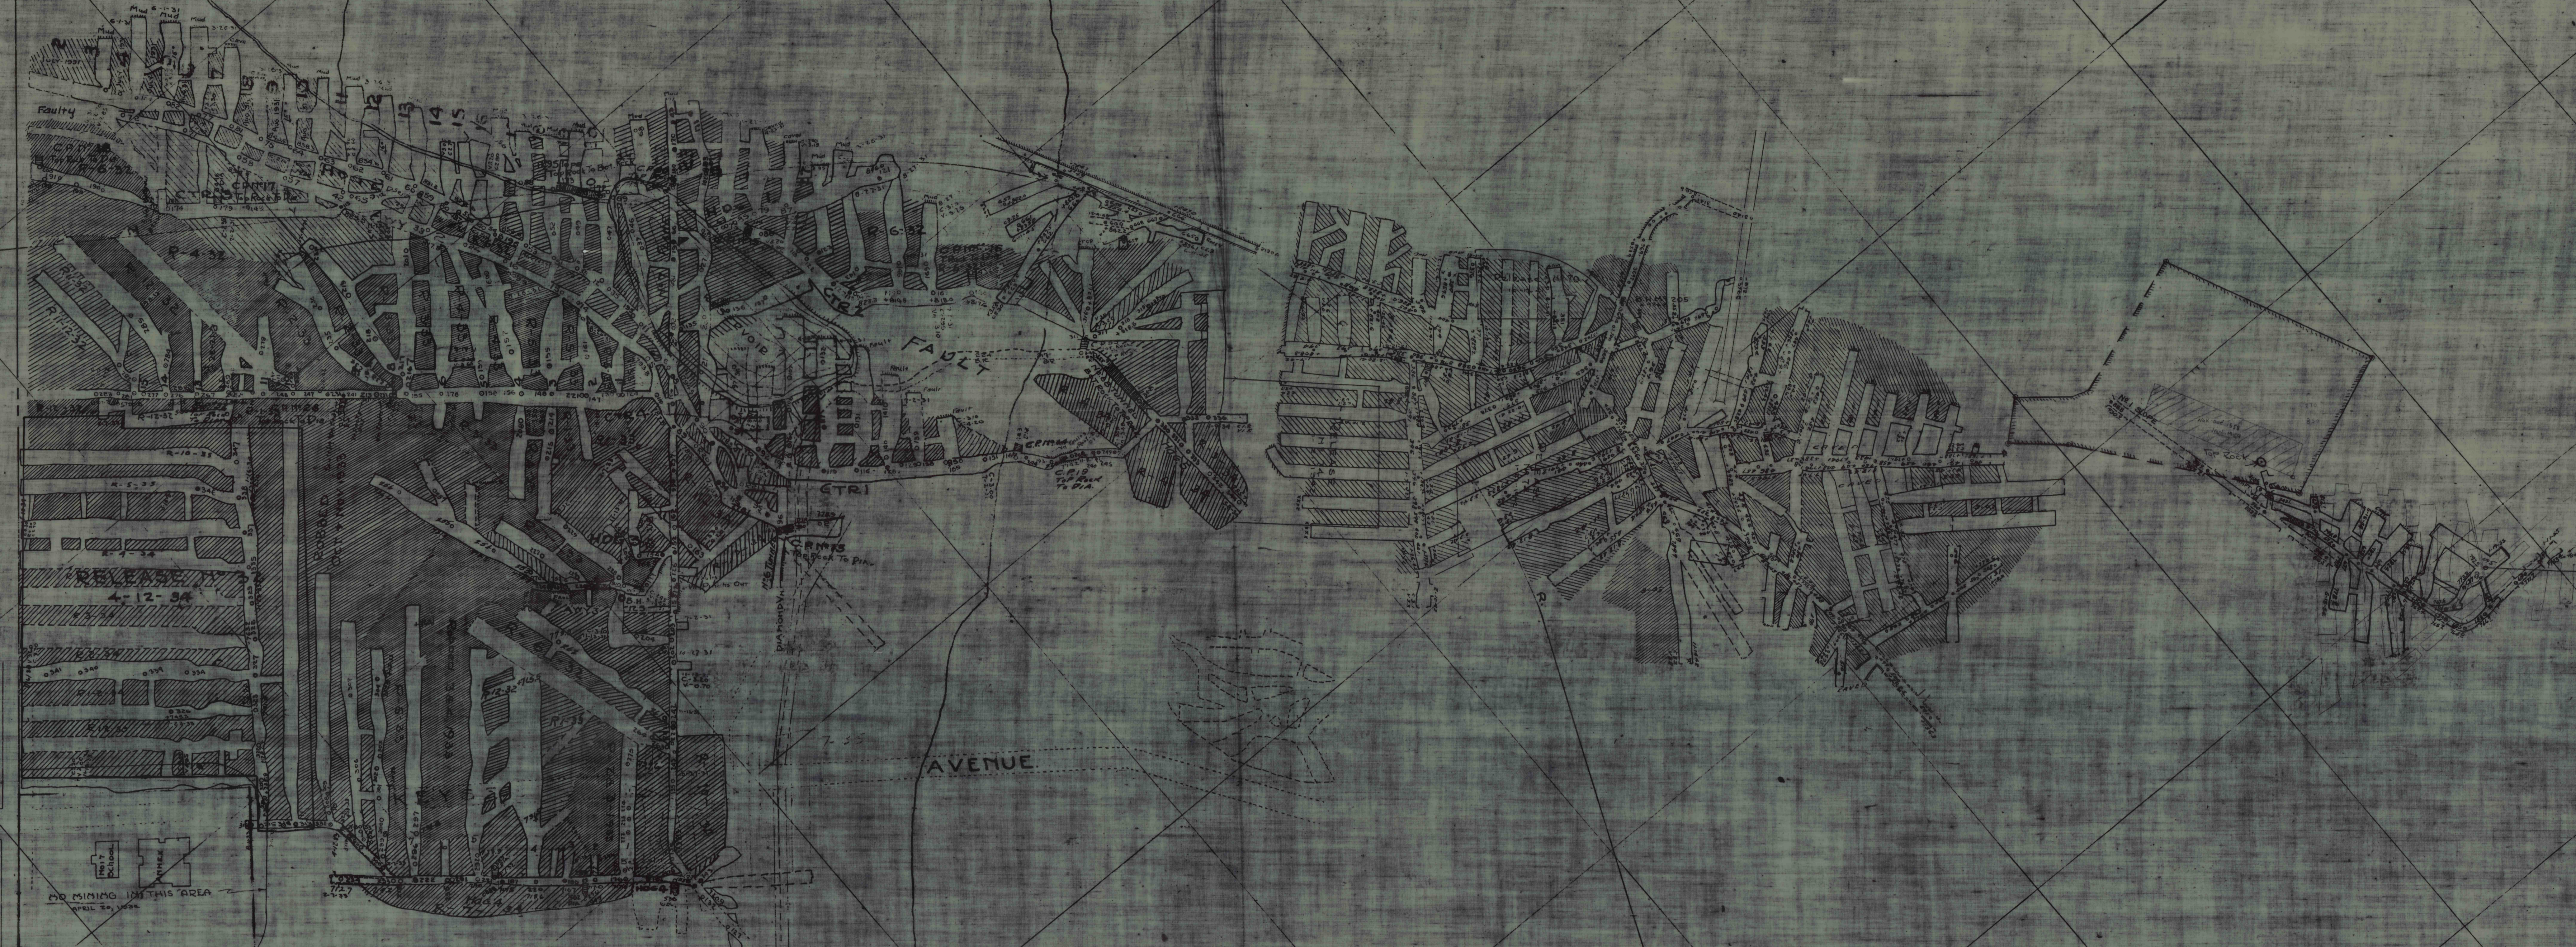

DO NOT MINE IN THIS AREA

182 SHAF

181 SHAF

TOP-ROCK BED  
CAPOUSE COLLIERY  
SCALE 1"=100'