

MAP of the Middle New County Vein


Ontario Riverside & Raymond Collieries

Scranton Coal Company

Peckville Pa.

Scale 400' = 1"

Lower End of Top New County

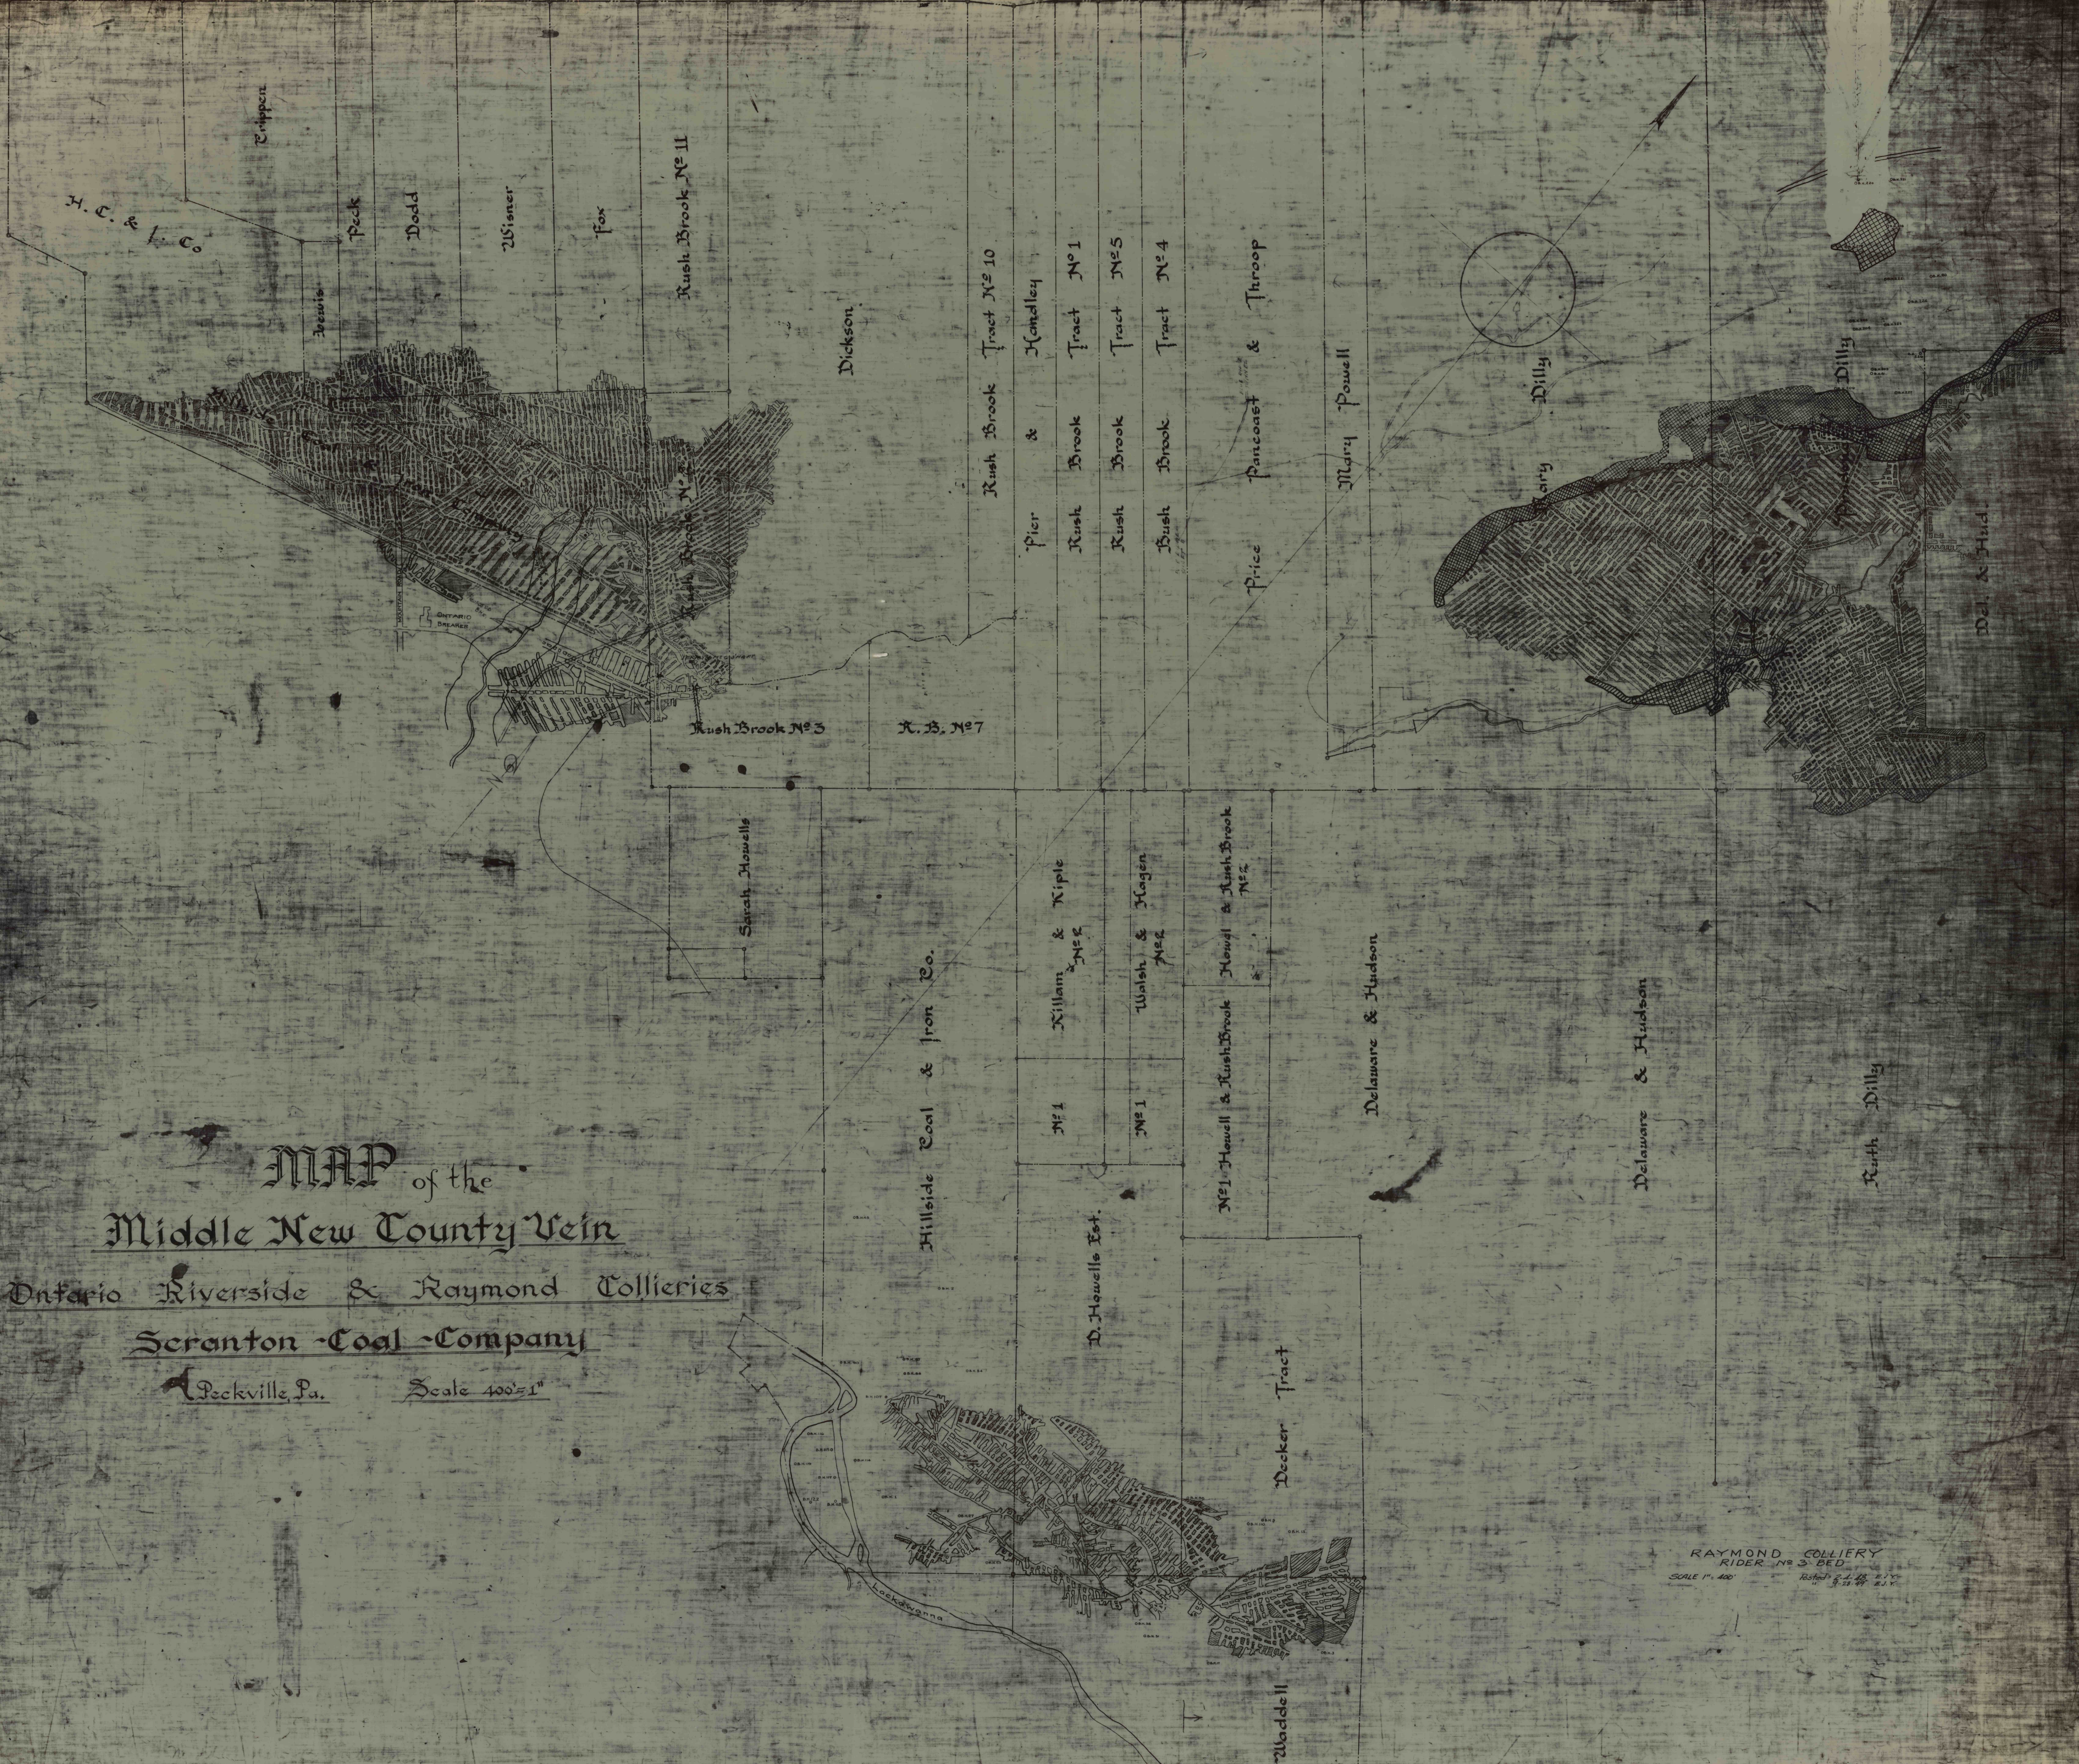

RAYMOND COLLIERY
RIDER NO 3 BED
SCALE 1" = 400'
Plotted & L. B. E. V.
9-22-29 E. J. V.