


MAP of the
Top New County Vein
 Ontario Riverside & Raymond Collieries
 Scranton Coal Company
 Peckville, Pa. Scale 400' = 1"

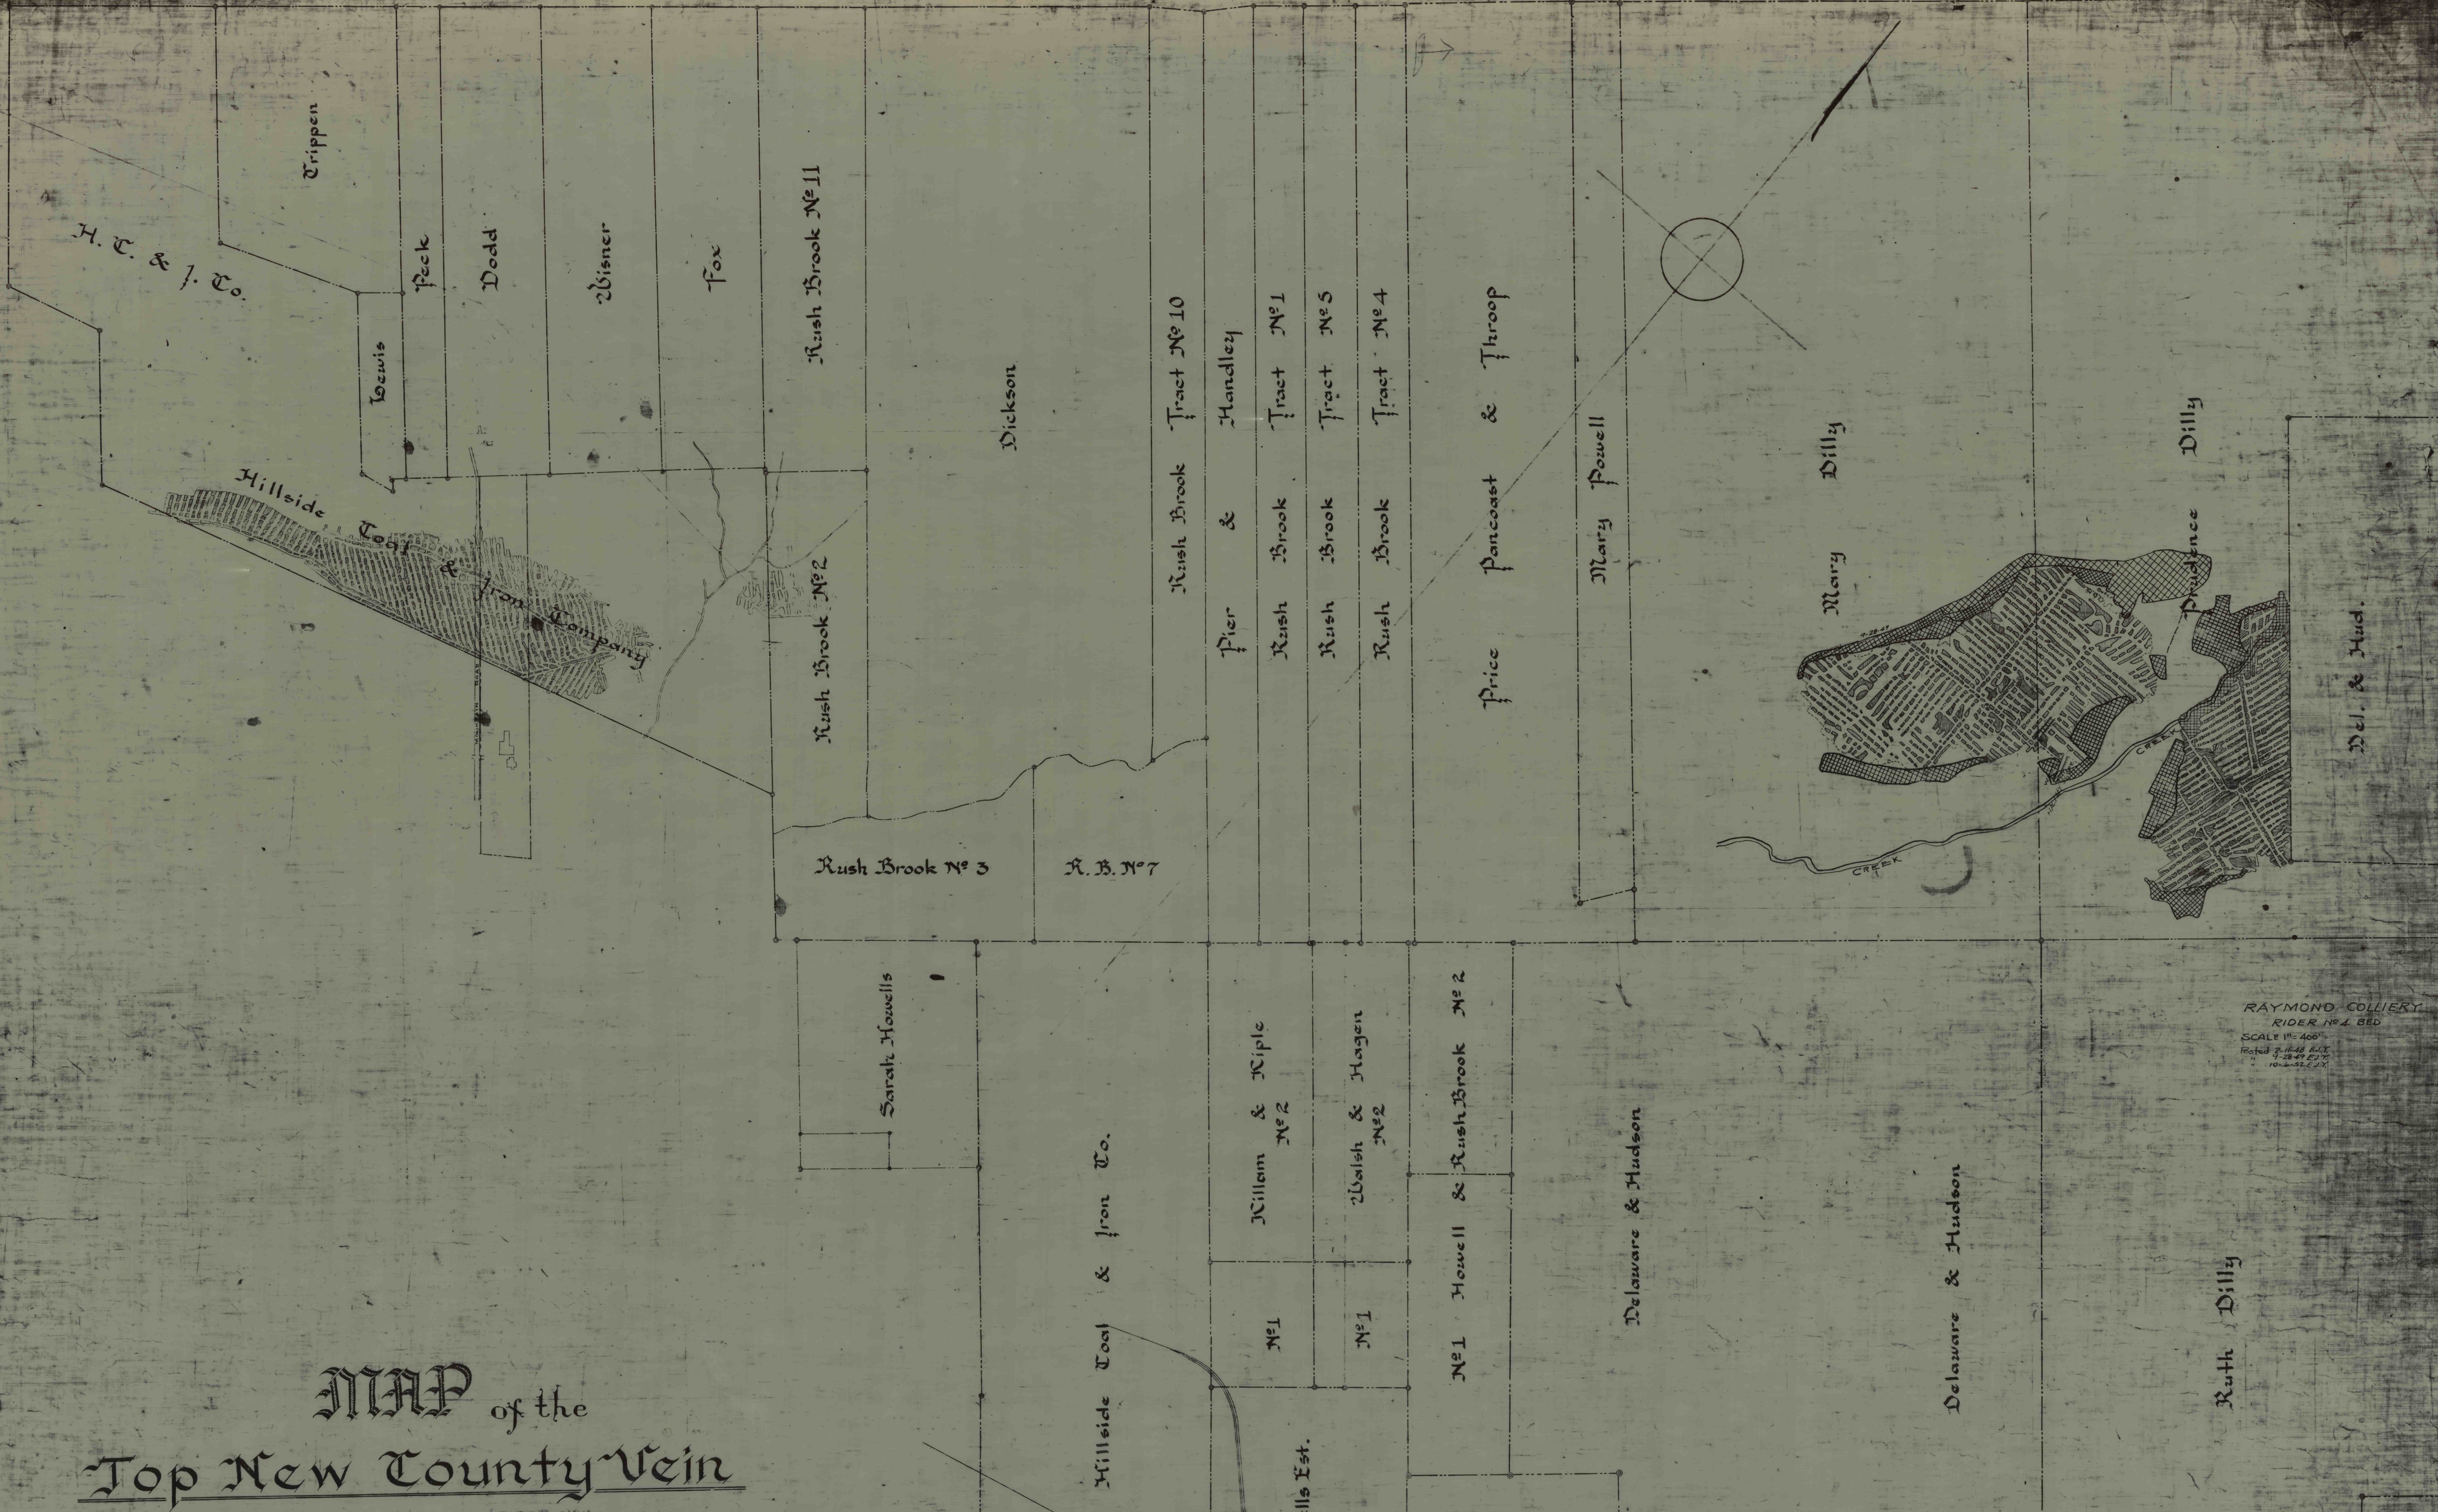

RAYMOND COLLIERY
 RIDER No. 4, 680
 SCALE 1" = 400'
 PLOTTED BY H. B. BENT
 1892

H. C. & J. Co.

Hillside Tool & Iron Company

Rush Brook No 11

Rush Brook No 2

Rush Brook No 3

R. B. No 7

Sarah Howells

Hillside Tool & Iron Co.

William & Kiple No 2

Walsh & Hagen No 2

No 1

No 1

No 1 Howell & Rush Brook No 2

Mary Powell

Price Hancock & Throop

Mary Dilly

Delaware & Hudson

Delaware & Hudson

Providence Dilly

Ruth Dilly

Del. & Hud.

Delaware & Hudson

Del. & Hud.

Trippen

Lewis

Peck

Dodd

Wisner

Fox

Dickson


Rush Brook Tract No 10

Pier & Handley

Rush Brook Tract No 1

Rush Brook Tract No 5

Rush Brook Tract No 4

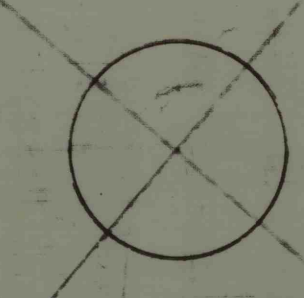

CREEK

CREEK


Lackawanna

Decker Tract

D. Howells Est.