


Elk Hill Coal & Iron Co.
 Plot of Lots on the
 Walsh & Hagen and Howell & Rushbrook Tracts
 in the Town of Eynon,
 Archbald, Pa. Scale 100' = 1"

See Sarah Howells Real Estate Map 1181-24-Dw-3

See Map Showing Lots as plotted on the Walsh & Hagen Tract of the Elk Hill Coal & Iron Co. recorded Map Book 3, Page 85.

See Map Book 4, Page 44 for Walsh & Hagen and Howell & Rushbrook lots.

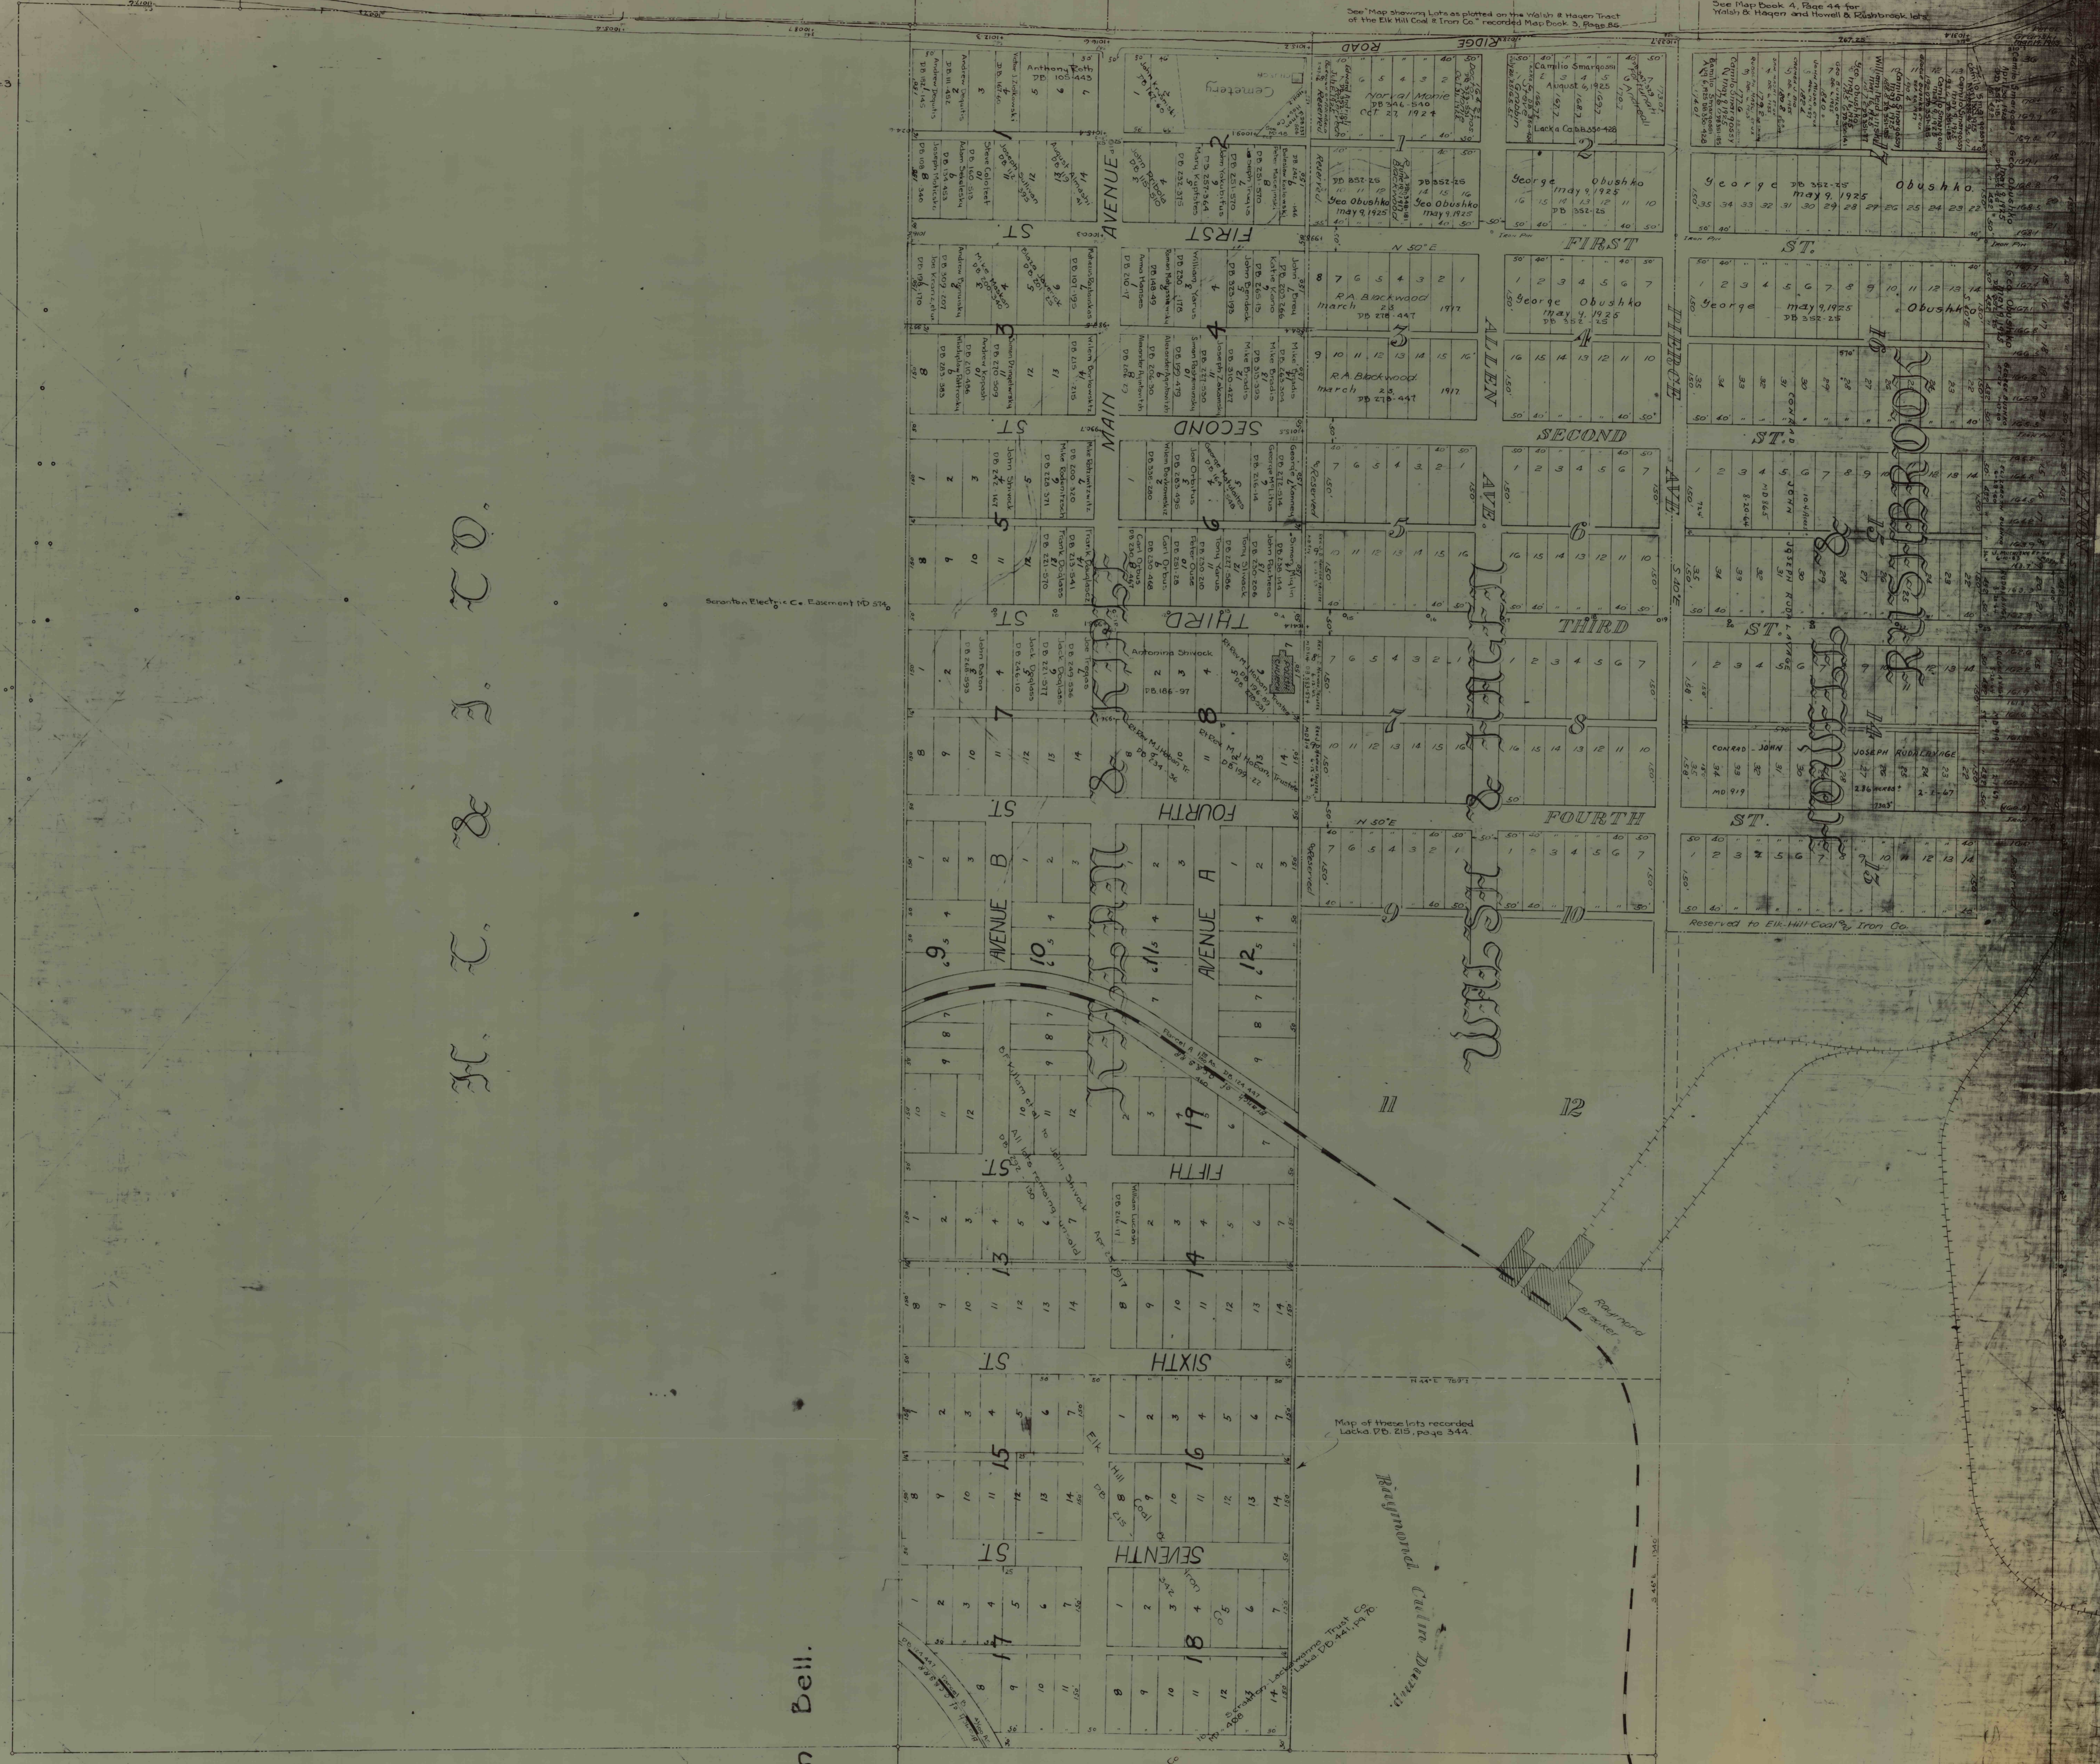


Jonathan Bell.

D. Howell.

Elk Hill Coal & Iron Co.

Map of these lots recorded
 Lacha P.D. 215, page 344.

Raymond
 Culture Dump

Reserved to Elk Hill Coal & Iron Co.