


RIVERSIDE SURFACE VEIN
SCALE 1"=100'

D. HOWELLS

DECKER

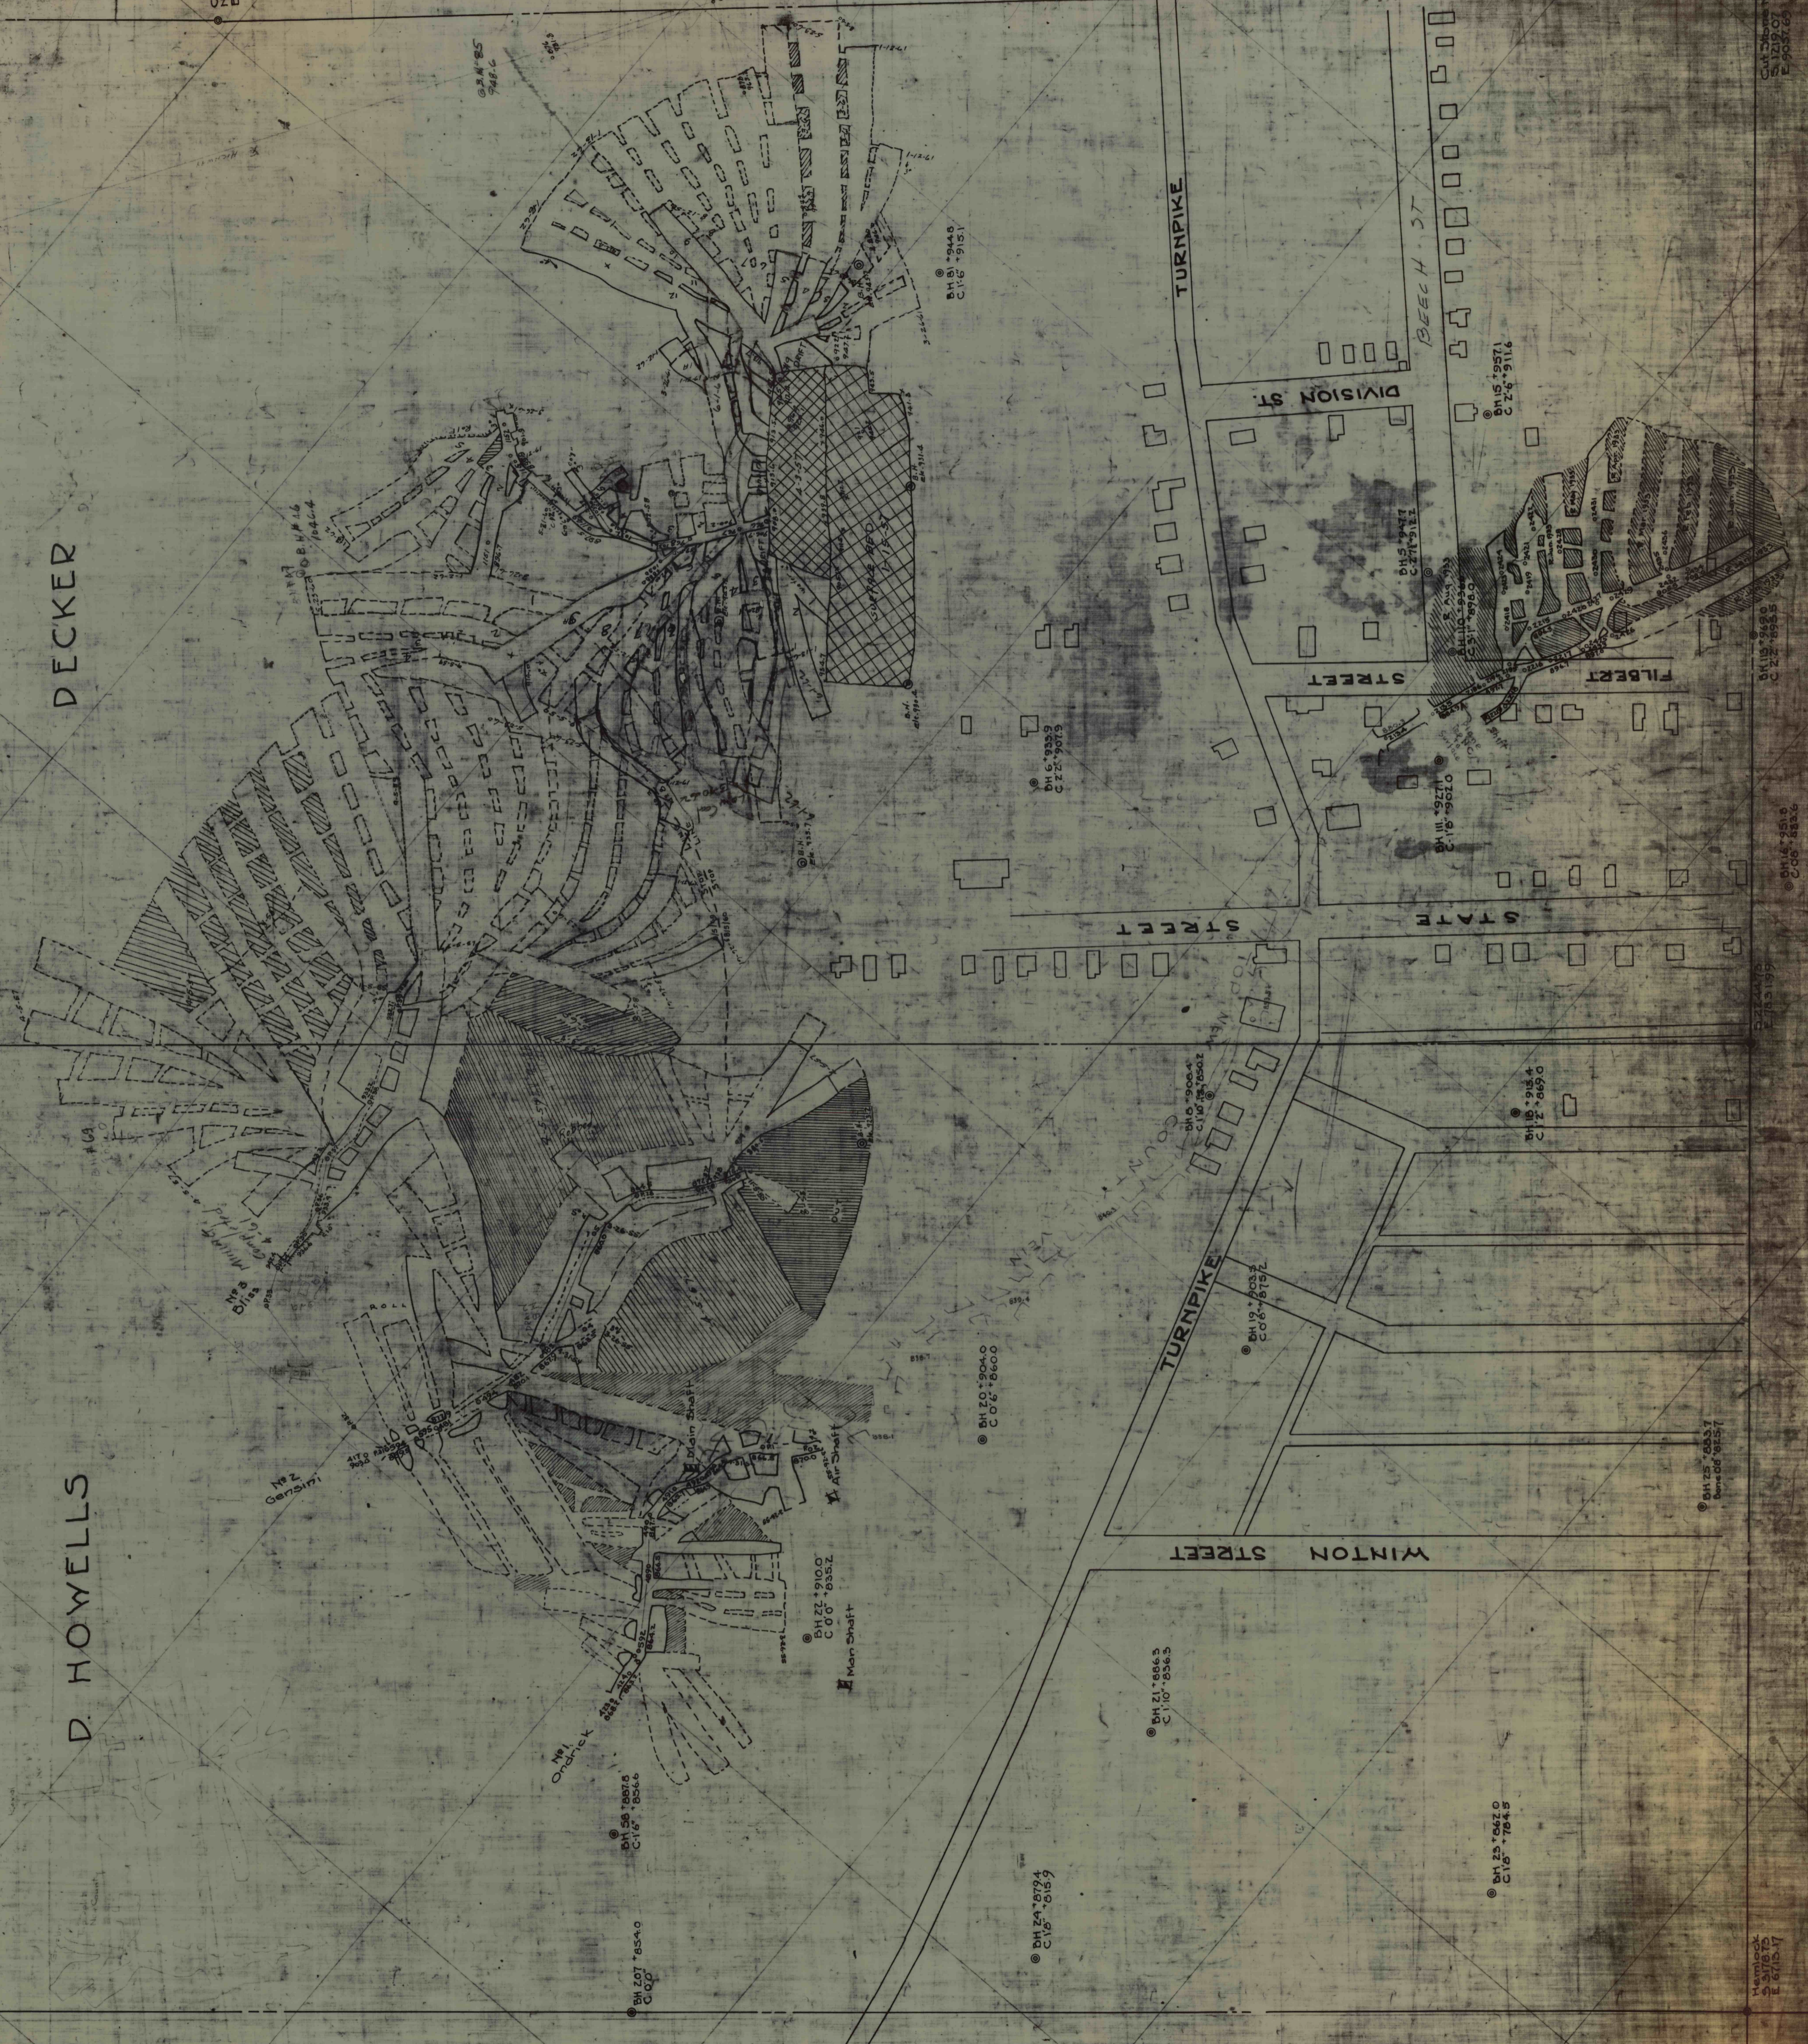

E 27/517

SURFACE VEIN

SURFACE VEIN

SURFACE VEIN