


LEHIGH & WILKES-BARRE COAL CO.

STANTON COLLIERY

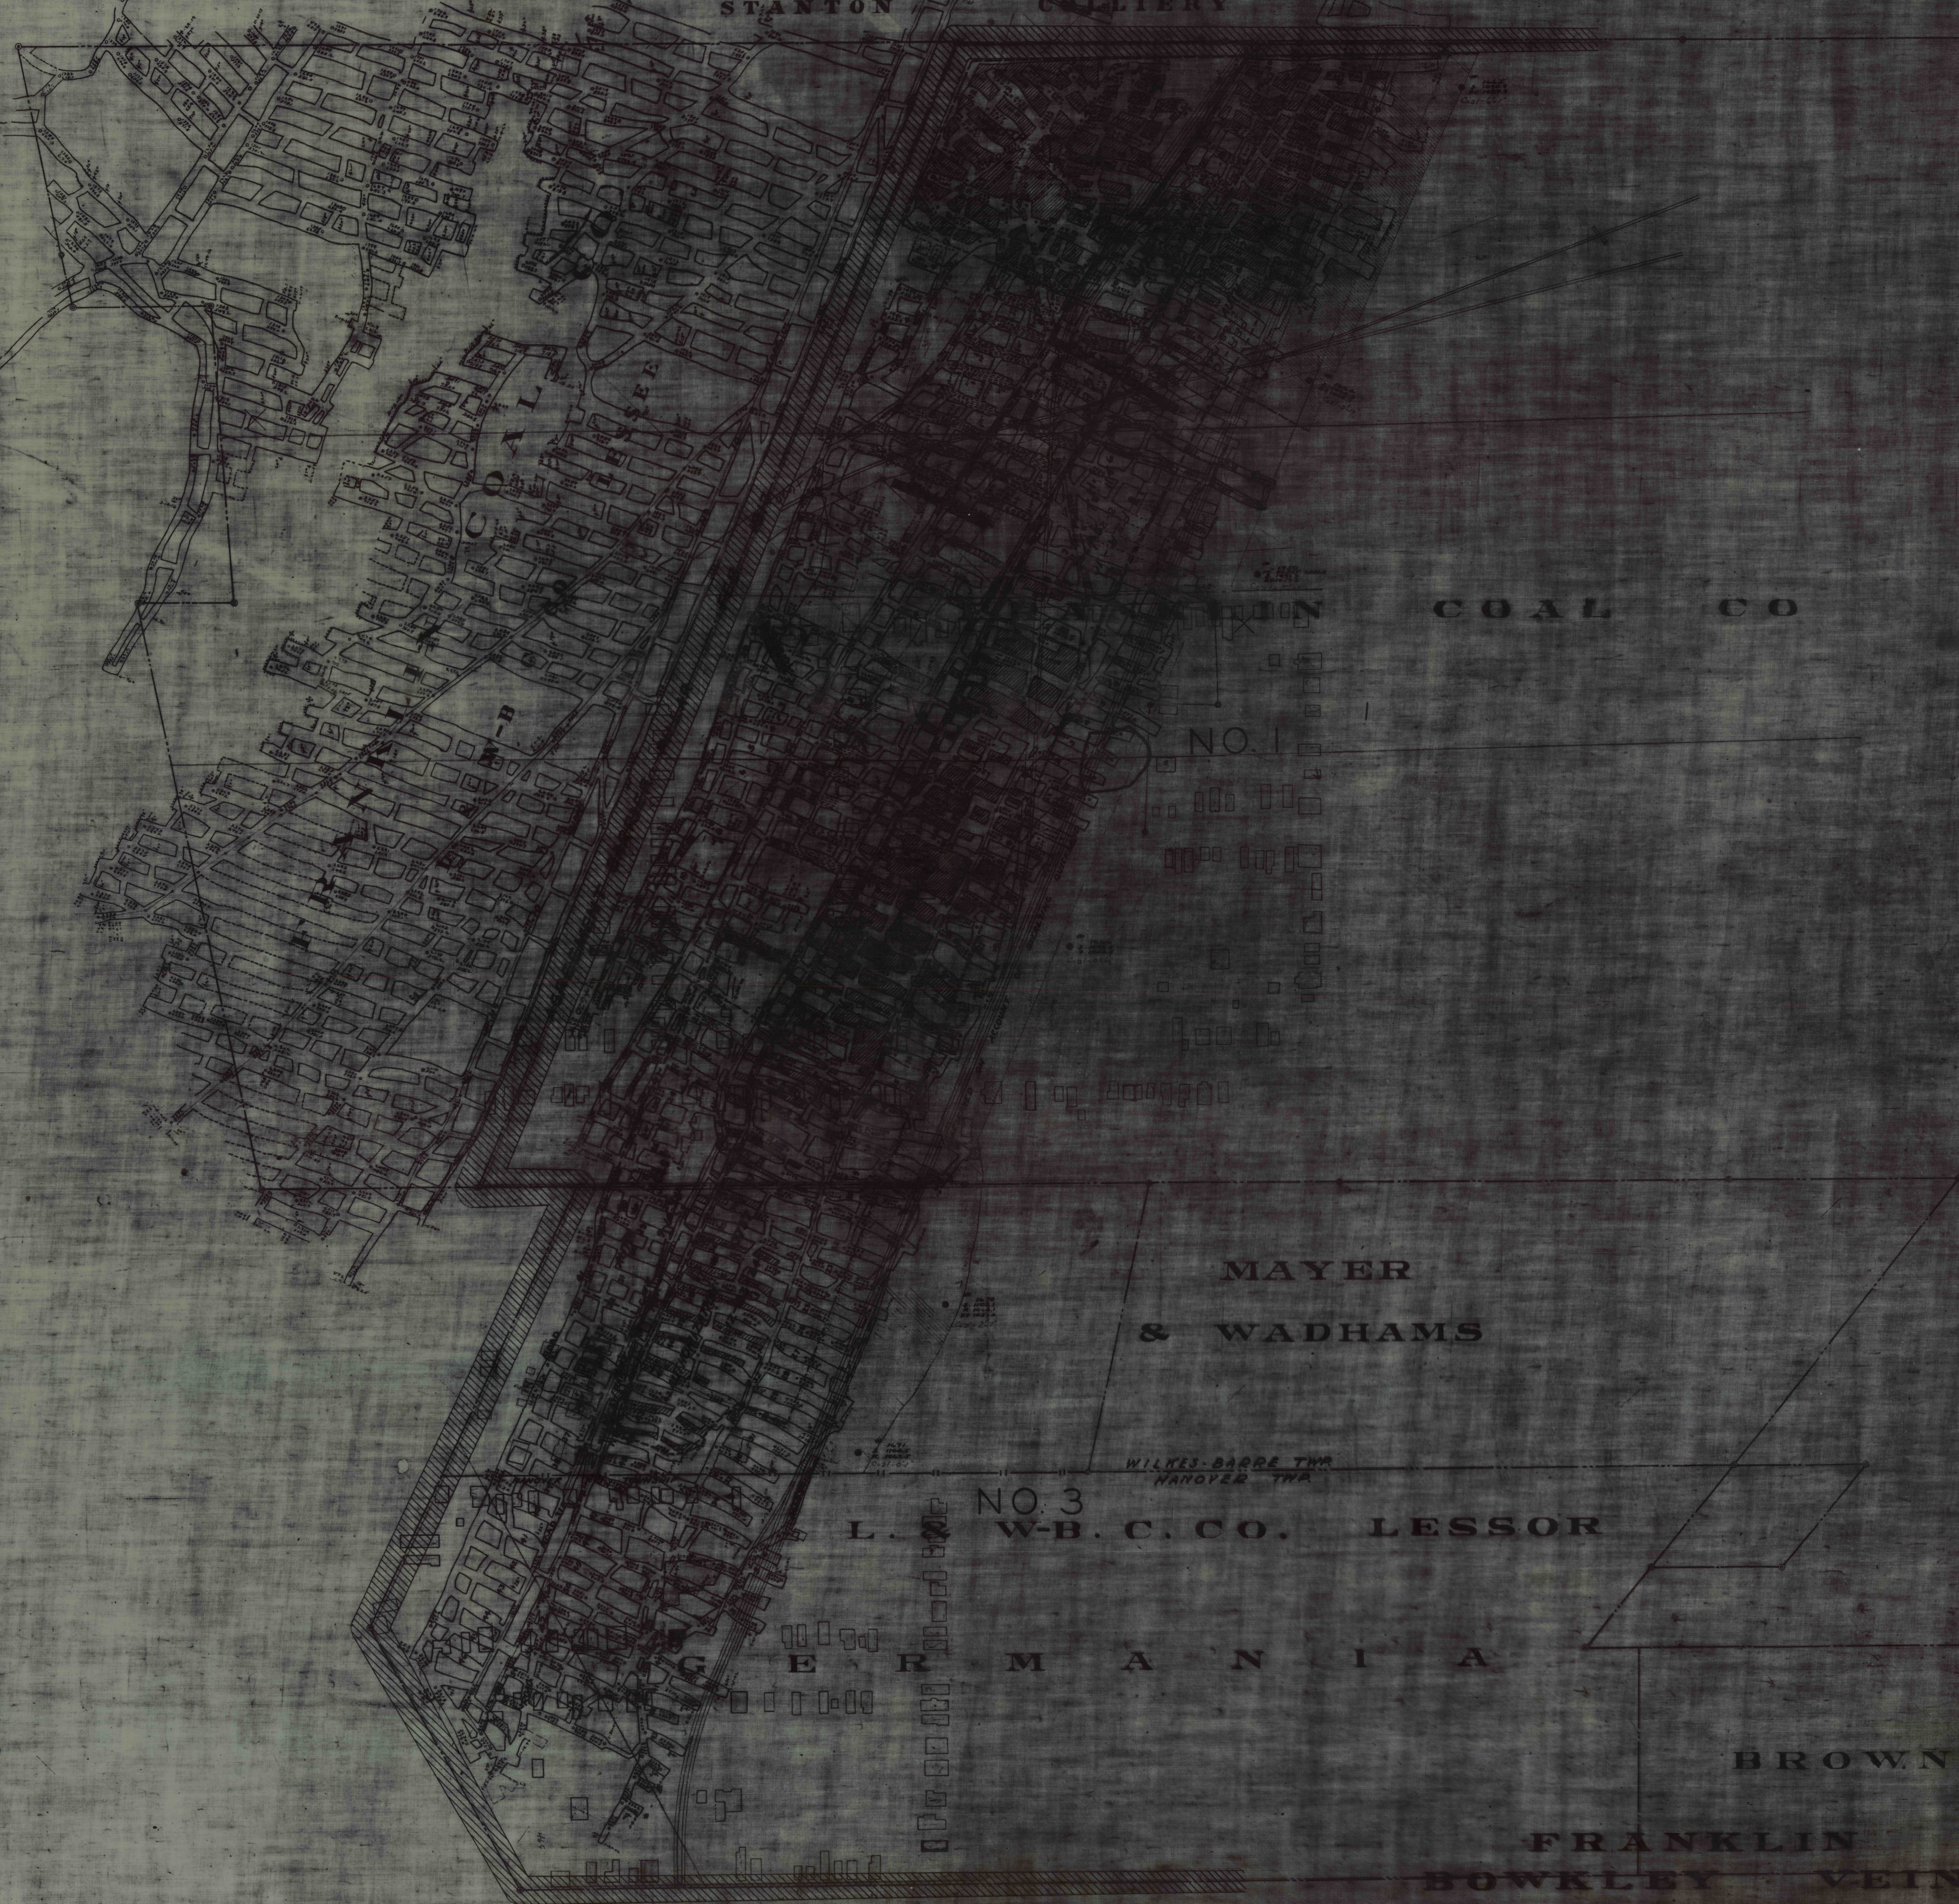

COAL CO

NO. 1

MAYER & WADHAMS

NO. 3 L. WB. C. CO. LESSOR

GERMANIA

BROWN

FRANKLIN BOWKLEY VEIN

LEHIGH & WILKES-BARRE COAL CO.

MAXWELL COLLIERY

SCALE 100 FT. = 1 IN. DATUM 500 FT. BELOW TIDE.

EXPLANATION OF SYMBOLS
SHOWING BACKFILL
ROCK FILLING - FULL TO ROOF