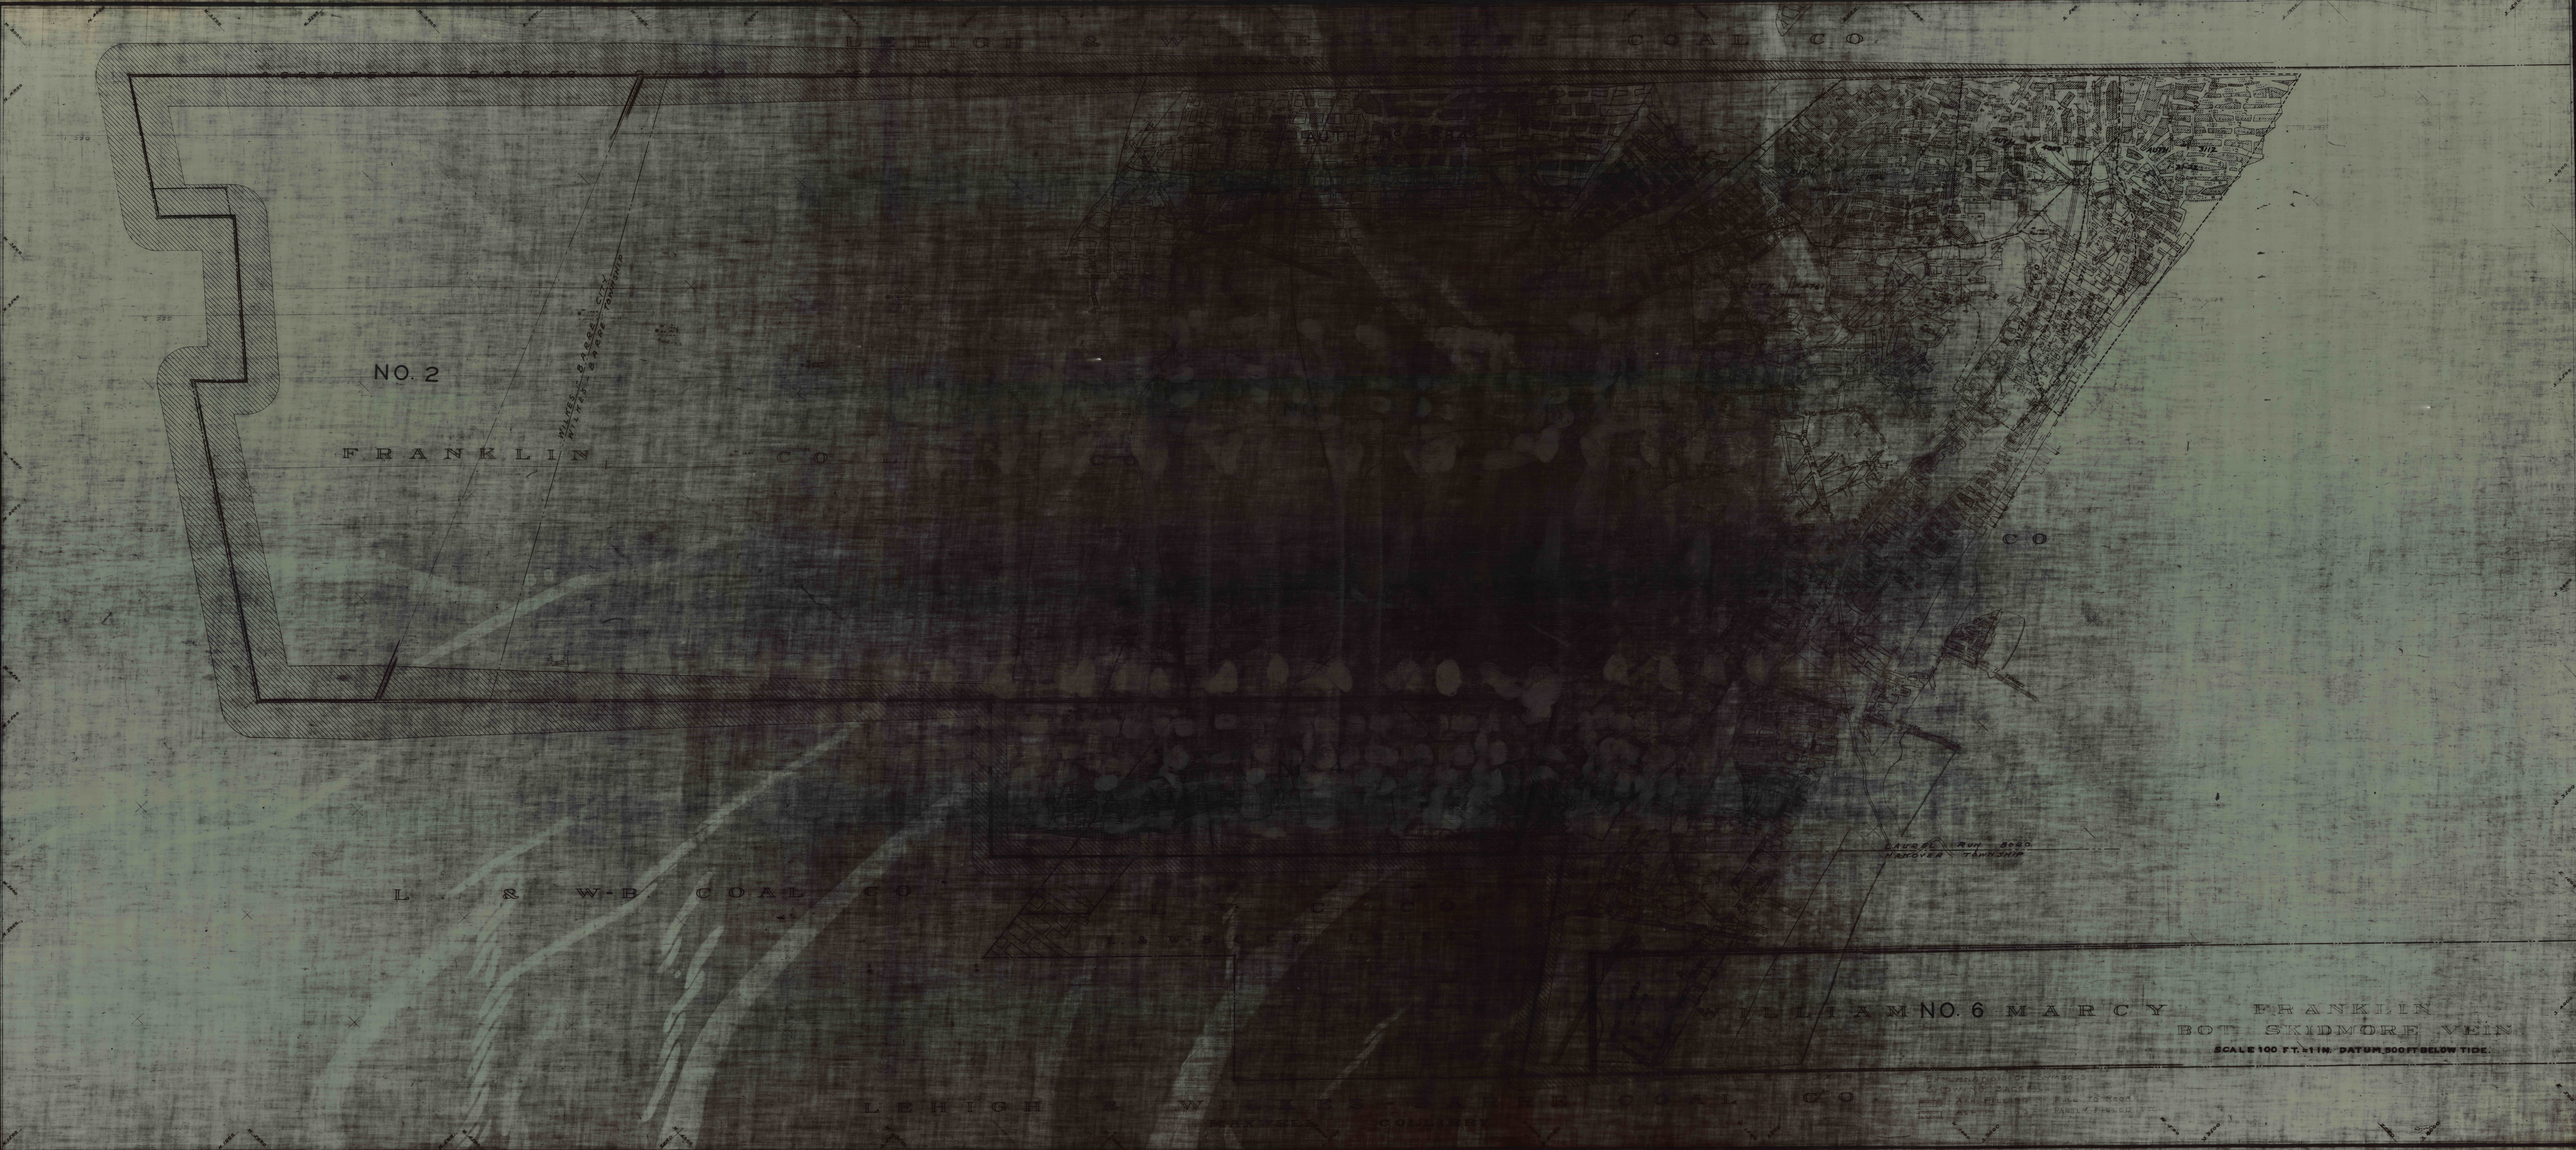

LEHIGH & WILKES-BARRE COAL CO
NO. 2
FRANKLIN COAL CO
WILKES-BARRE CITY
WILKES-BARRE TOWNSHIP
L. & W-B COAL CO
CO
LAUREL RUN BORO.
HANOVER TOWNSHIP
LEHIGH & WILKES-BARRE COAL CO
MAXWELL COLLIERY
N 1000
S 3000
N 500
S 3500

WILLIAM NO. 6 MARCY FRANKLIN
BOT. SKIDMORE VEIN
SCALE 100 FT.=1 IN. DATUM 500 FT BELOW TIDE.

EXPLANATION OF SYMBOLS
SHOWING BACKFILL
ASH FILLING — FULL TO ROOF
ASH FILLING — PARTLY FILLED ETC.