


Map Showing Working of the Four Foot Vein
at the
MOUNT PLEASANT MINES

1/1/35

DELAWARE LACKAWANNA AND WESTERN RAILROAD COMPANY

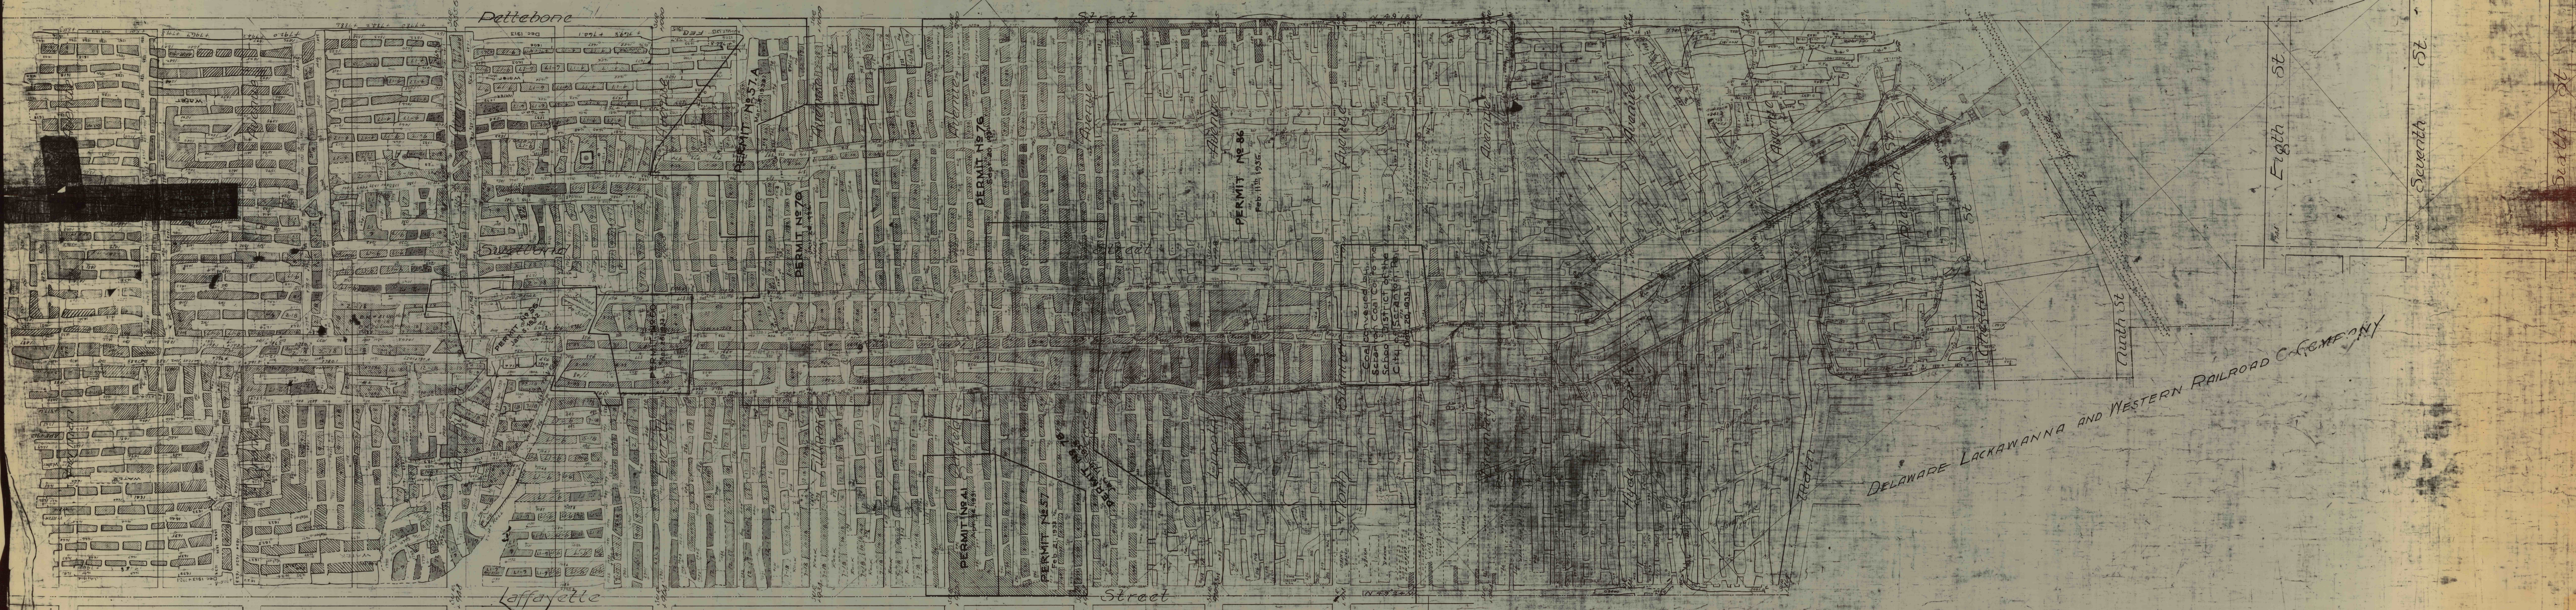

DELAWARE LACKAWANNA AND WESTERN RAILROAD COMPANY

D. L. & W. R. R. Co. Peoples Coal Co.

DELAWARE LACKAWANNA AND WESTERN RAILROAD COMPANY