


- 1. Section
- 2. Large Cell - 1 Block
- 3. Small Shower - 1 Block
- 4. Large Cell - 2 Blocks
- 5. 2 Blocks
- 6. " " " "
- 7. " " " "
- 8. Five Foot Flat
- 9. Large Cell & 2 Blocks

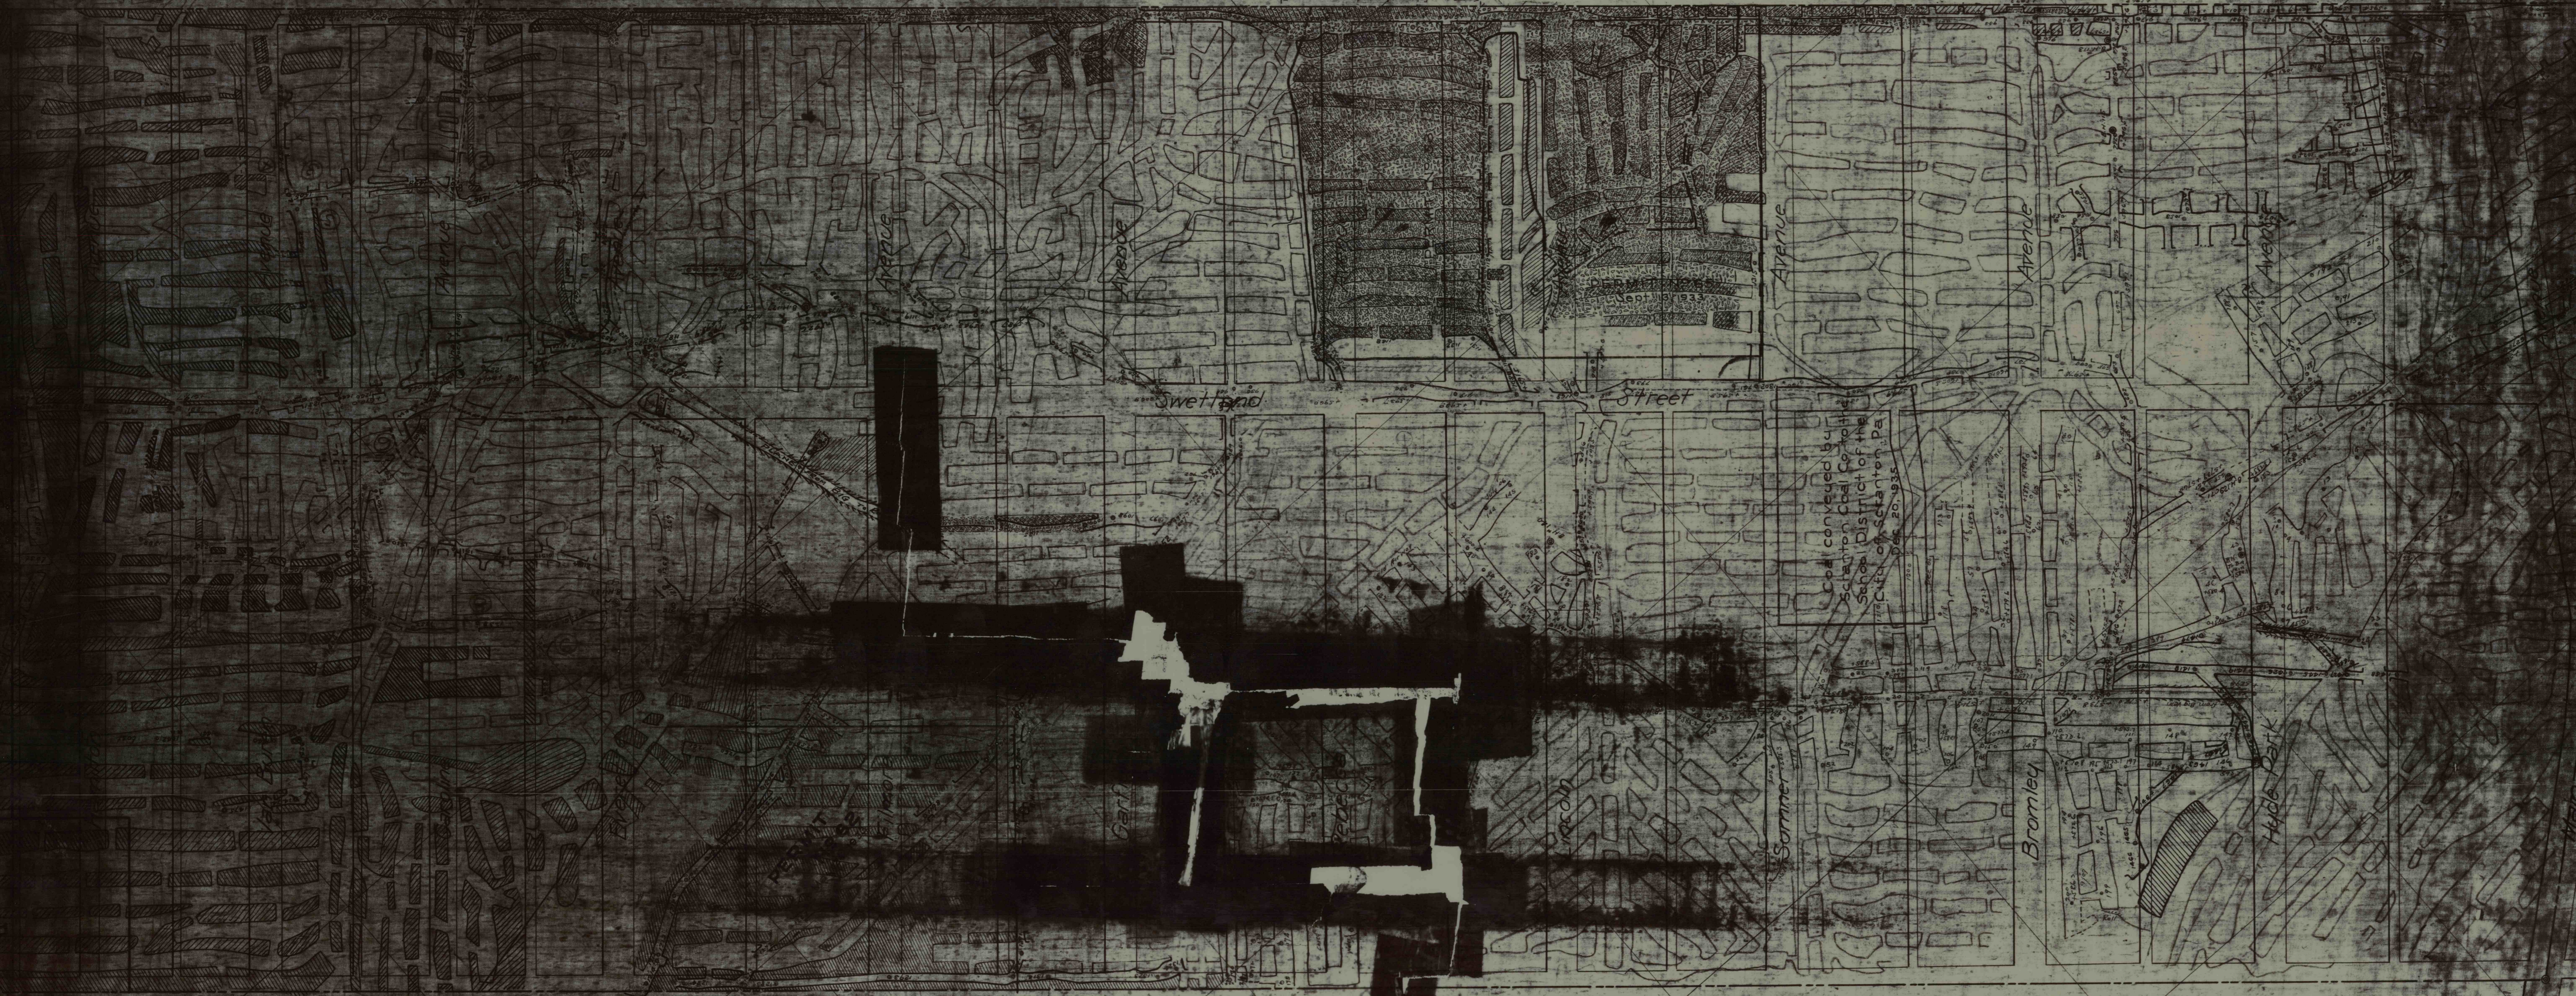

Cell conveyed by
 Section 104

Room Packing & Rebbing Posted

SHOWING THE WORKING
 OF THE
 MOUNTAIN
 DISTRICT