


Allied
Ventures
ALBERT
Marchelle

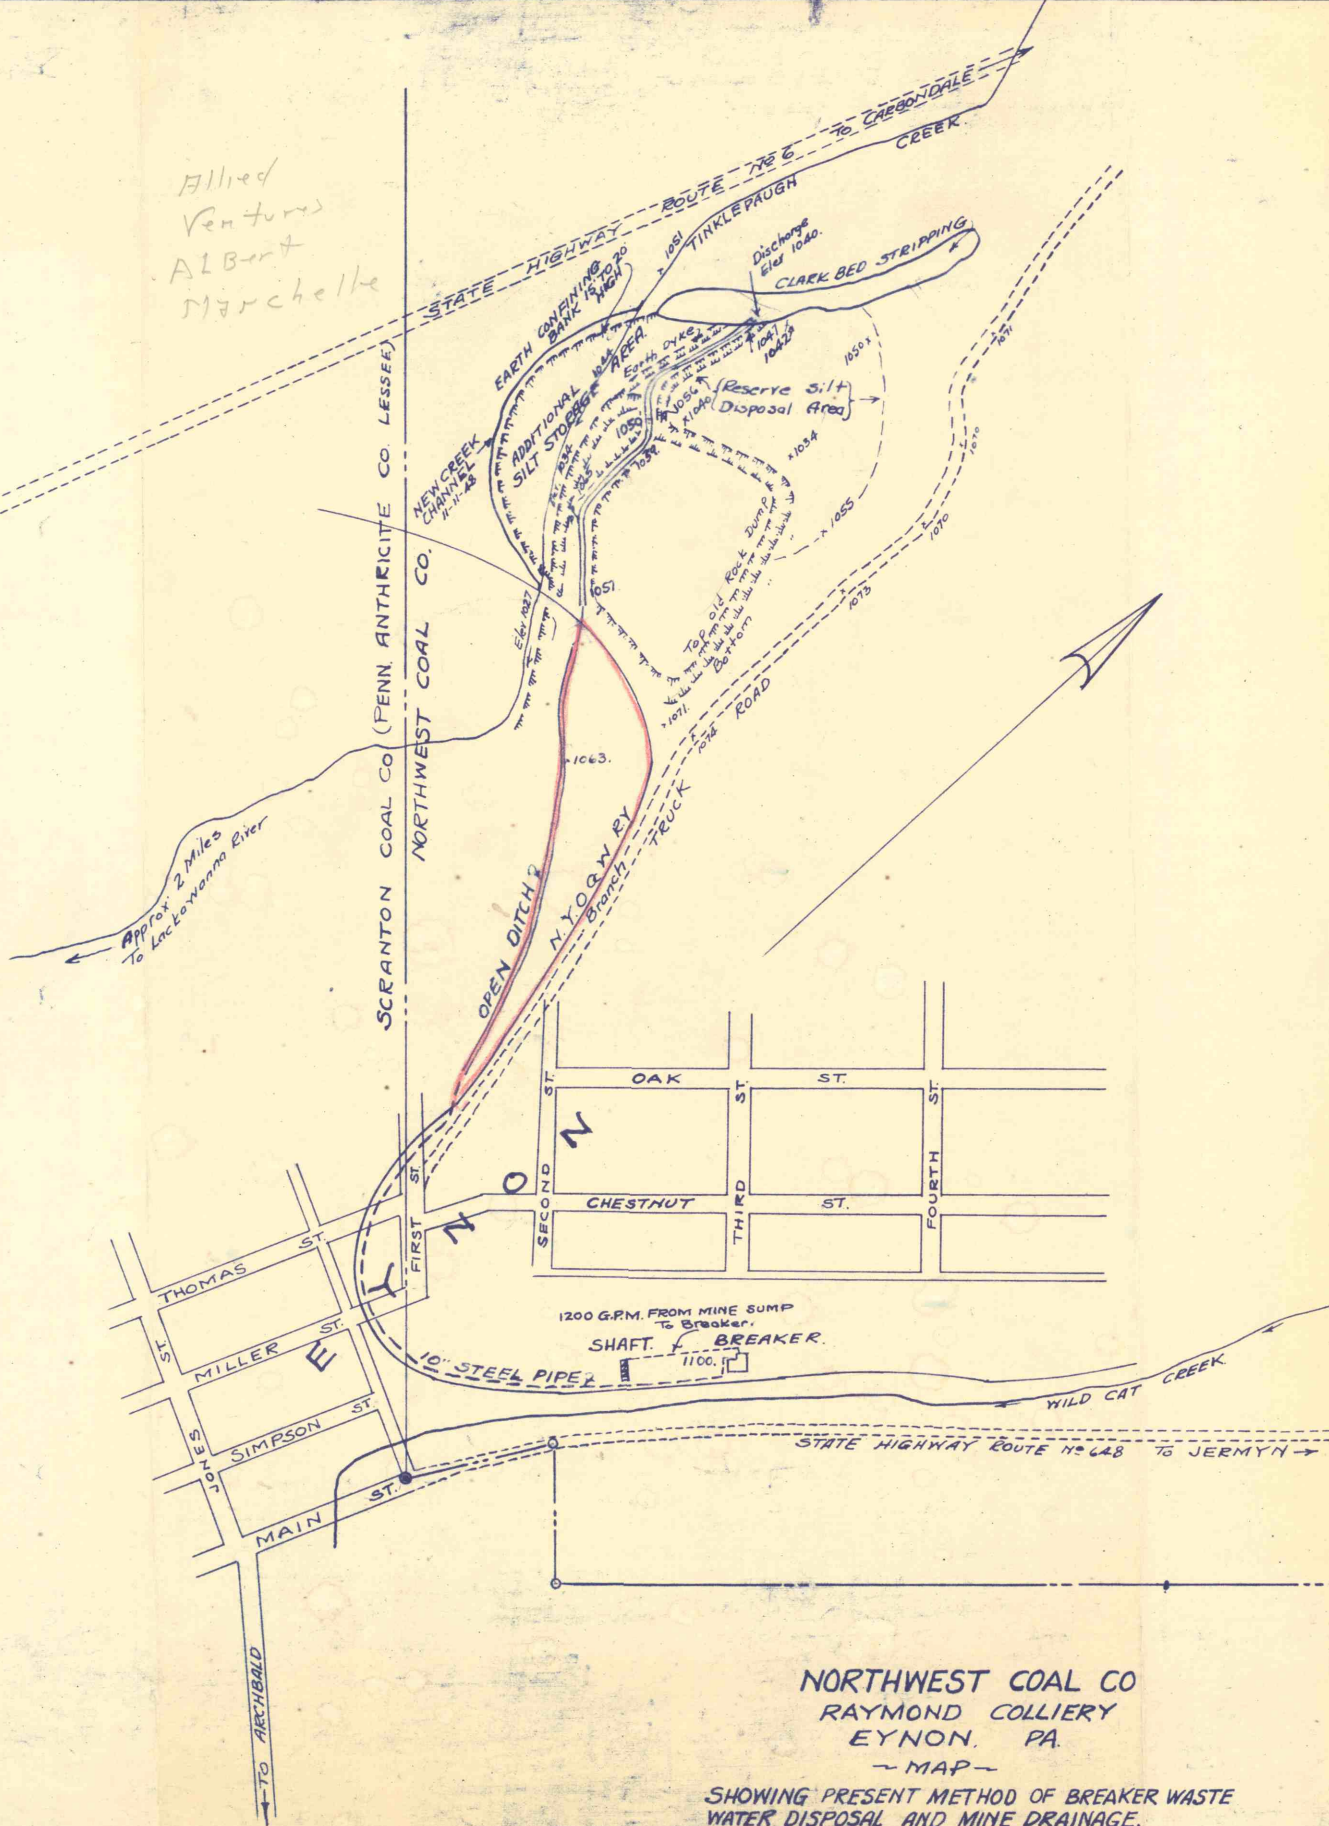

NORTHWEST COAL CO
RAYMOND COLLIERY
EYNON, PA.

~ MAP ~

SHOWING PRESENT METHOD OF BREAKER WASTE
WATER DISPOSAL AND MINE DRAINAGE.

SCALE 1"=400'

12-18-46
12-6-48