


LEGITTS CREEK BANK
11-4

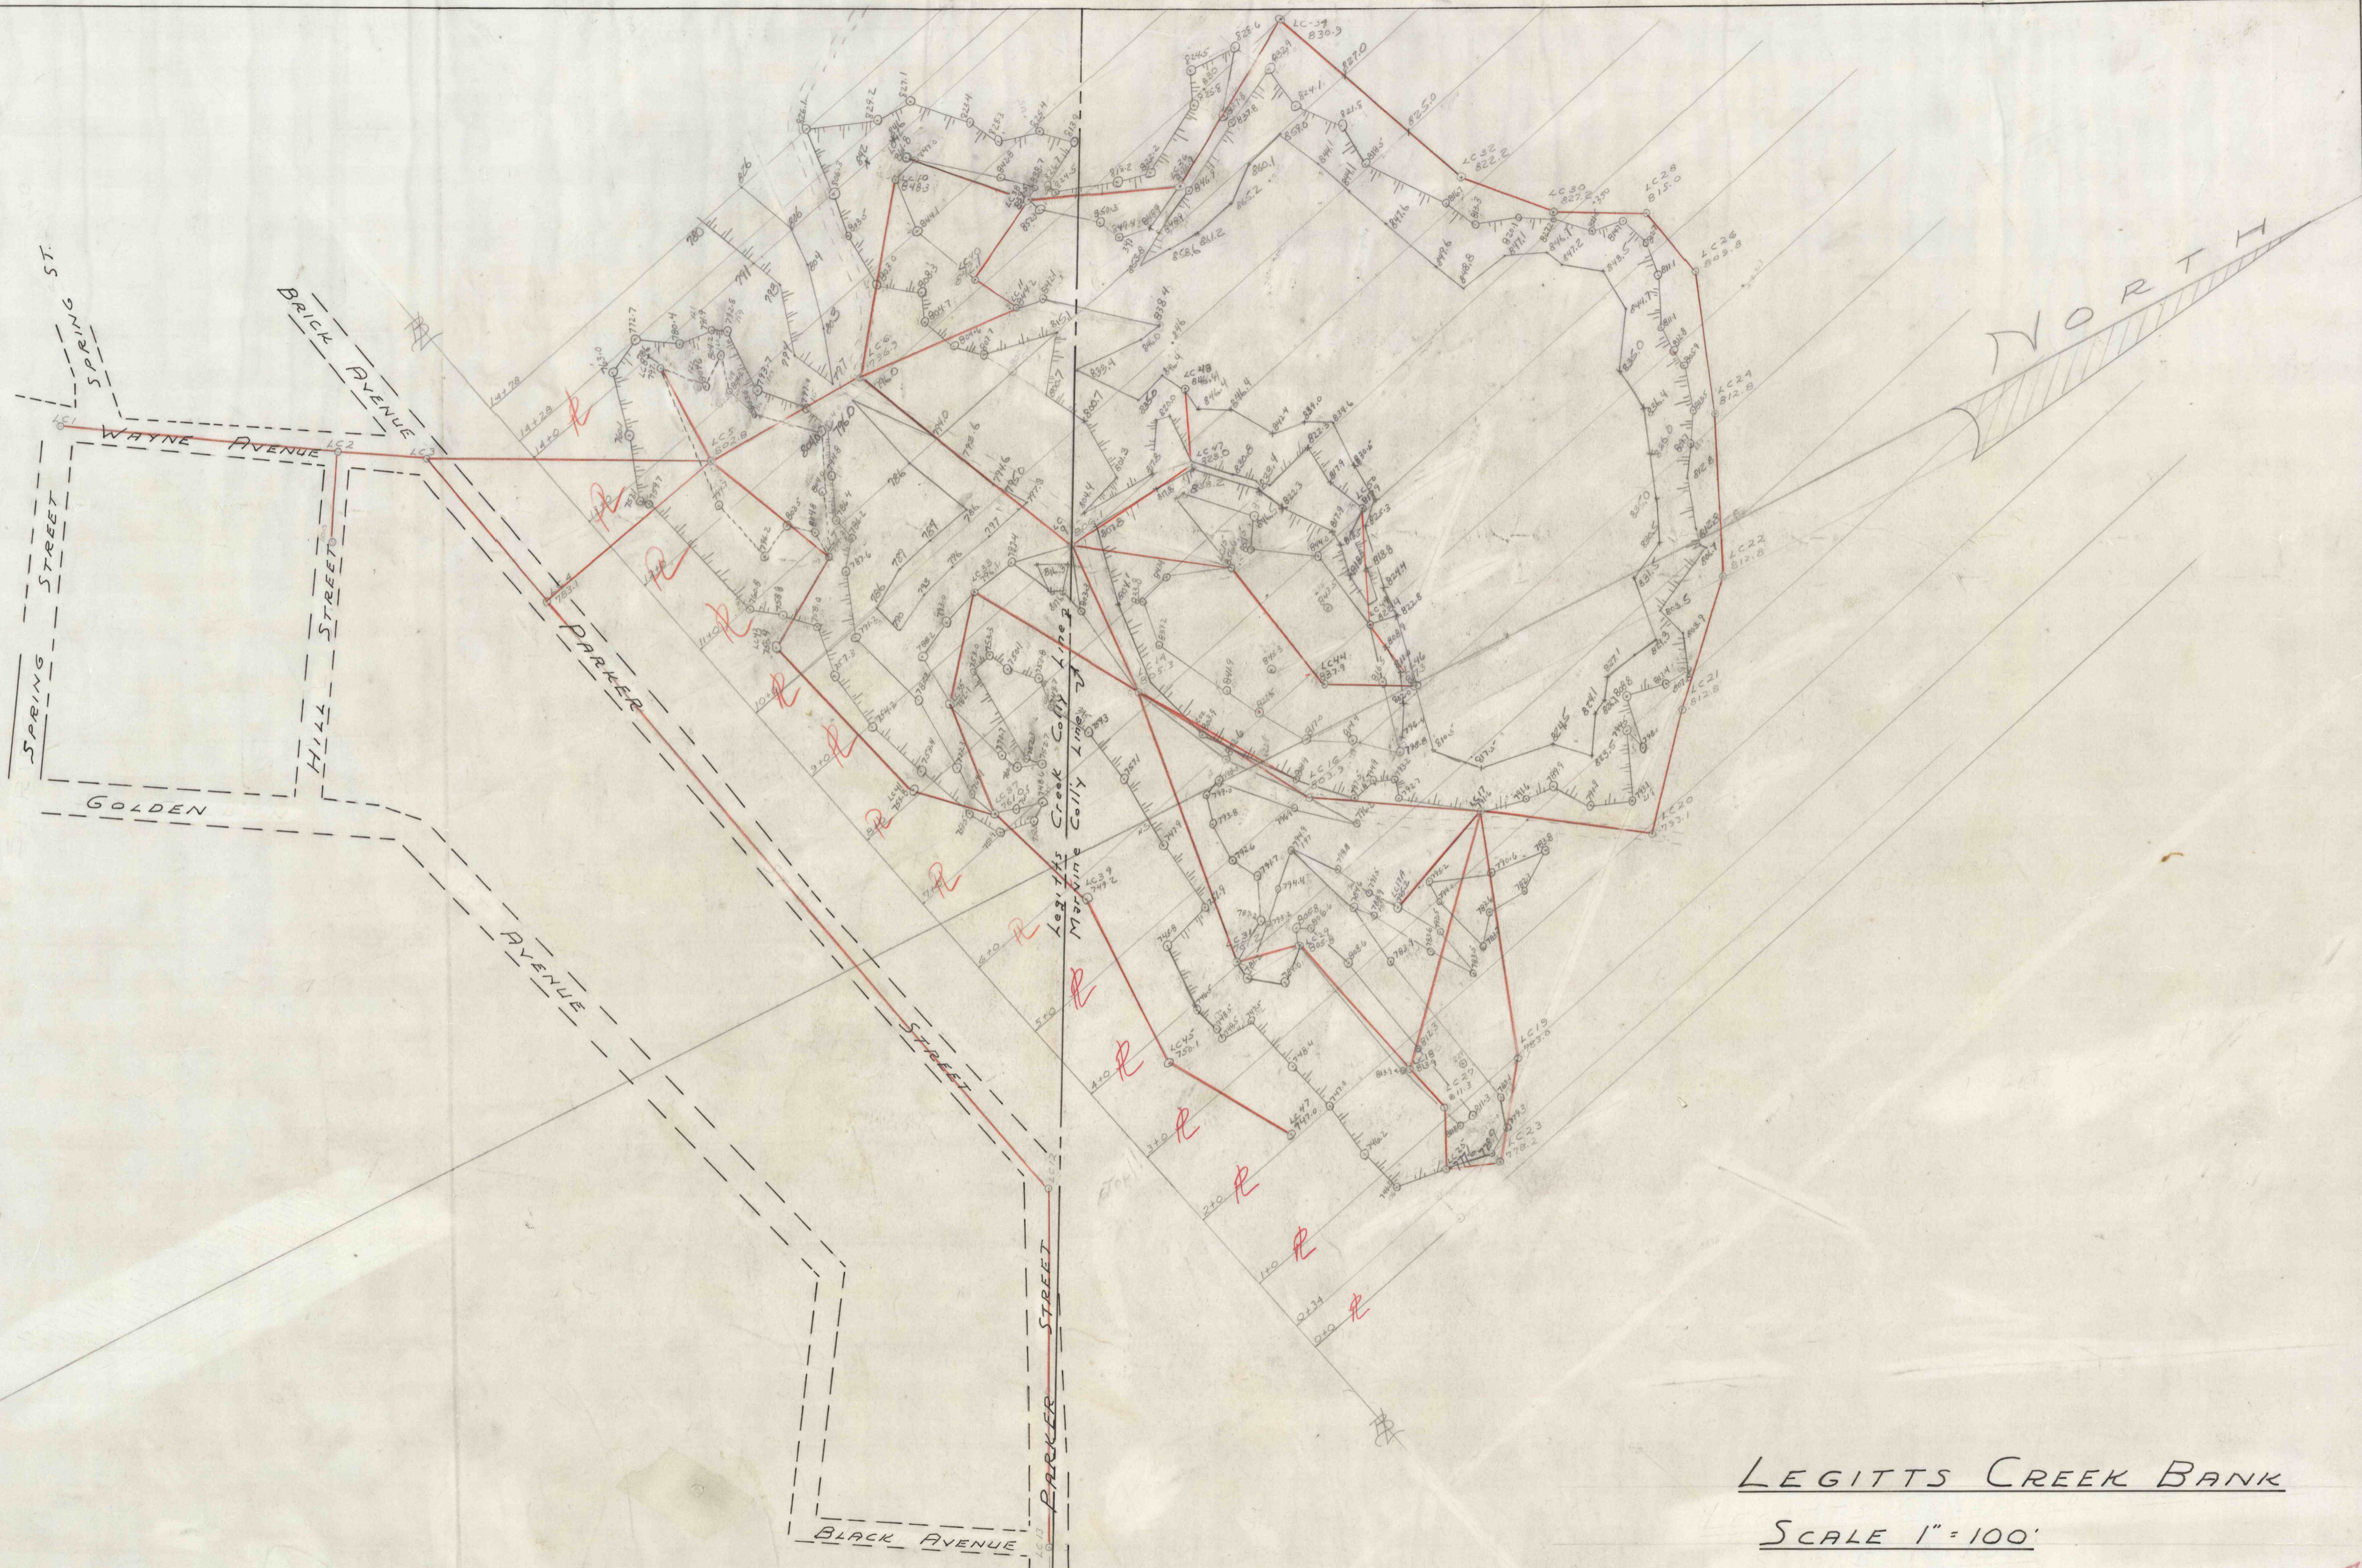

LEGITTS CREEK BANK

SCALE 1" = 100'

JUNE 23, 1975

1-89