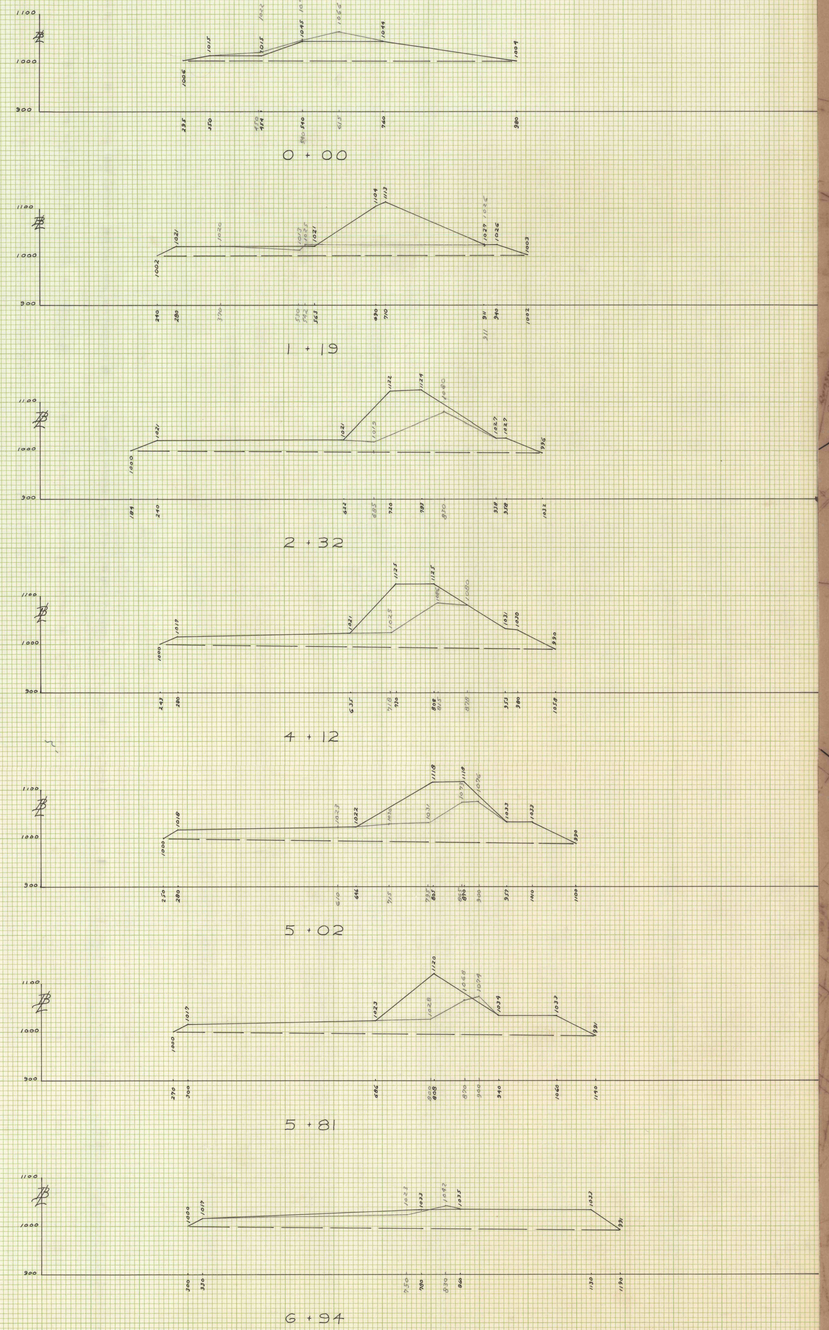

X - Sections
William "A" Refuse Bank
Scale: 1" = 100'

As of Dec 1, 1975 - 885,837 Cu. Yds.
As of Mar 1, 1976 - 819,110 Cu. Yds
As of Dec 27 1977 634328 " "

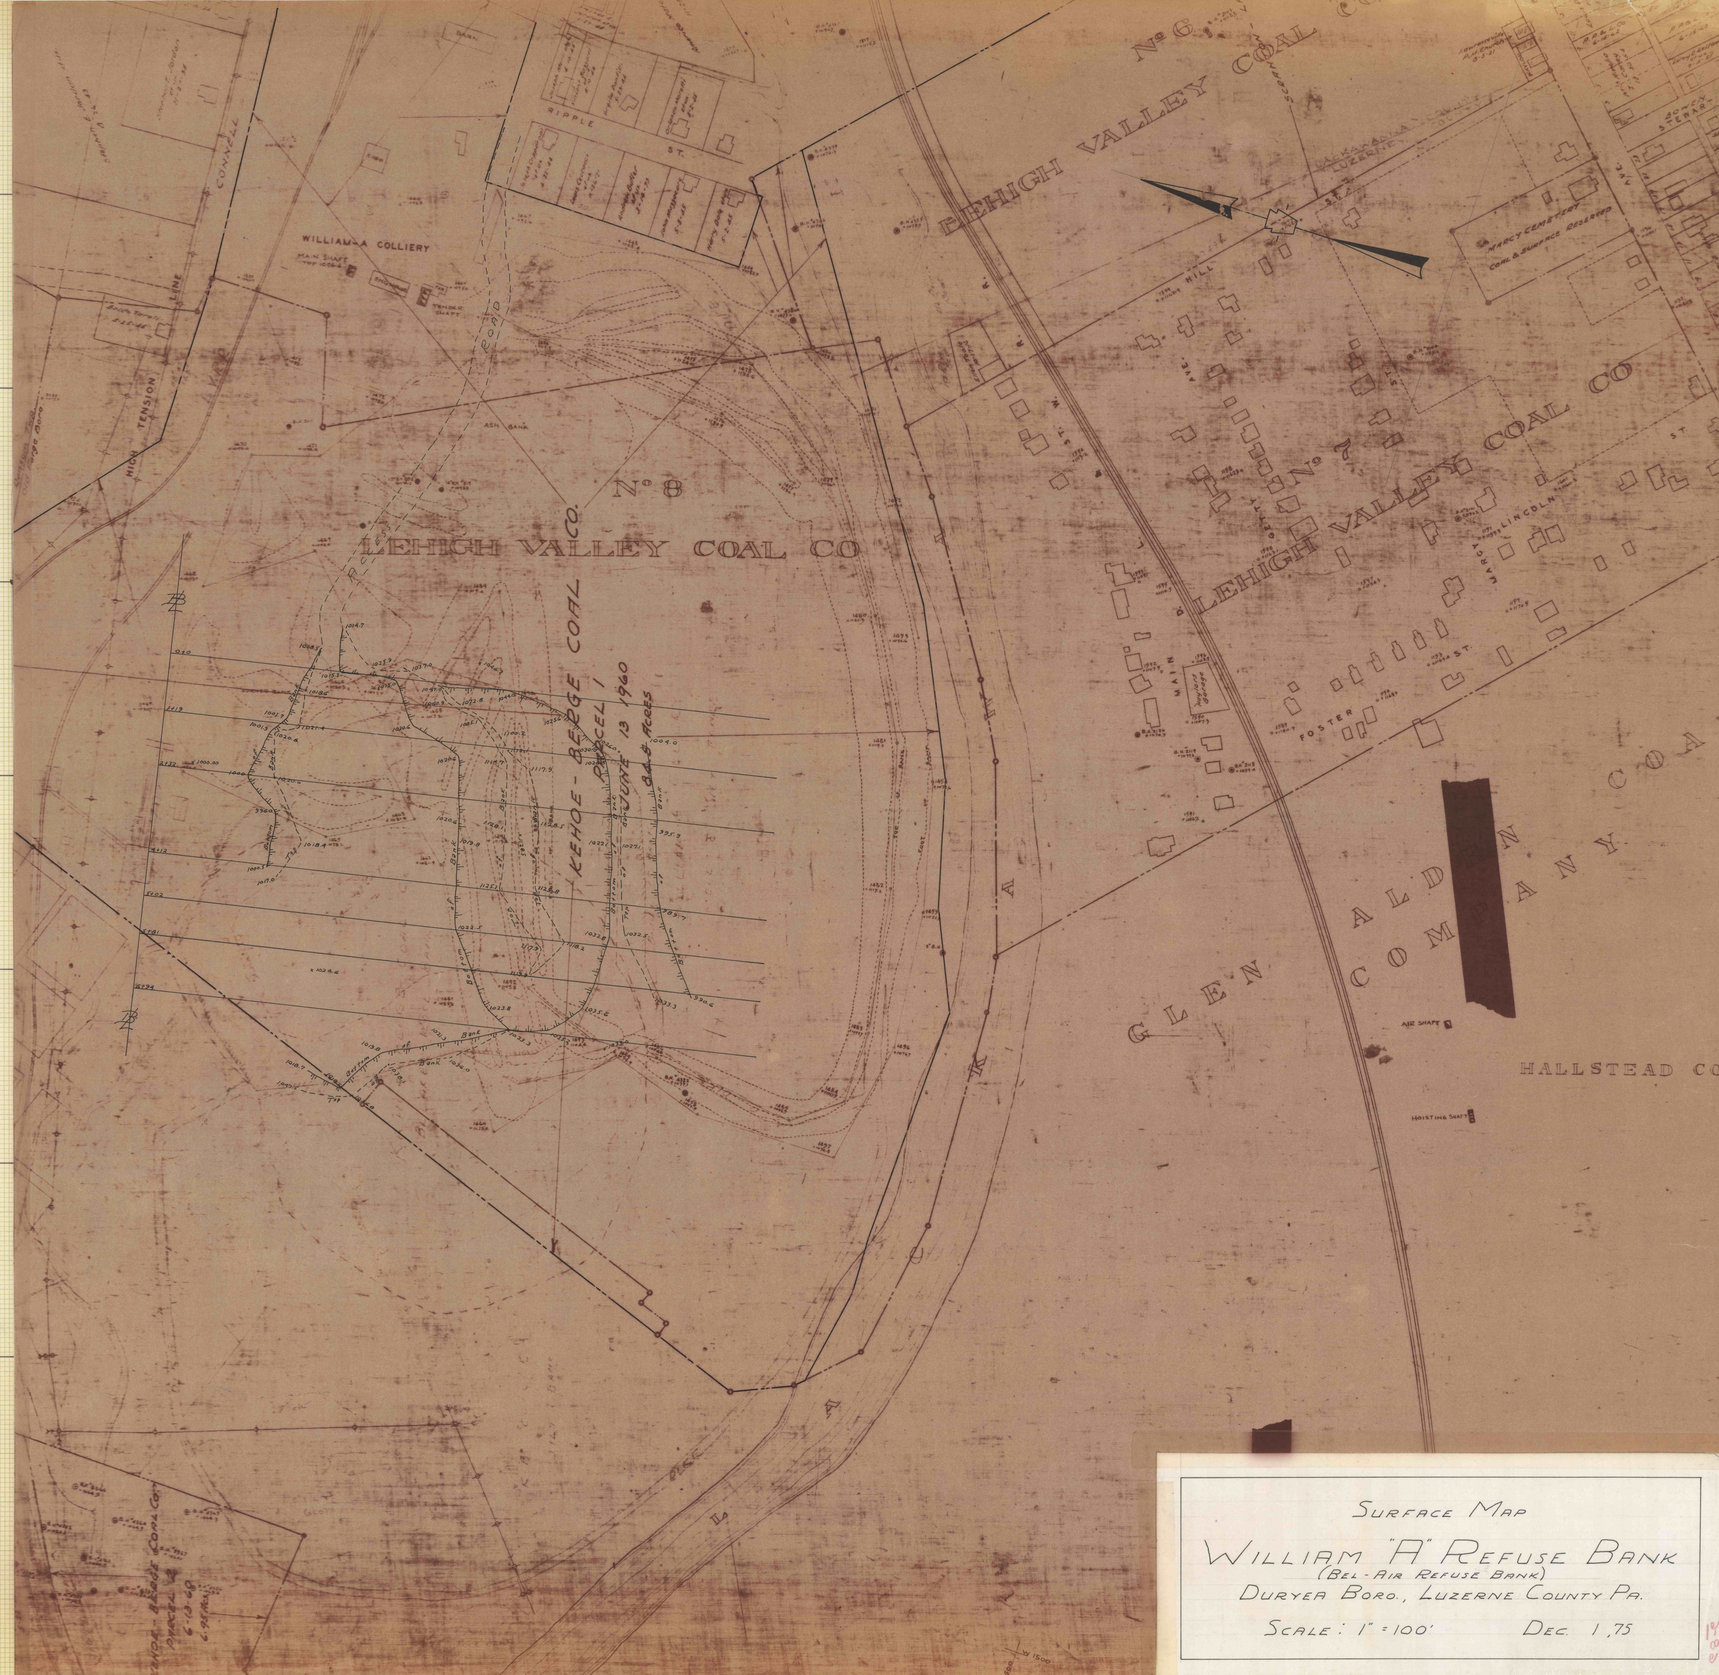

Surface Map
William "A" Refuse Bank
(Bel-Air Refuse Bank)
Duryea Boro., Luzerne County Pa.
Scale: 1" = 100' Dec 1, 75