Mid Valley Bank
Peckville
CROSS SECTIONS
Scale 1"=20' Vert & Horz.
Assumed Elevation
500' @ 0+00

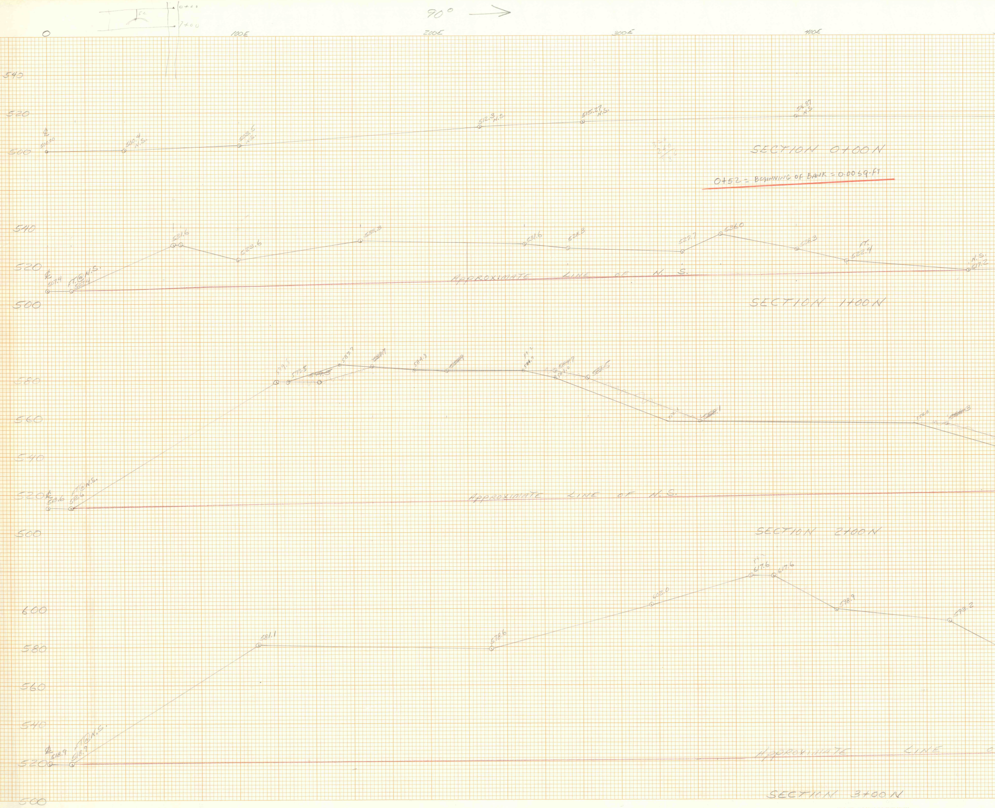

0+00
1+00
52
90° →
0
100E
200E
300E
400E
540
520
500
500.00
500.4 N.S.
508.5 N.S.
512.3 N.S.
515.27 N.S.
516.87 N.S.
SECTION 0+00N
0+52 = BEGINNING OF BANK = 0.00 SQ.FT
540
520
500
507.4
FT.@N.S. 507.4
531.6
523.6
533.3
531.6
528.3
527.7
536.0
528.3
FT. 522.4
N.S. 517.2
APPROXIMATE LINE OF N.S.
SECTION 1+00N
580
560
540
520
500
518.6
FT@N.S. 518.6
579.5
579.5
587.7
584.9
PT. 2 584.9
584.7
581.0
558.1
560
APPROXIMATE LINE OF N.S.
SECTION 2+00N
600
580
560
540
520
500
518.9
FT@N.S. 518.7
581.1
578.6
602.0
FT. 617.6
617.6
598.9
593.2
APPROXIMATE LINE
SECTION 3+00N

K+E 10 X 10 TO THE INCH KEUFFEL & ESSER CO. PRINTED IN U.S.A.

K+E 10 X 10 TO THE INCH KEUFFEL & ESSER CO. PRINTED IN U.S.A.

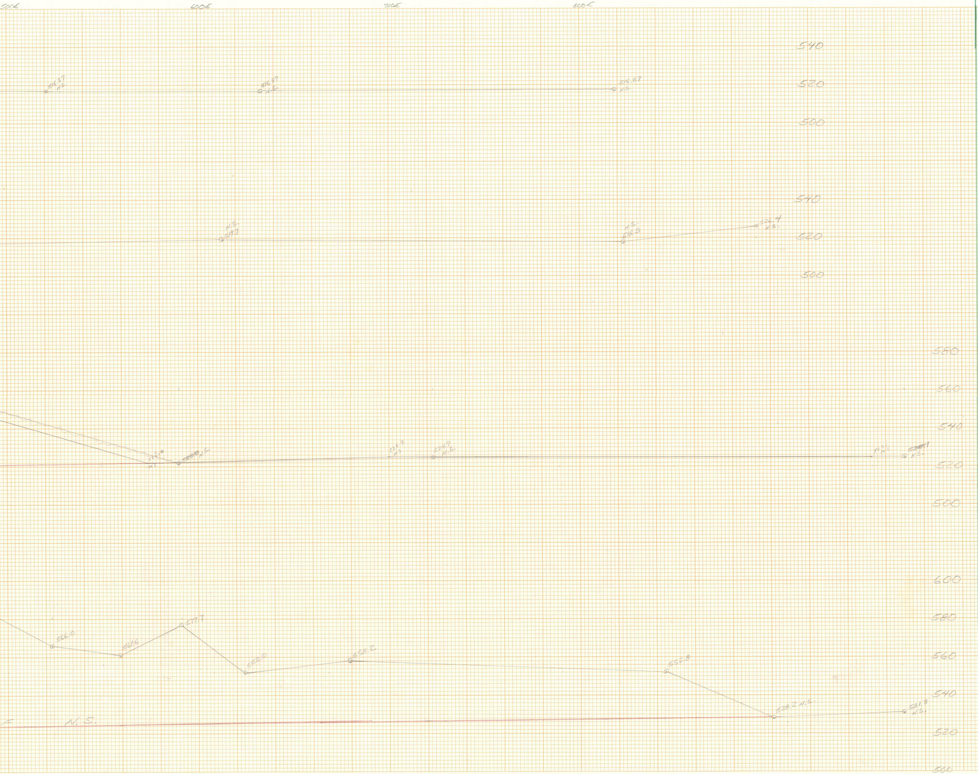

480
240
720
780

800
50
40000

K+E 10 X 10 TO THE INCH
KEUFFEL & ESSER CO.
PRINTED IN U.S.A. 751001

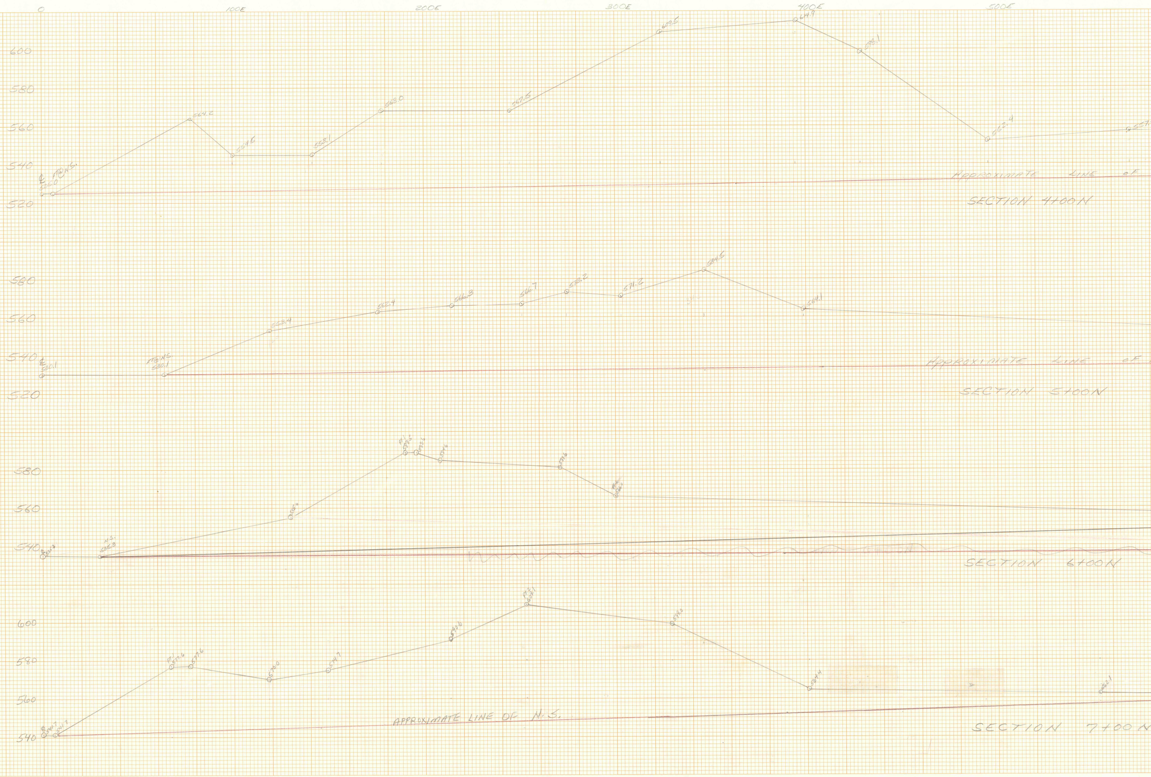
0
100E
200E
300E
400E
500E
600
580
560
540
520
℄
FT@N.S.
525.0
564.2
554.6
553.1
568.0
567.5
609.5
614.9
598.1
552.4
Approximate line of
SECTION 4+00N
580
560
540
520
℄
530.1
FT@N.S.
530.1
553.4
562.4
566.3
566.7
570.2
571.2
584.5
564.1
Approximate line of
SECTION 5+00N
580
560
540
N.S.
535.9
PI
PI
SECTION 6+00N
600
580
560
540
℄
541.7
541.7
PI
577.6
577.6
570.0
574.7
590.6
PI
609.1
598.0
564.4
APPROXIMATE LINE OF N.S.
SECTION 7+00N

K+E 10 X 10 TO THE INCH
KEUFFEL & ESSER CO.
PRINTED IN U.S.A.

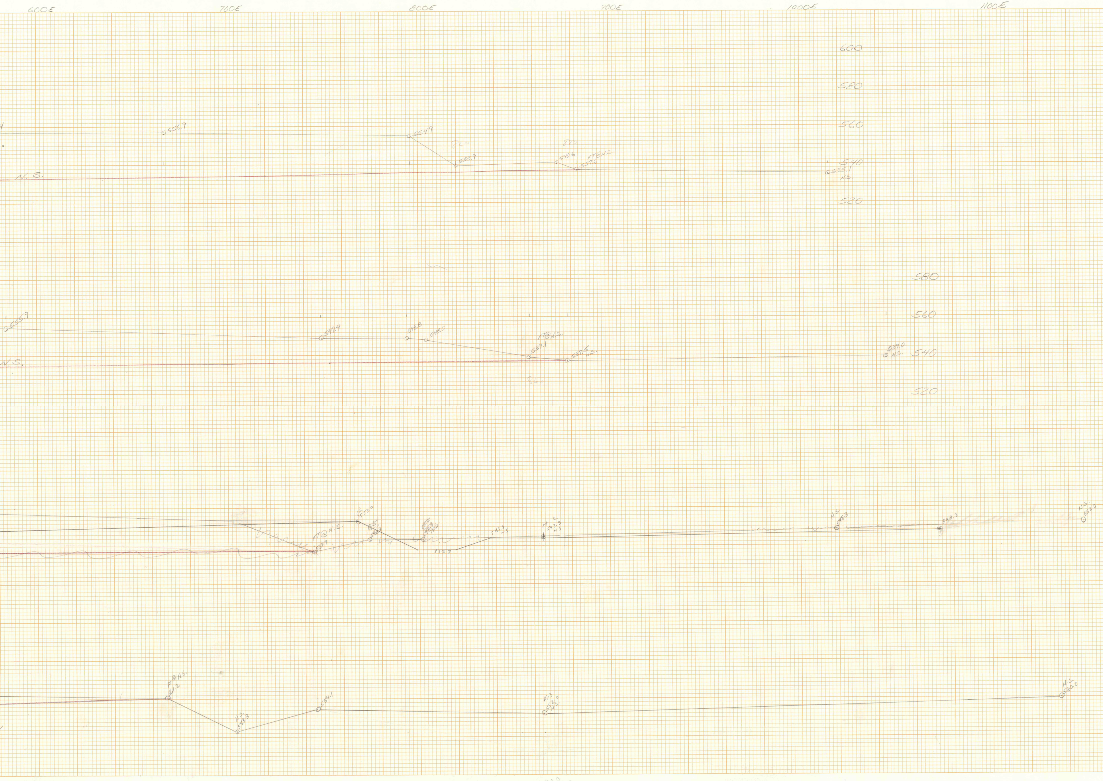

K+E 10 X 10 TO THE INCH
KEUFFEL & ESSER CO.
PRINTED IN U.S.A. 751001

900
900
810,000
40
32,400,000

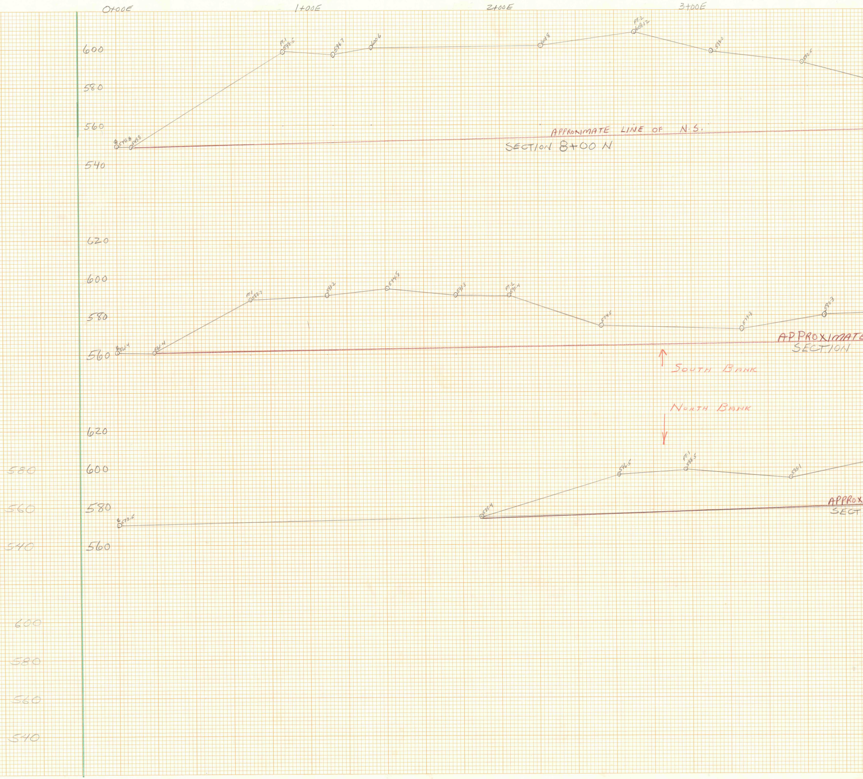

K+E 10 X 10 TO THE INCH
KEUFFEL & ESSER CO.
PRINTED IN U.S.A. 781001