



20-1

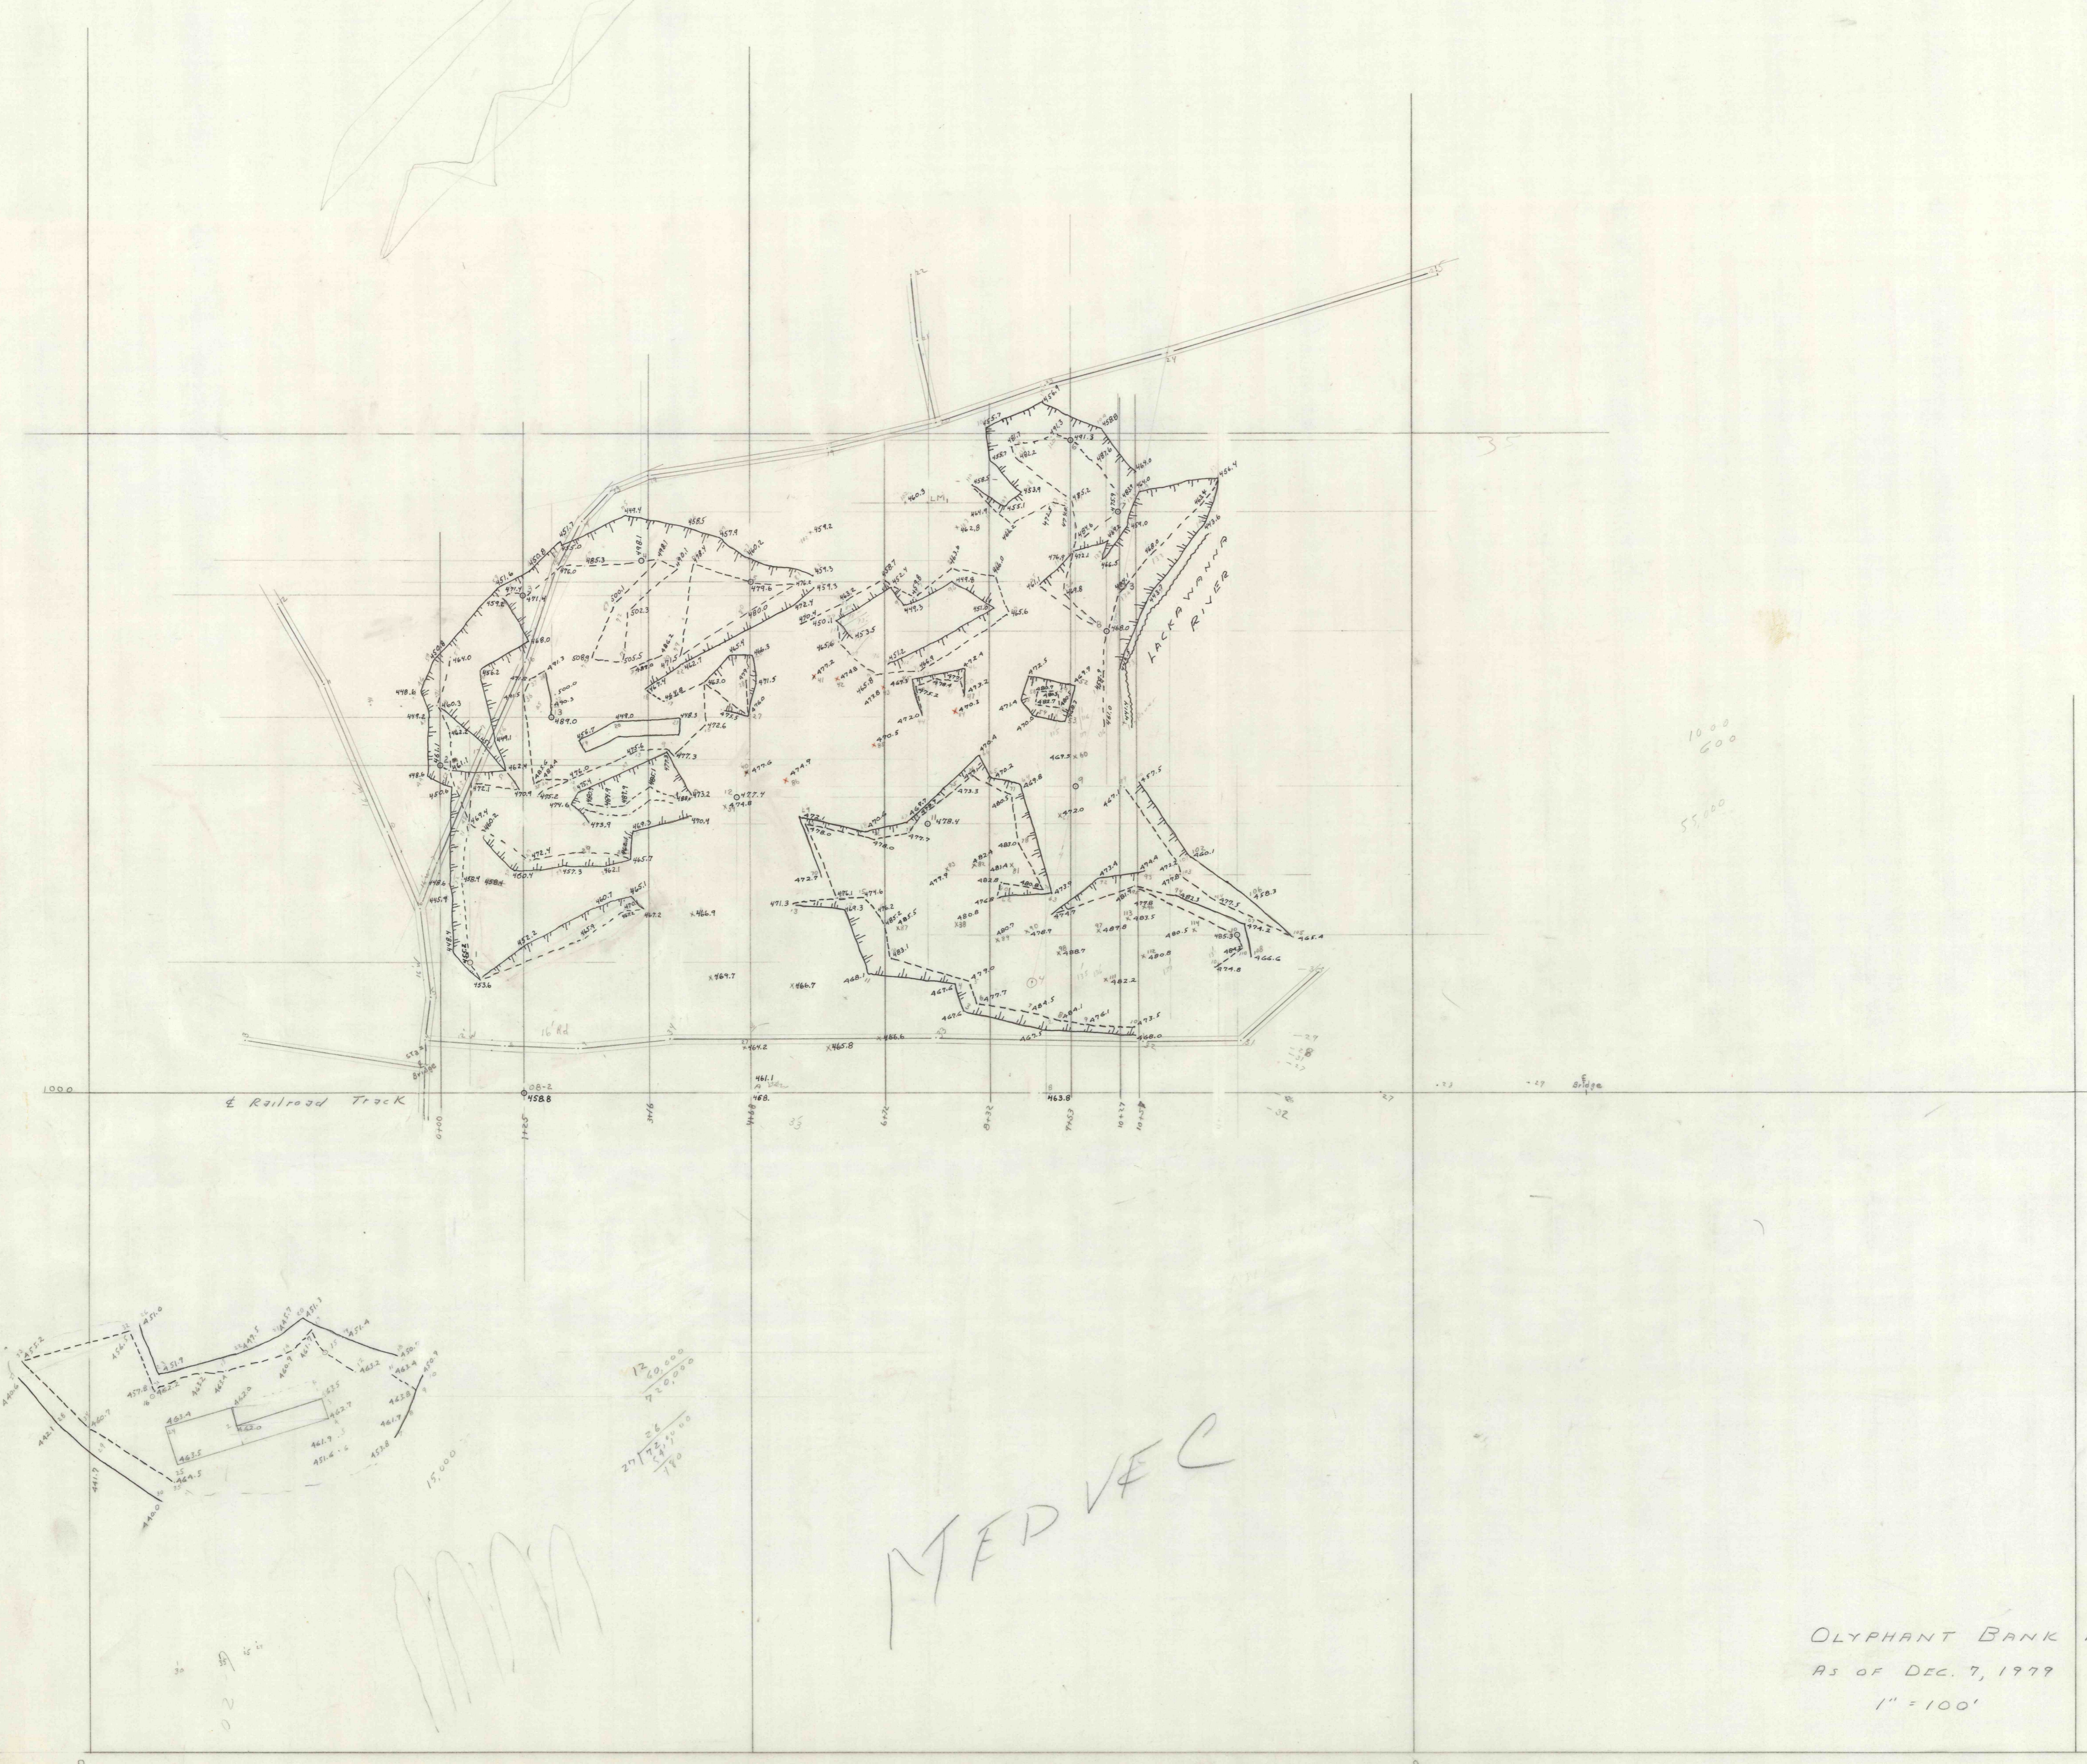

11
 10
 31
 41
 42
1000
 5000

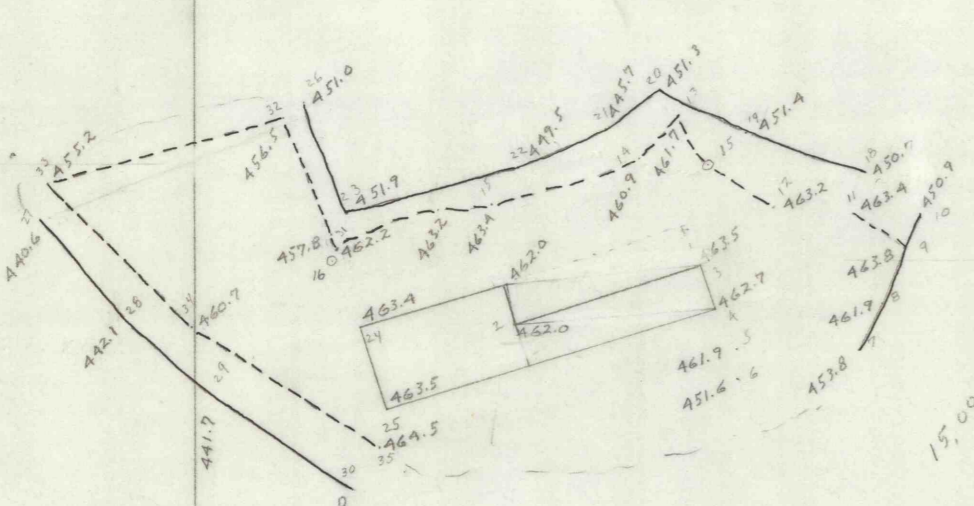

13,000
 12,000
 11,000
 10,000

MED VEC

OLYPHANT BANK No. 3
 AS OF DEC. 7, 1977
 1" = 100'