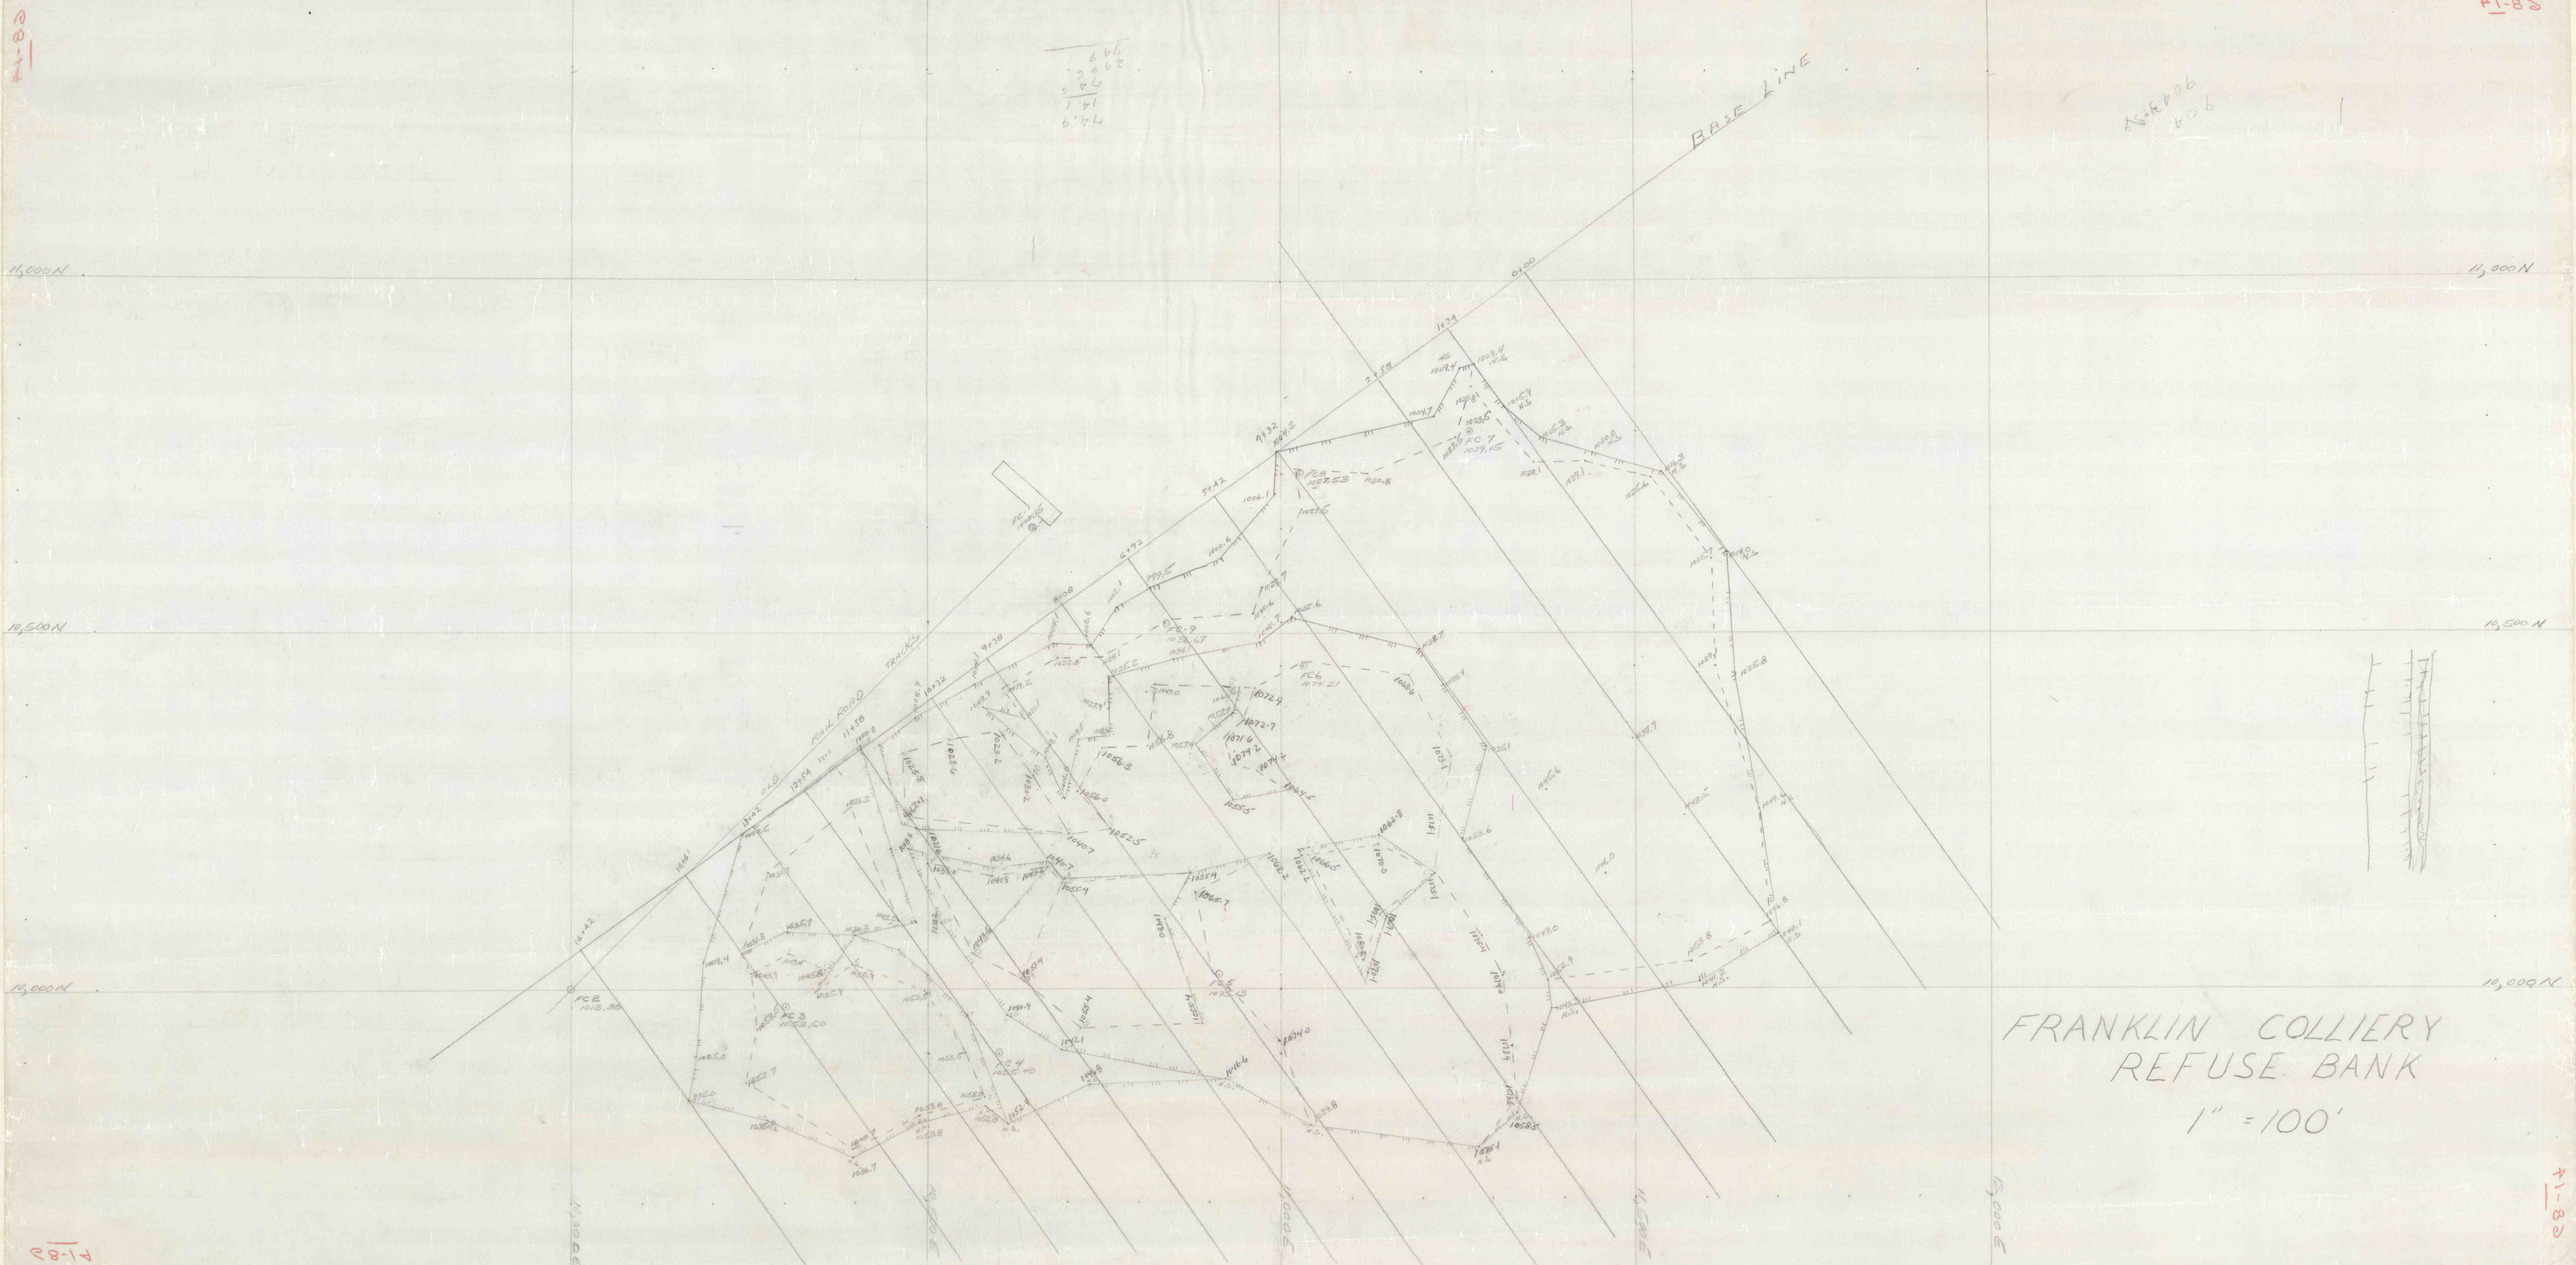
BASE LINE
11,000N
10,500N
10,000N
FRANKLIN COLLIERY
REFUSE BANK
1" = 100'