

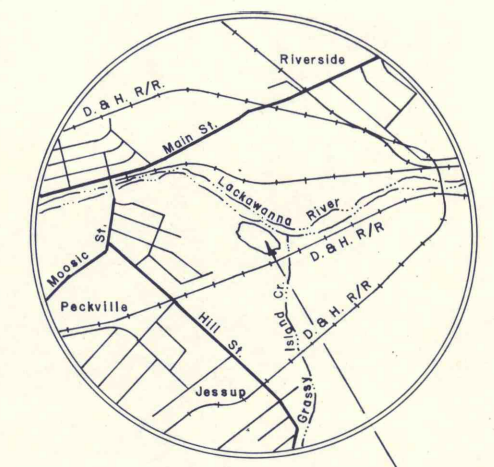


LOCATION MAP

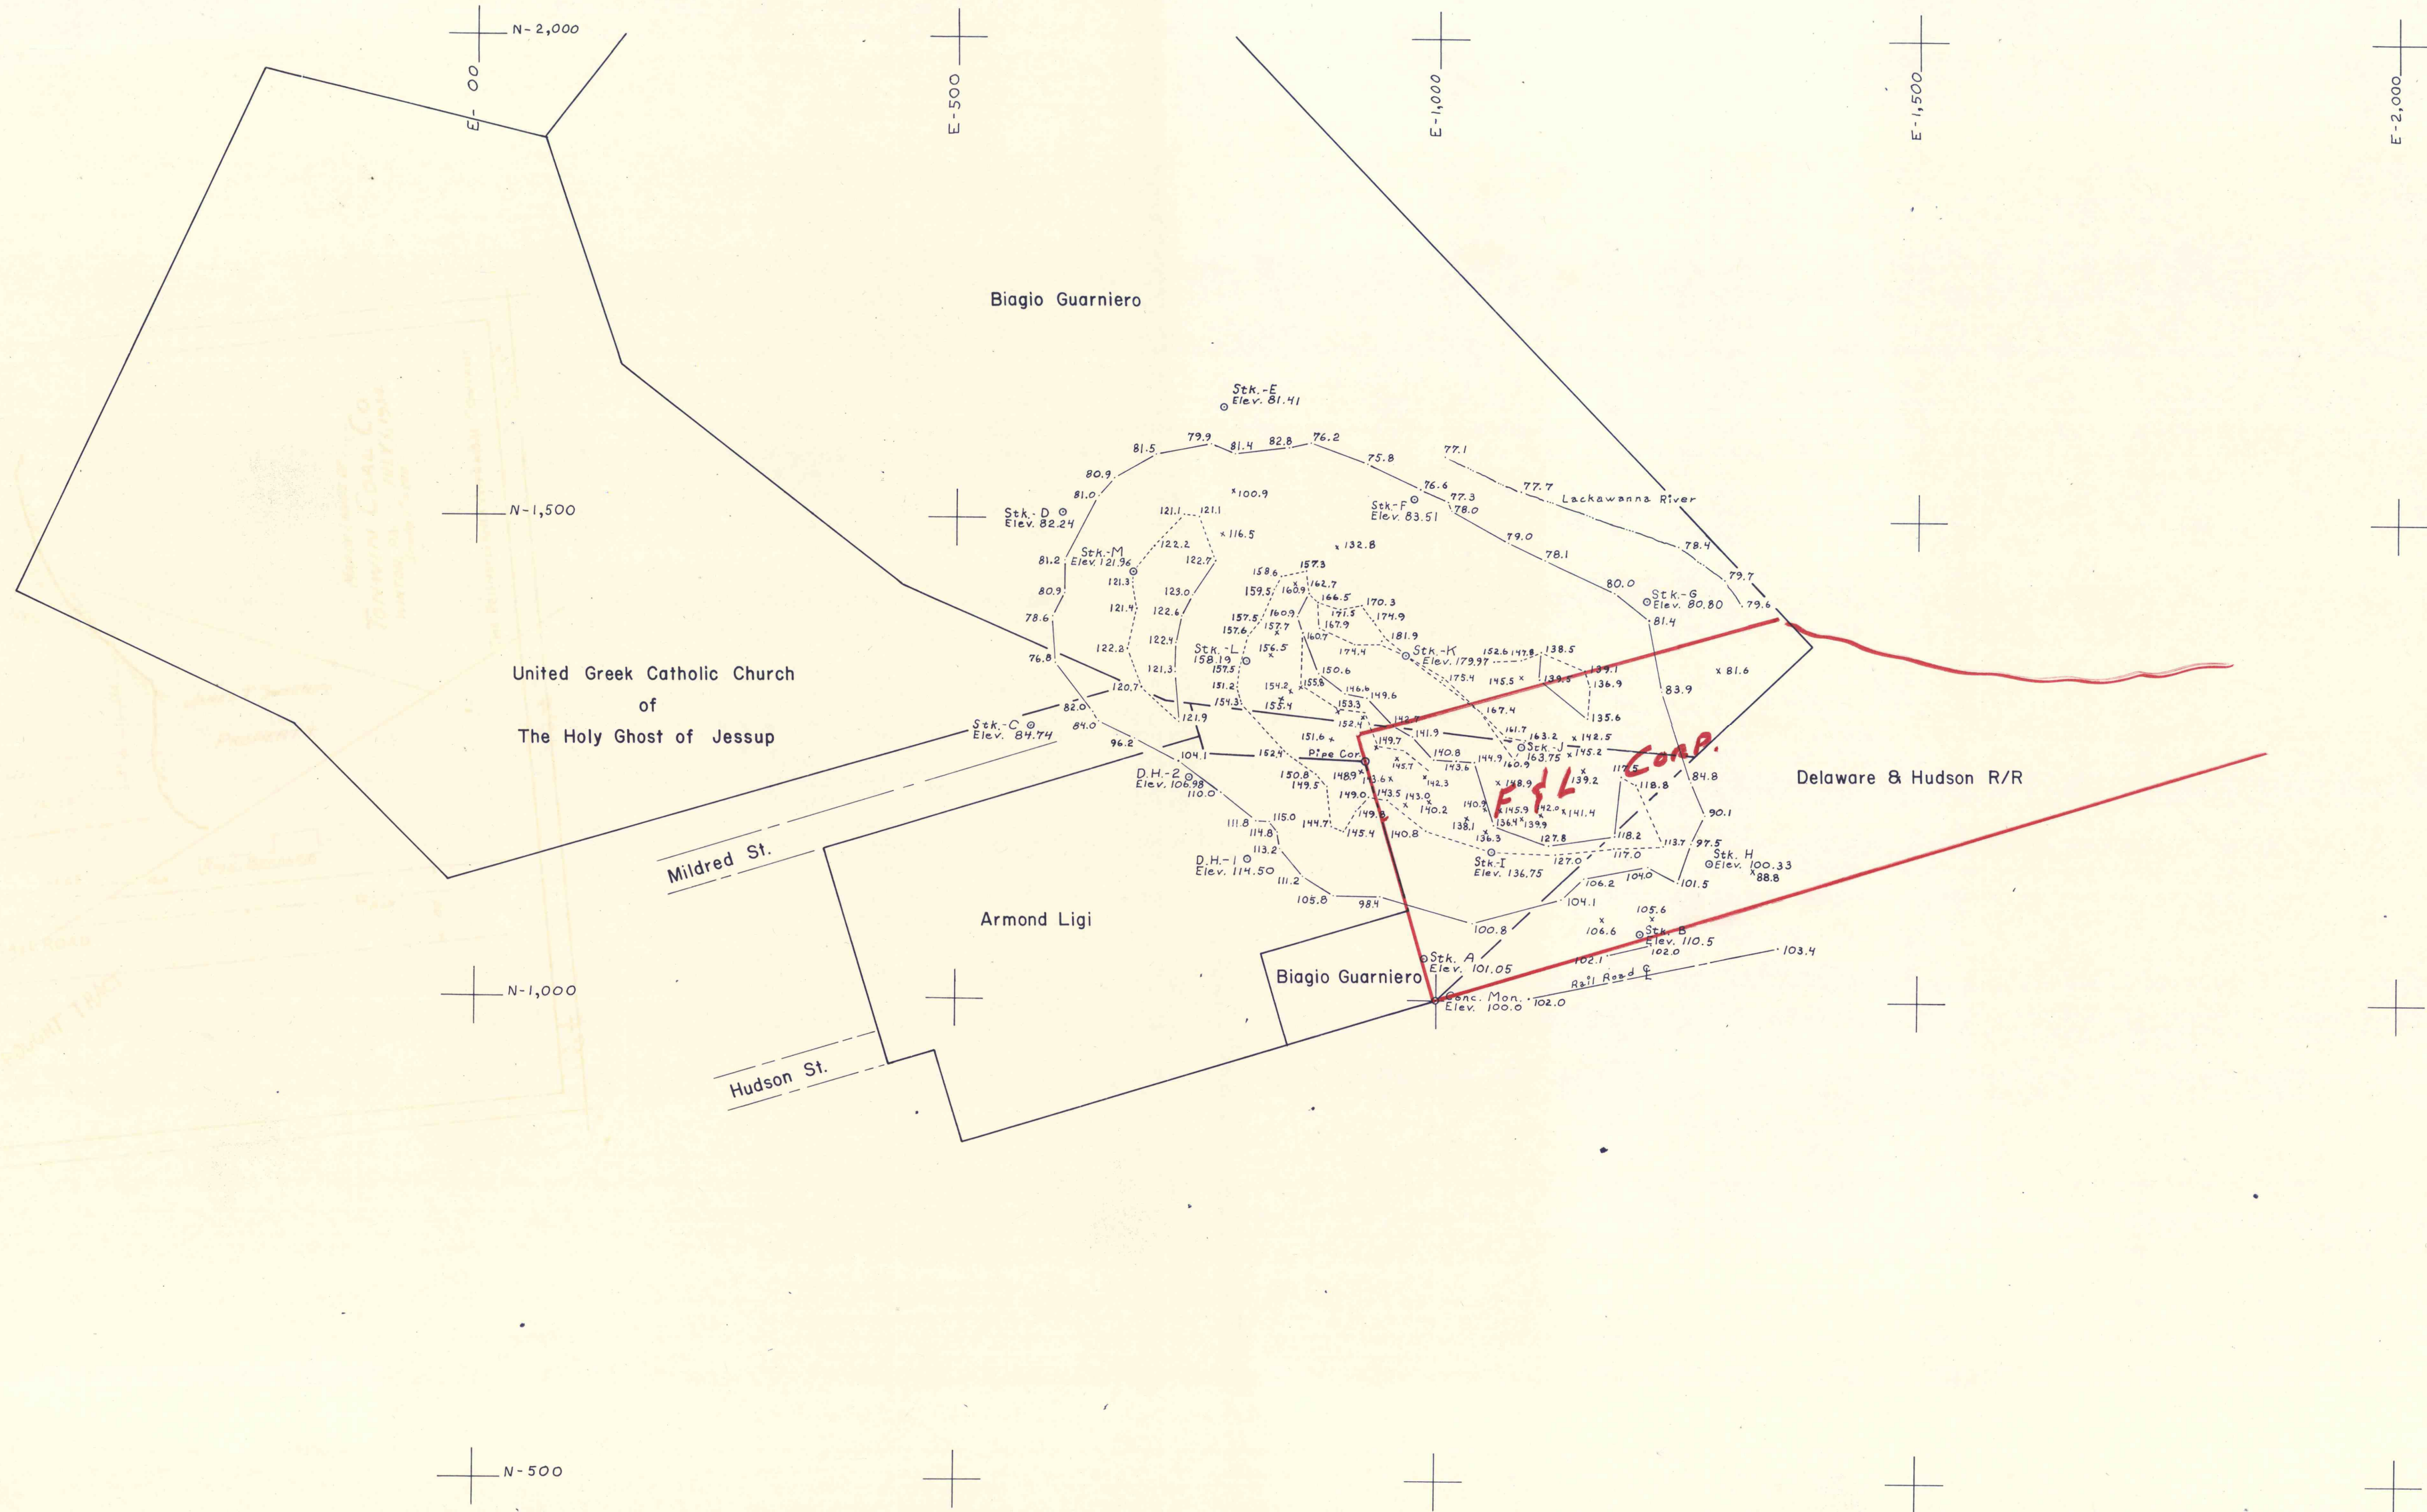

Jessup Refuse Bank
Scale 1 in. = 2,000 ft.

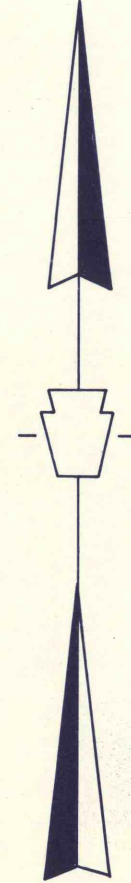

NO.	DATE	REVISION	APPR.
COMMONWEALTH OF PENNSYLVANIA DEPARTMENT OF ENVIRONMENTAL RESOURCES OFFICE OF RESOURCES MANAGEMENT			
JESSUP REFUSE BANK SURFACE			
Jessup Borough, Lackawanna County, Pa.			
299,577 C.Y.			
DRAWN BY	DATE	DRAWING NO.	
CHECKED BY	Jan. 14, 1981		
	SCALE		
	1 in. = 100 ft.		