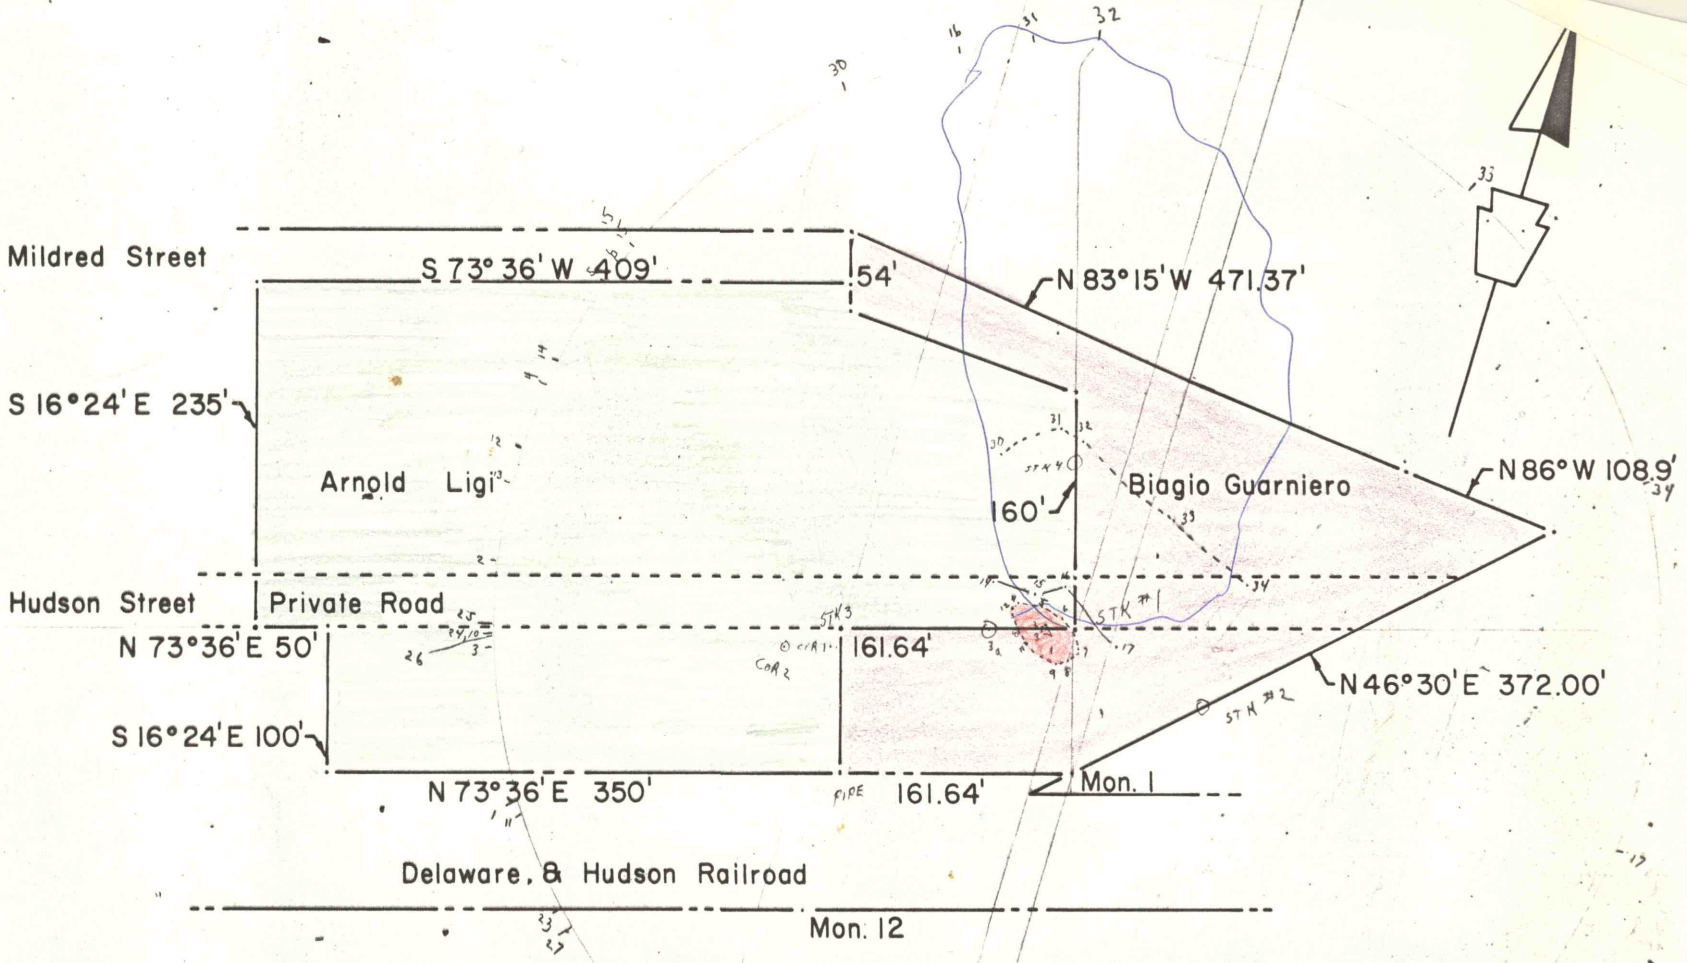

Scale 1 in. = 100 ft.
September 30, 1980

REFUSE BANK FIRE
SURFACE MAP
Hudson Street Area
Jessup Borough
Lackawanna Co., Penna.