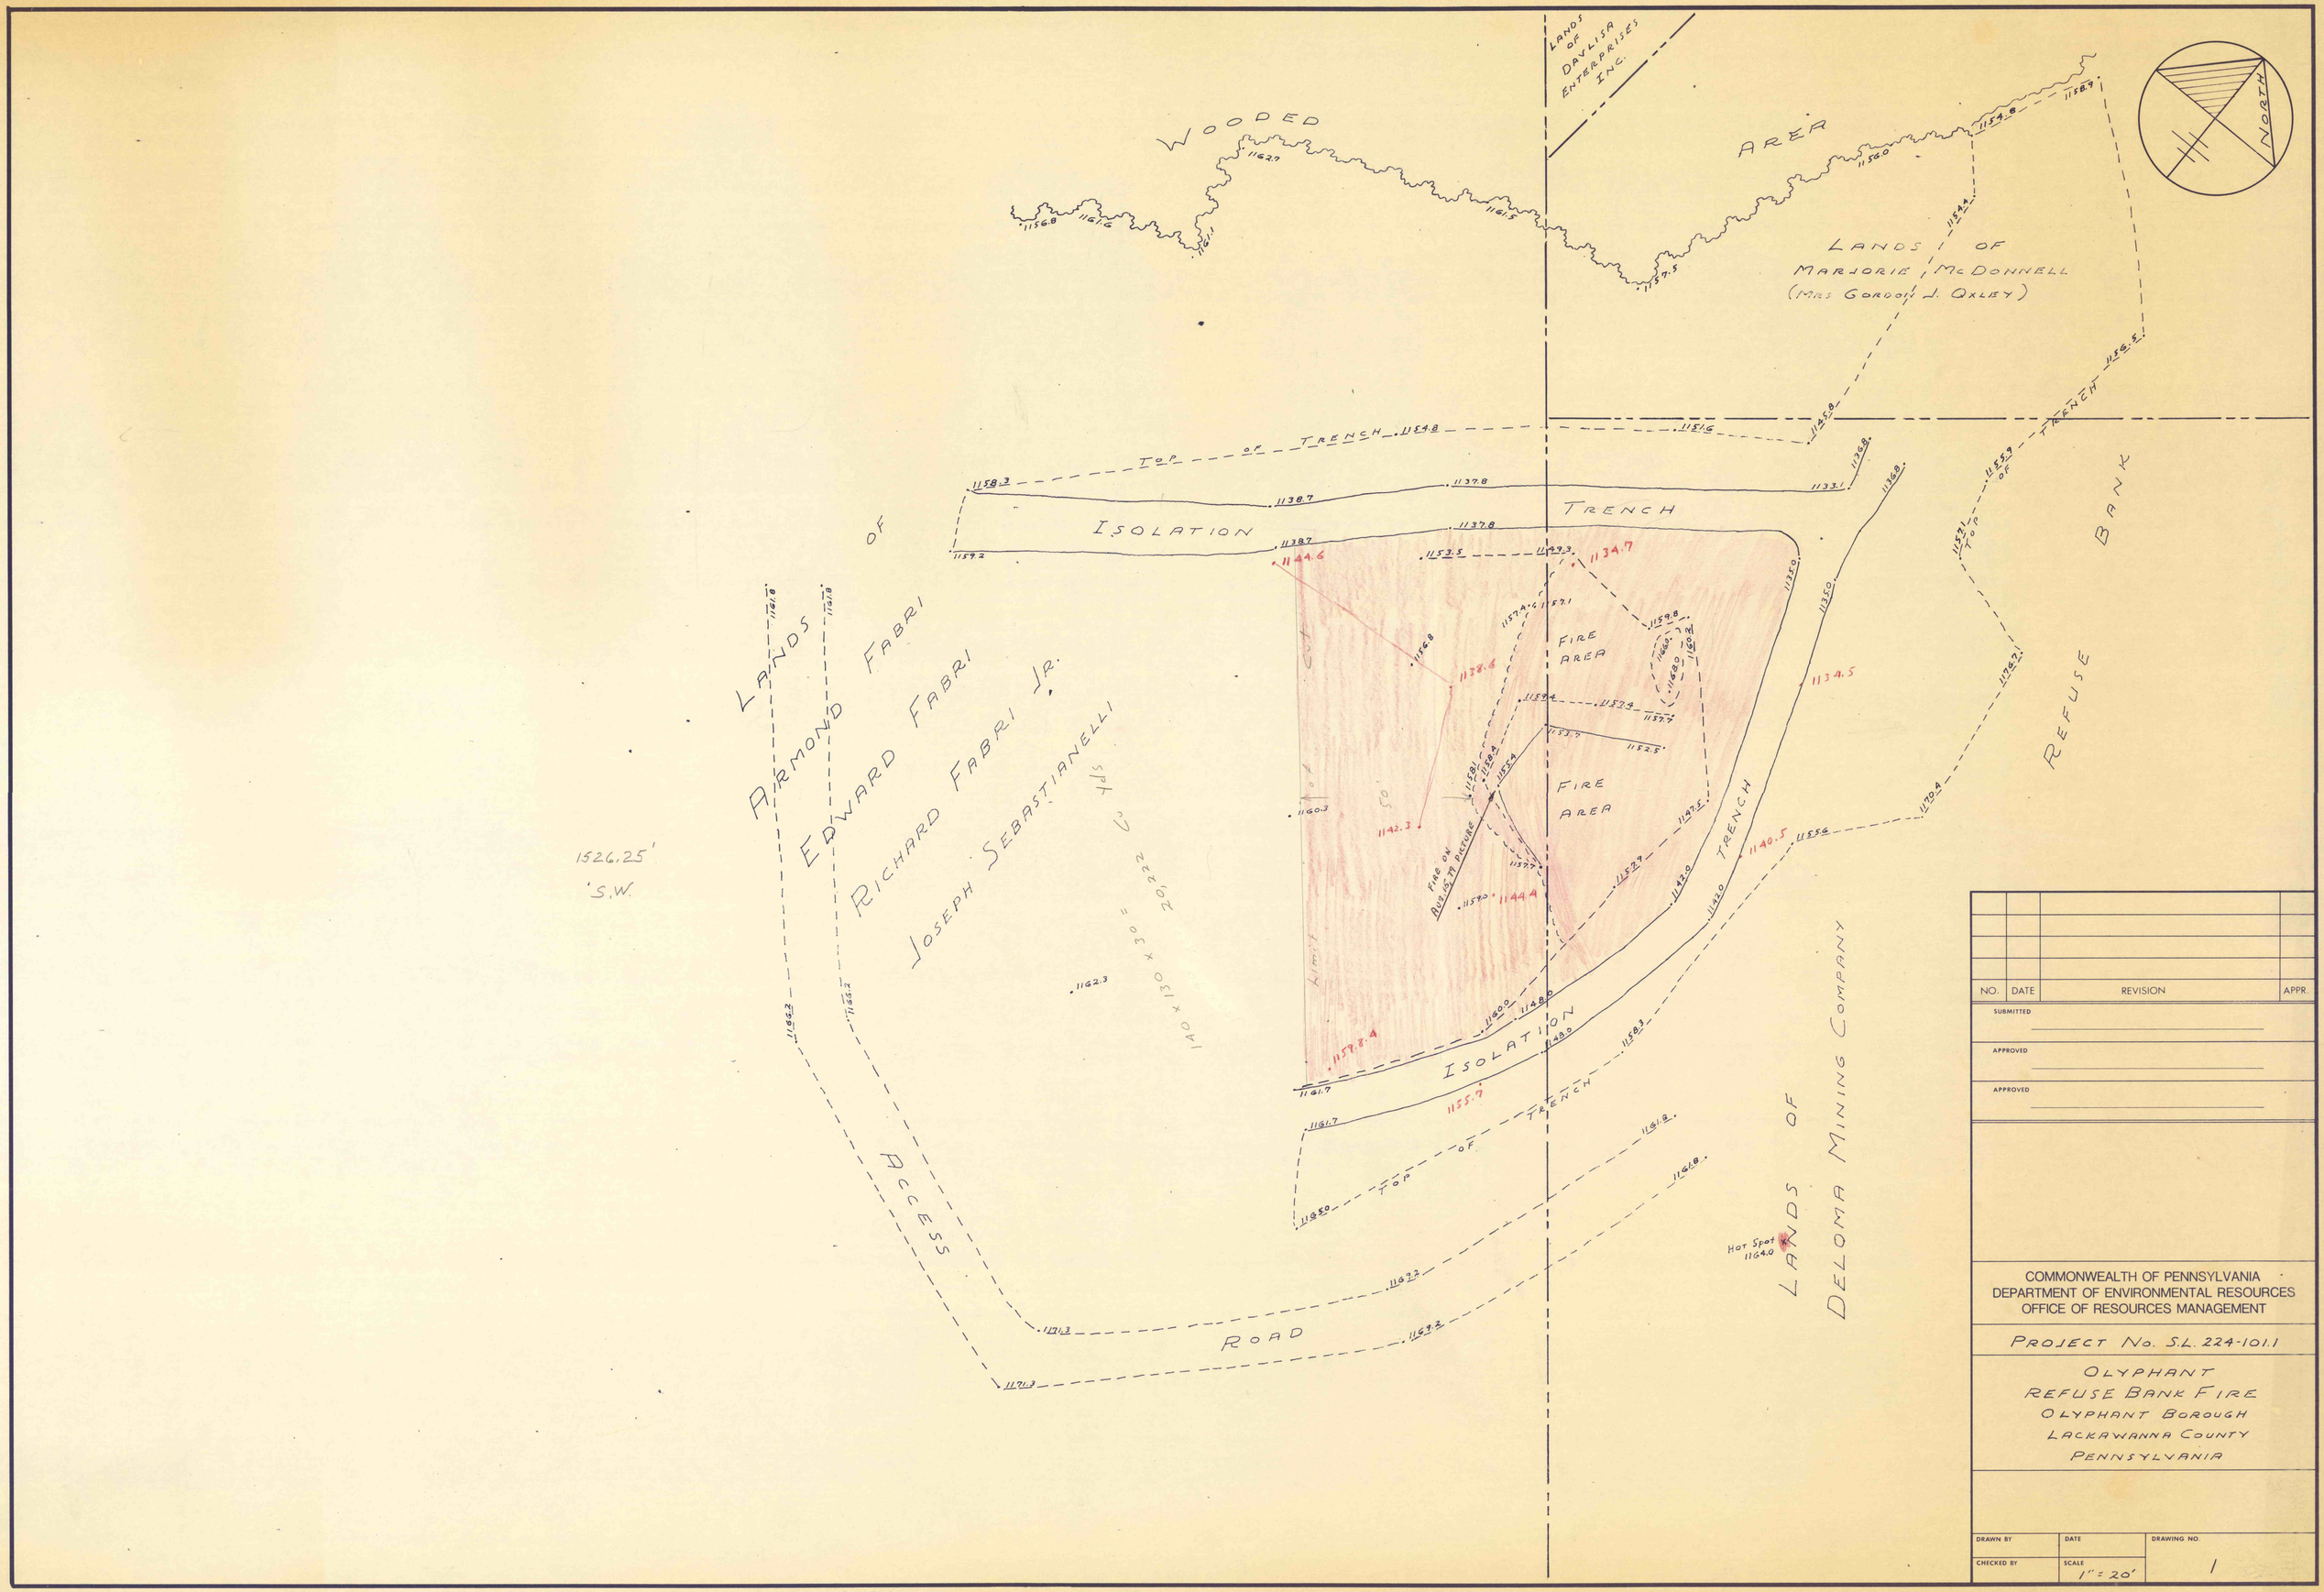

NO.	DATE	REVISION	APPR.

SUBMITTED

APPROVED

APPROVED

COMMONWEALTH OF PENNSYLVANIA
DEPARTMENT OF ENVIRONMENTAL RESOURCES
OFFICE OF RESOURCES MANAGEMENT

PROJECT No. S.L. 224-101.1

OLYPHANT
REFUSE BANK FIRE
OLYPHANT BOROUGH
LACKAWANNA COUNTY
PENNSYLVANIA

DRAWN BY	DATE	DRAWING NO.
CHECKED BY	SCALE 1" = 20'	1