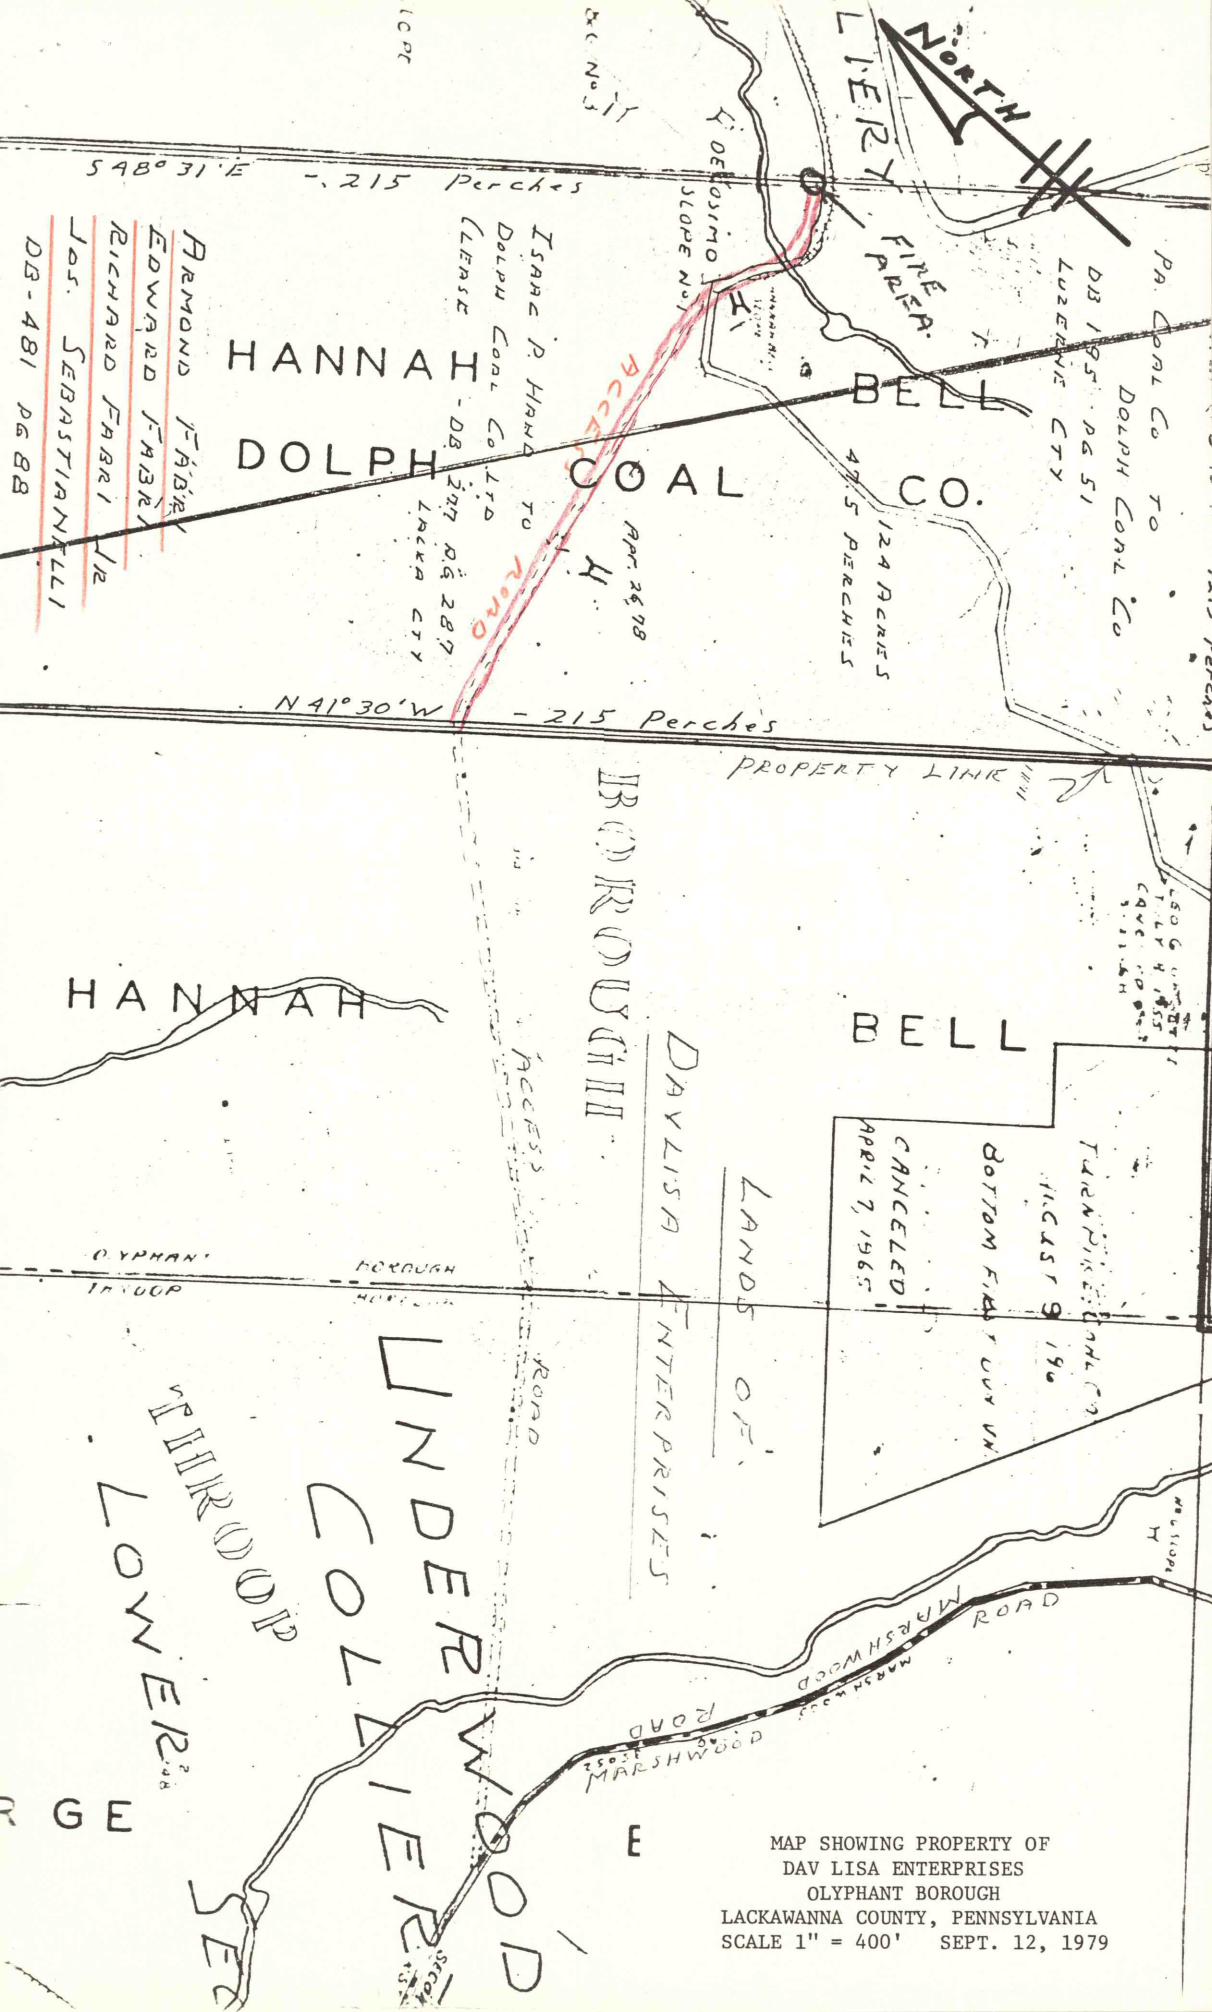

MAP SHOWING PROPERTY OF
DAV LISA ENTERPRISES
OLYPHANT BOROUGH
LACKAWANNA COUNTY, PENNSYLVANIA
SCALE 1" = 400' SEPT. 12, 1979