



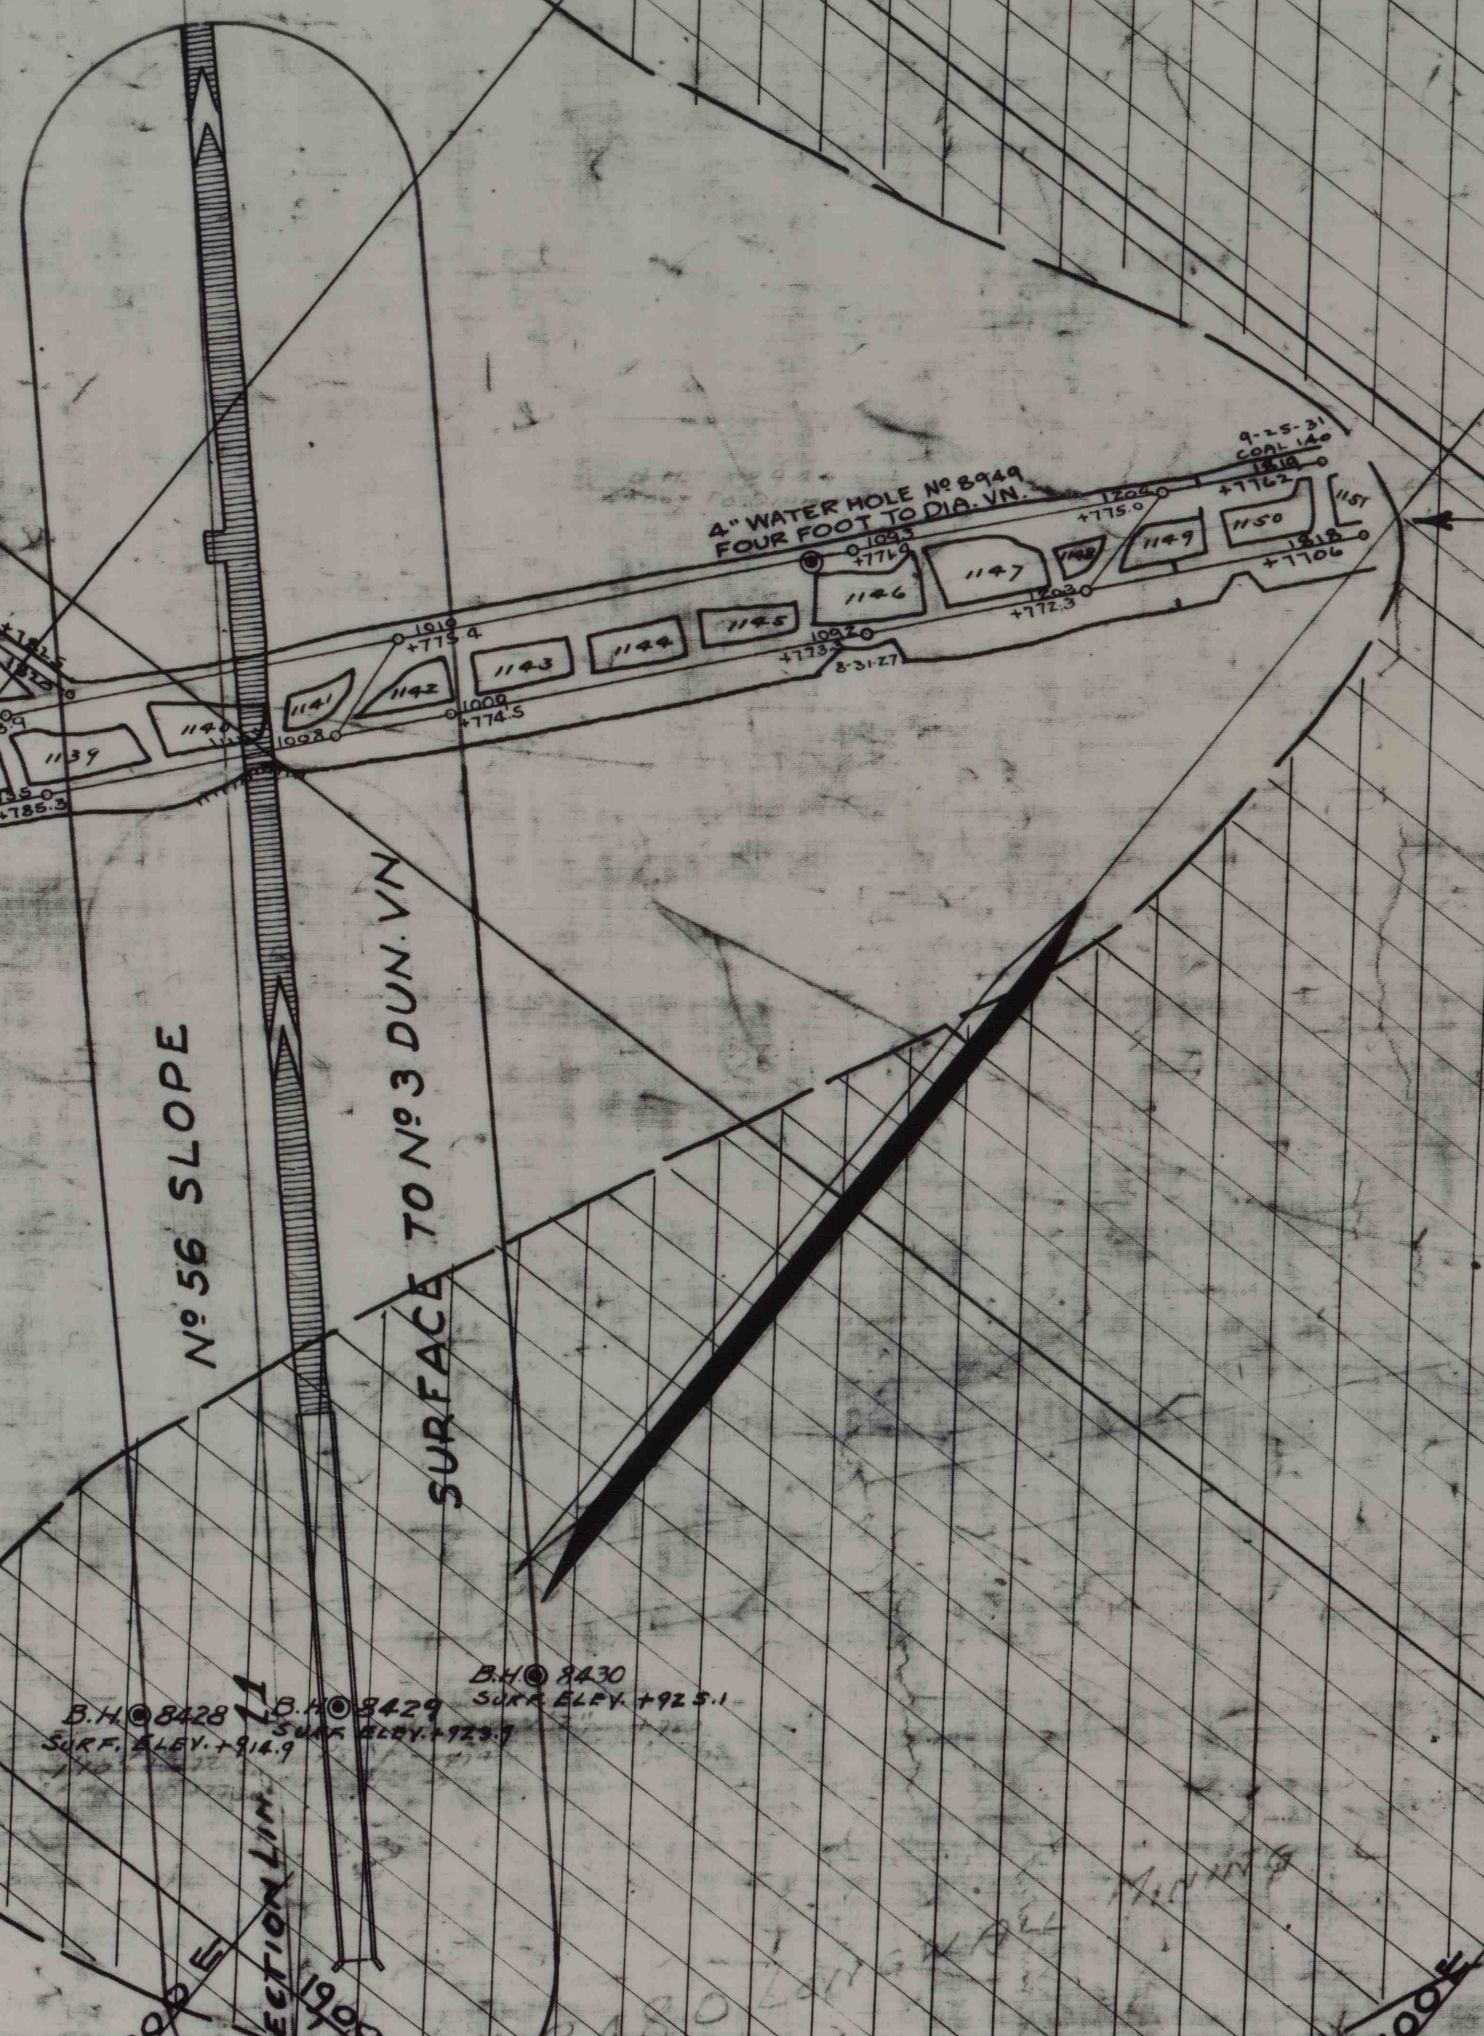

WAUGHN LANDS
IN FEE

TO ABANDON SEE AUTHORITY NO 12303

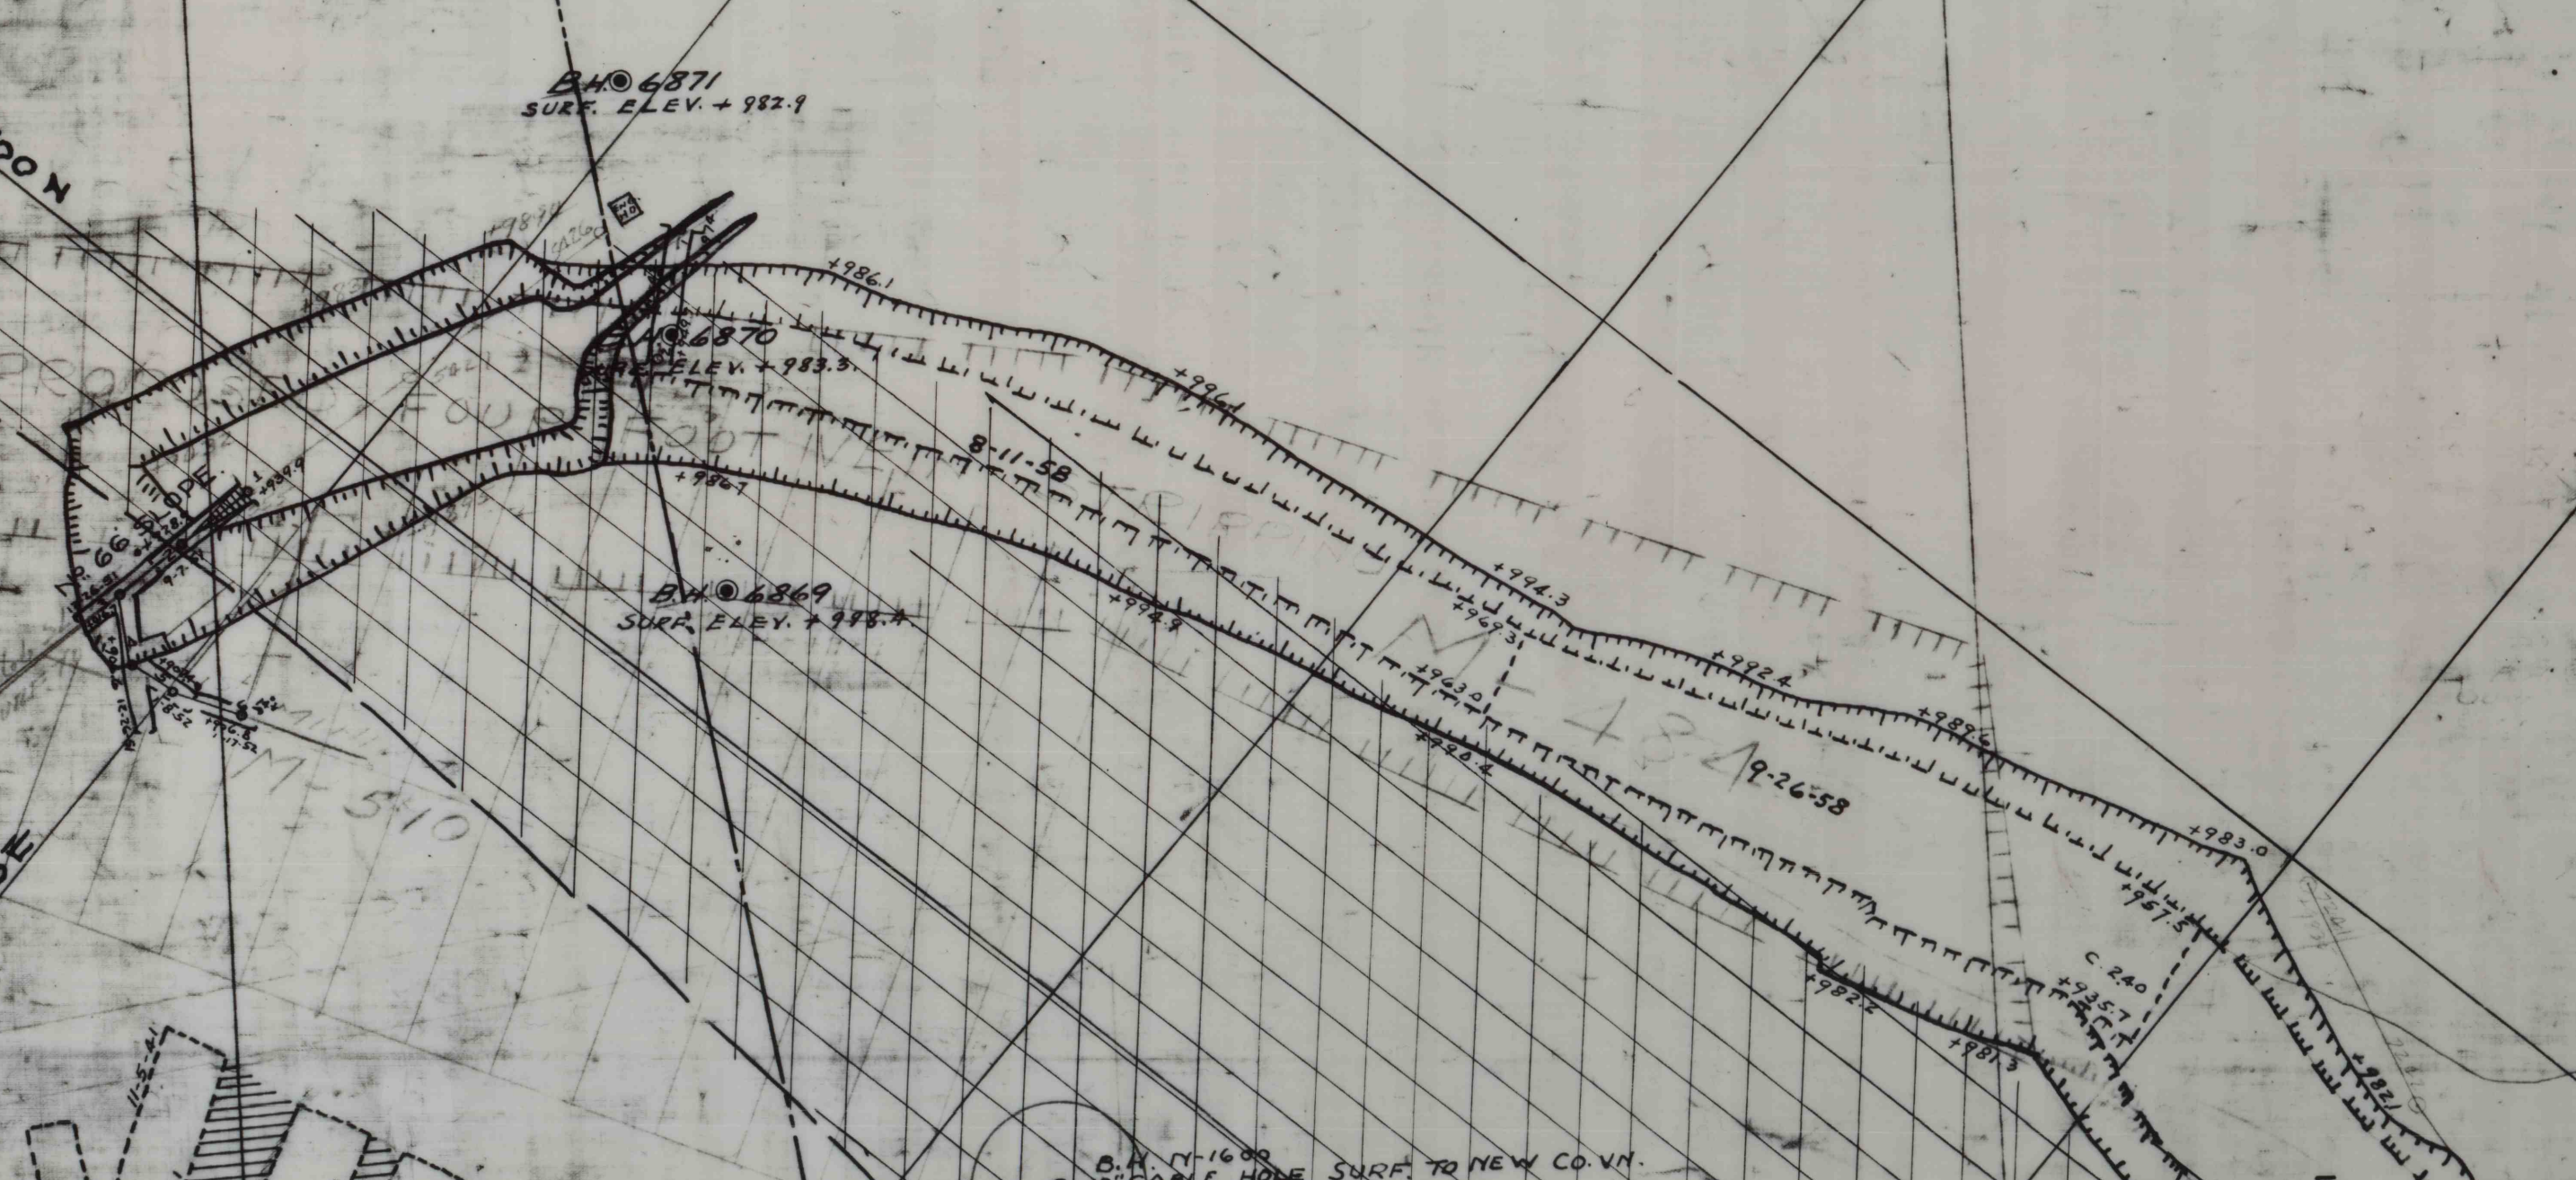

NOTIFIED
BEEN
HAS
INSPECTOR
MINE
UNTIL
LINE
THIS
SECOND
MINING
RID