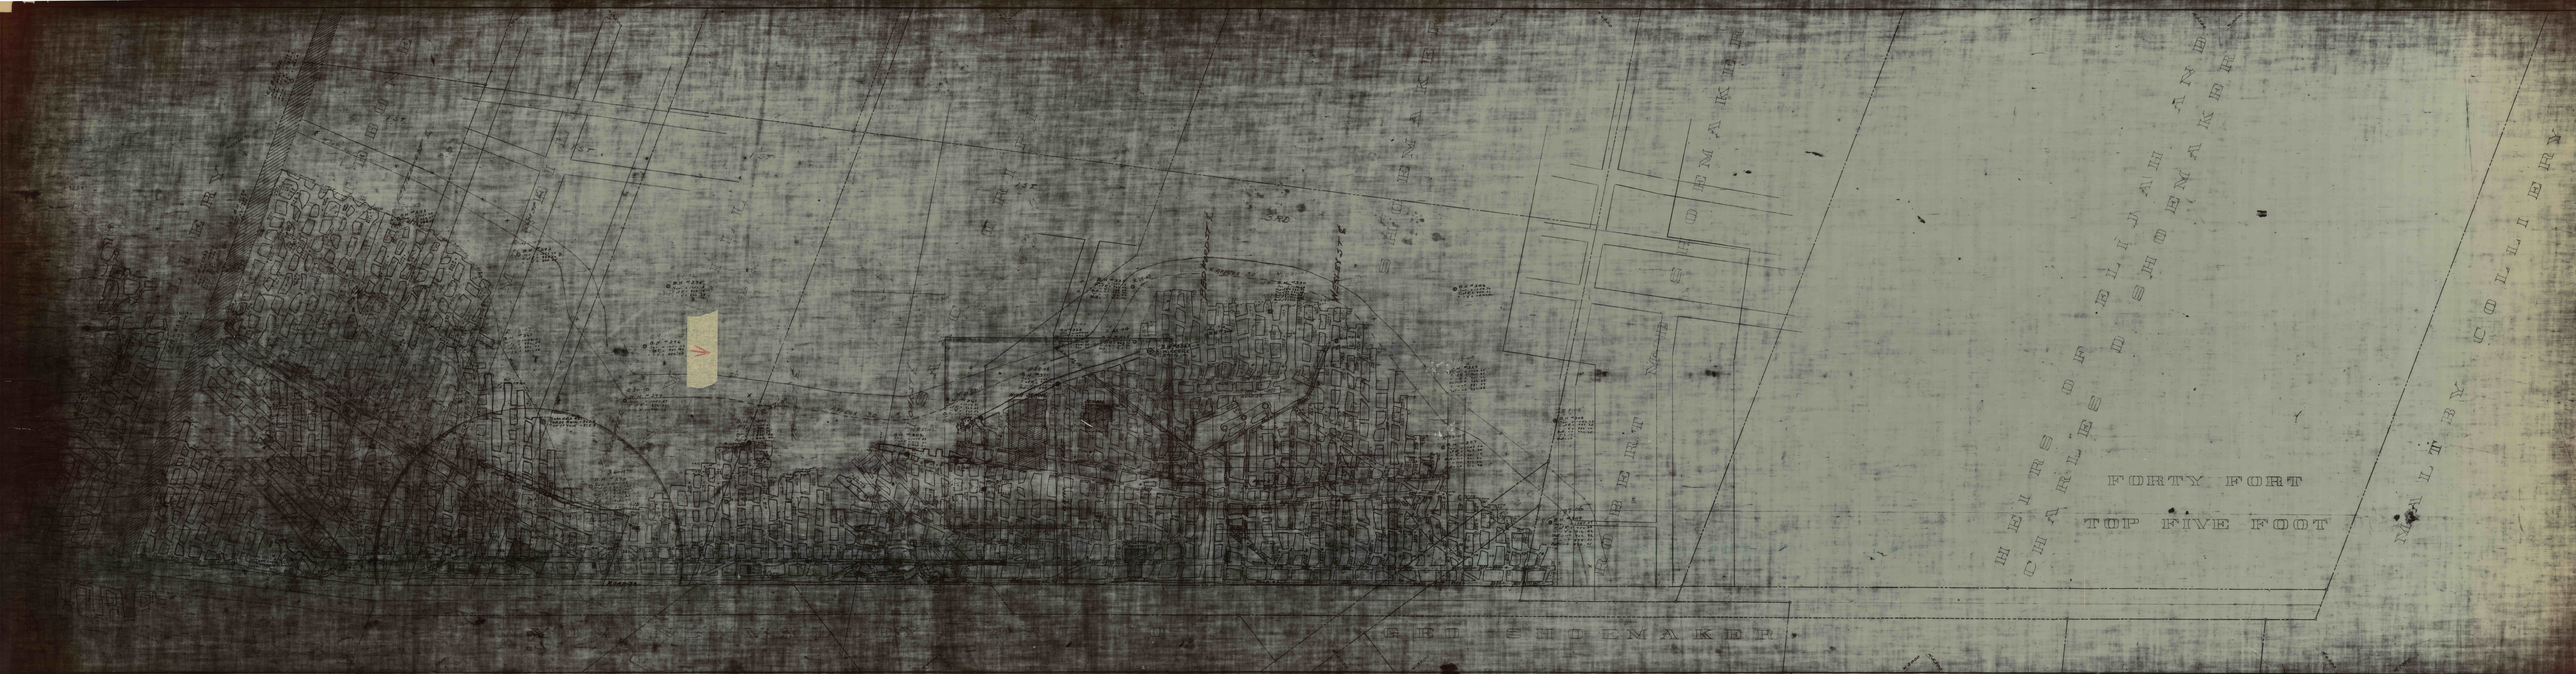
FORTY FORT
TOP FIVE FOOT
CHARLES D. ELIJAH SHOEMAKER
GEO. SHOEMAKER
ROBERT SHOEMAKER
WALTER COLLIERN