

30 FT. ROCK LIMIT



FIFTY-FORT BOTTOM FIVE FOOT VEIN

FIFTY-FORT BOTTOM FIVE FOOT VEIN

CHAS. DORRANCE

WYONING VALLEY COAL CO.

GEORGE SHOEMAKER

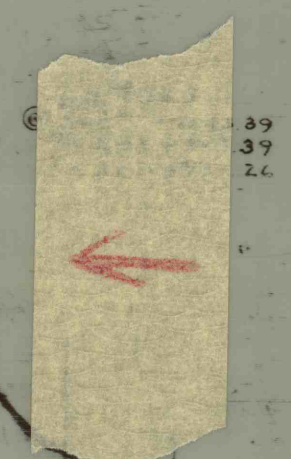

B.H. # 294  
Sur. 1026.10  
Top of Rock + 84.70  
B.M. 171 214.03




Bore Hole # 421  
Top of Rock + 502.2  
Top of Vein + 501.6








APPROX. 30'

APPROX. 30'

1-ST

1-ST

1-ST

751.19  
705.23

39  
37  
35

39  
37  
35