


NORTH  
 CROSS SECTION TAIL HARRY & RAUB COAL COMPANY PROPERTIES  
 ON LINE BETWEEN GEO. PACK & EDWIN McNEIL  
 20 FEET WEST OF SHAFT  
 SCALE 1" = 100'

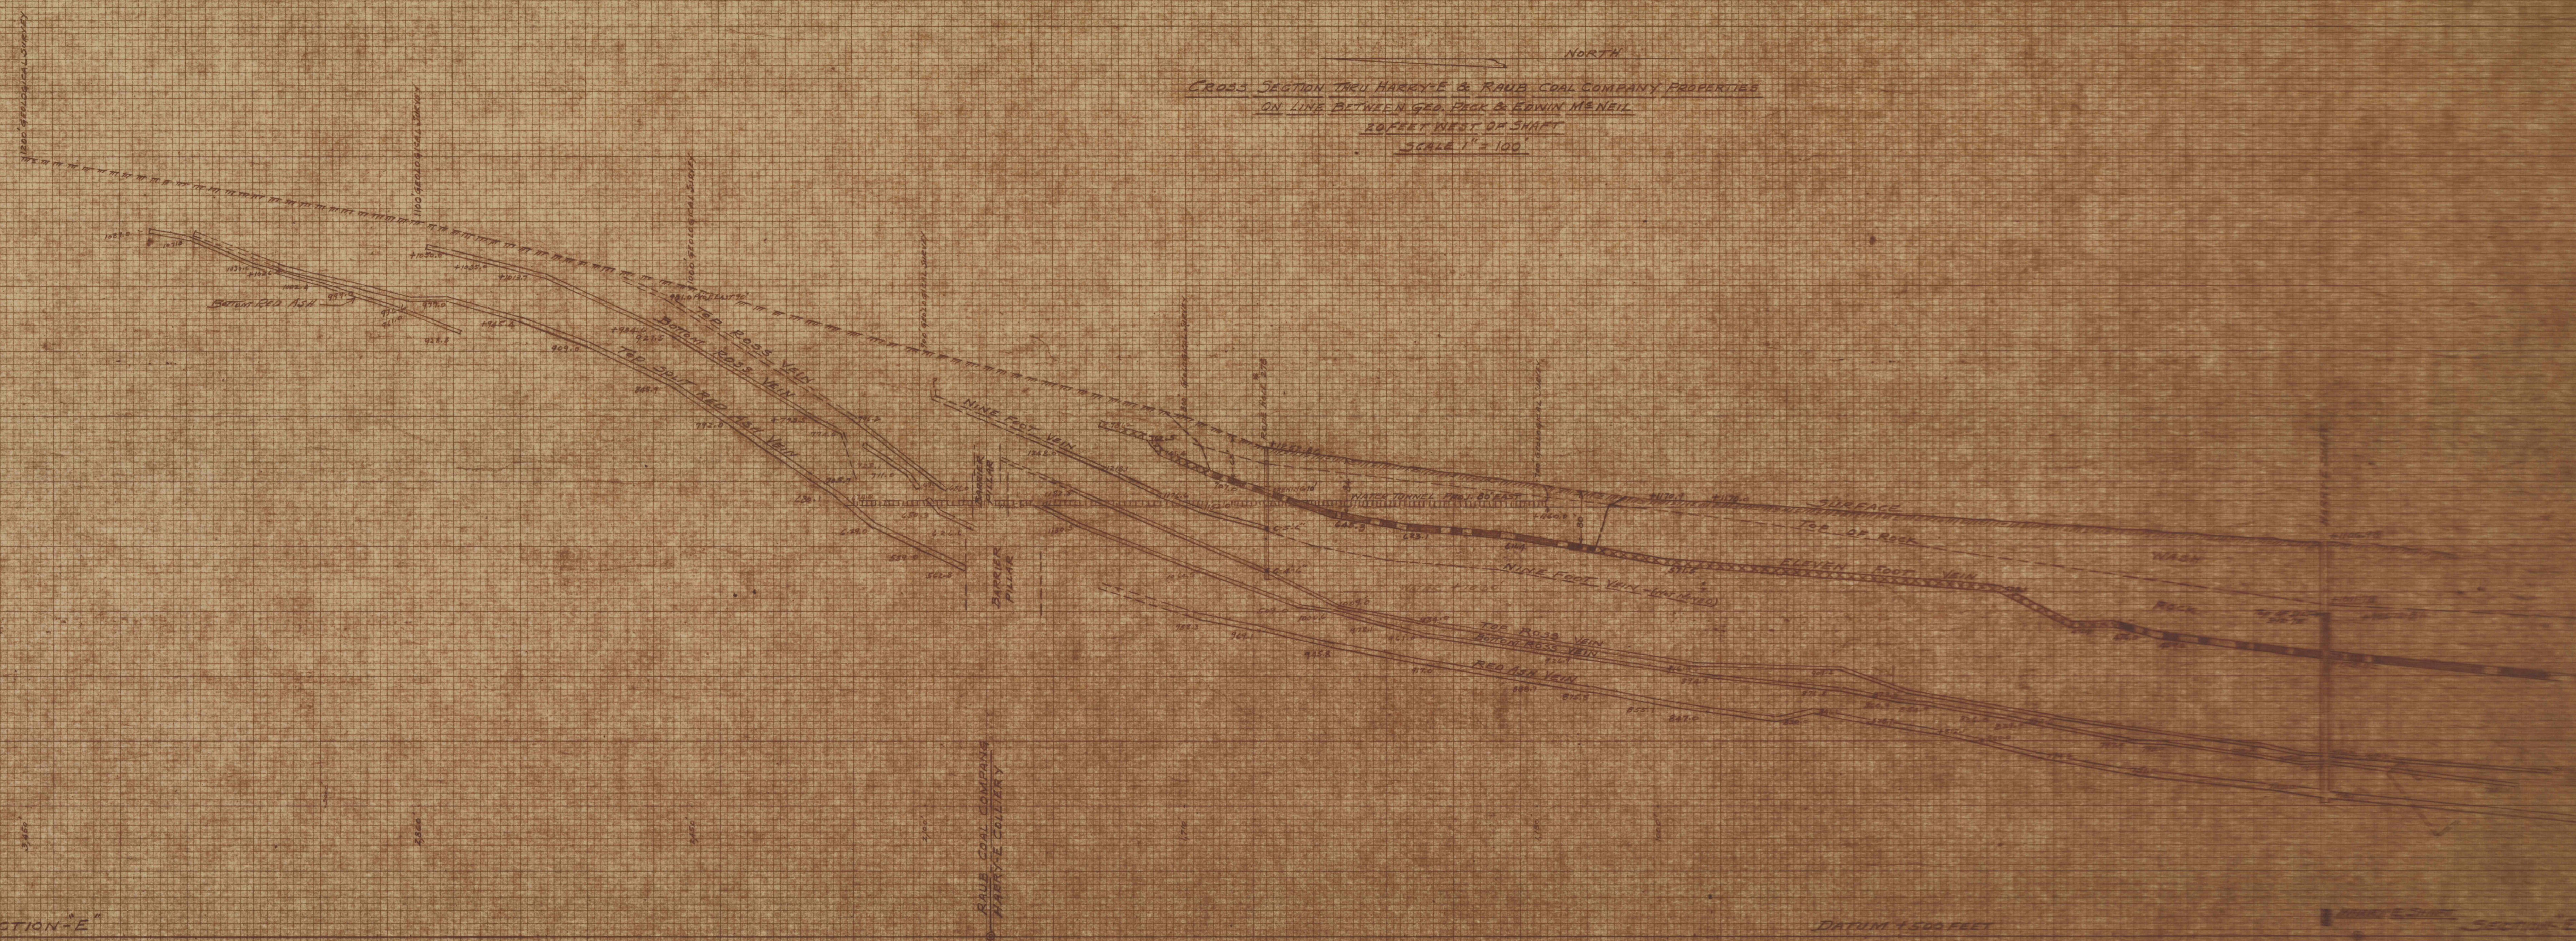

SECTION-E

DATUM 1500 FEET

RAUB COAL COMPANY  
 HARRY & EDWIN