


CROSS SECTION No. 1  
 Showing Veins on Line between  
 Edwin McNeill & Geo. Peck Property  
 Harry E. Colliery  
 Scale - 1 in. = 100 ft.  
 LOOKING EAST

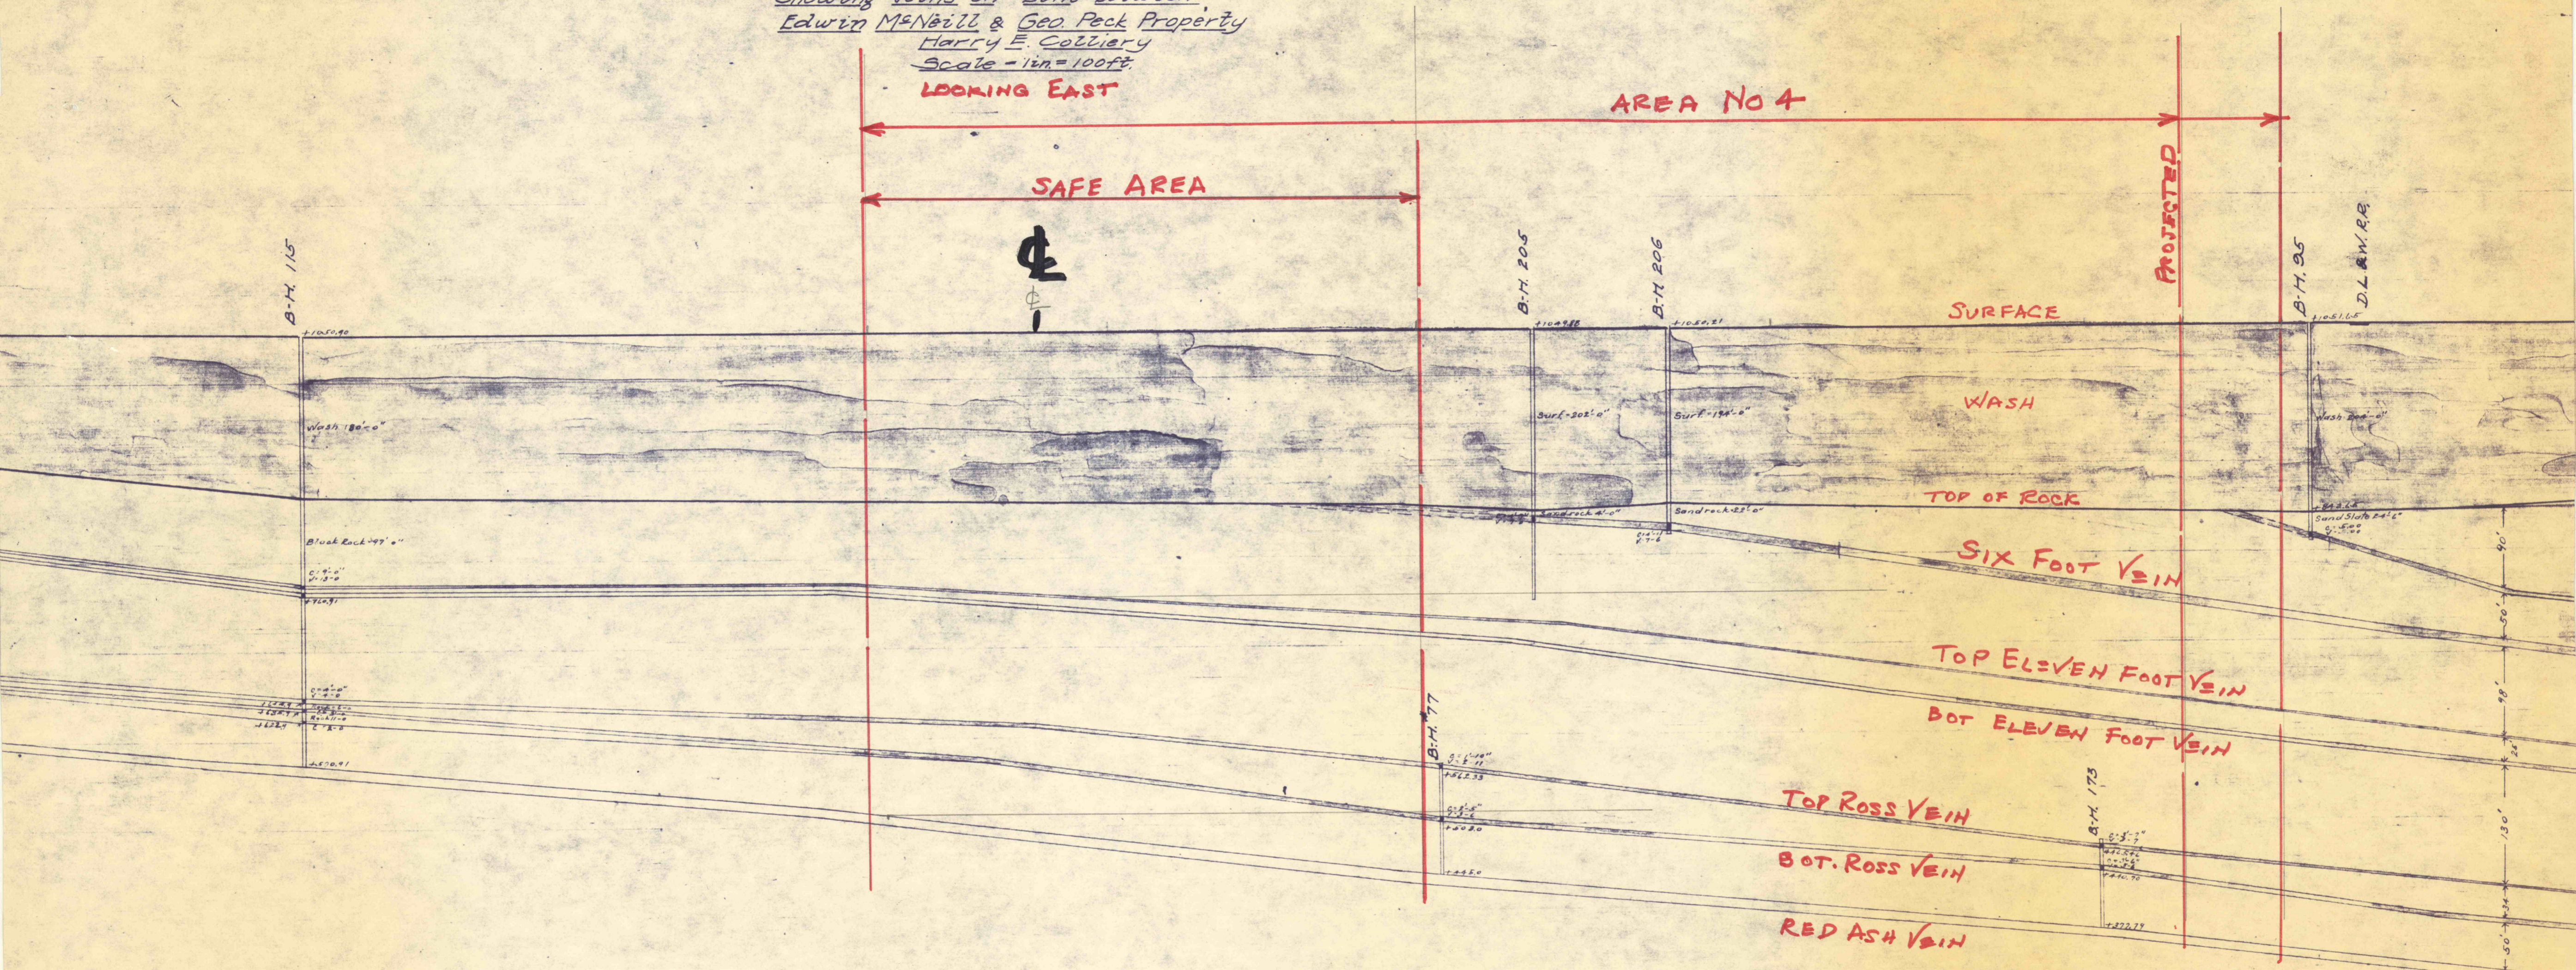

X-SECT. LINE 1

1" = 100'