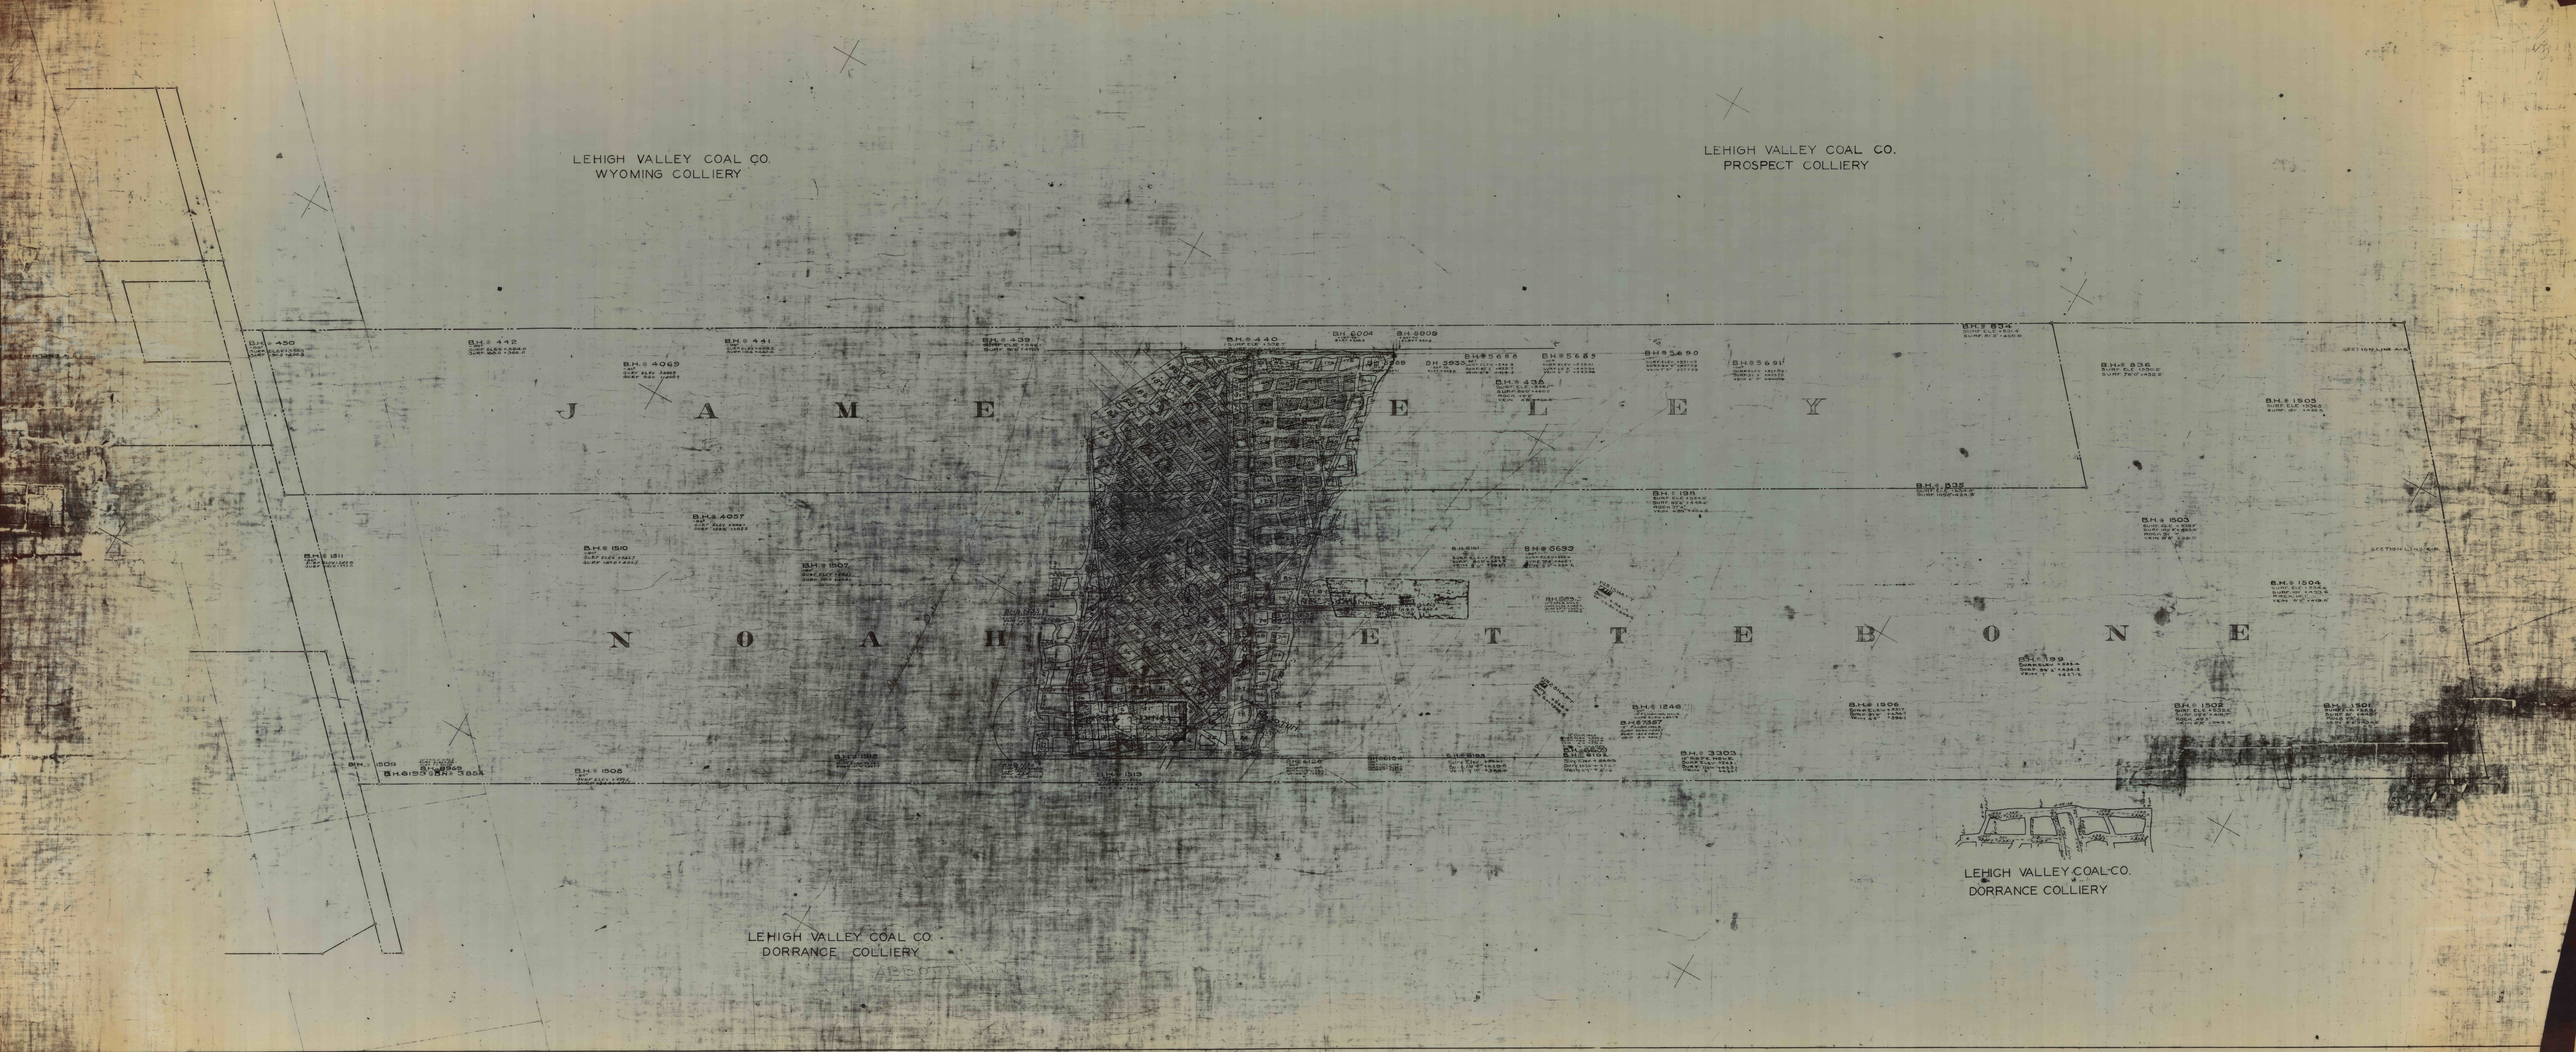
LEHIGH VALLEY COAL CO.
WYOMING COLLIERY
LEHIGH VALLEY COAL CO.
PROSPECT COLLIERY
J A M E S
E L E Y
N O A H
E T T E B O N E
LEHIGH VALLEY COAL CO.
DORRANCE COLLIERY
LEHIGH VALLEY COAL CO.
DORRANCE COLLIERY