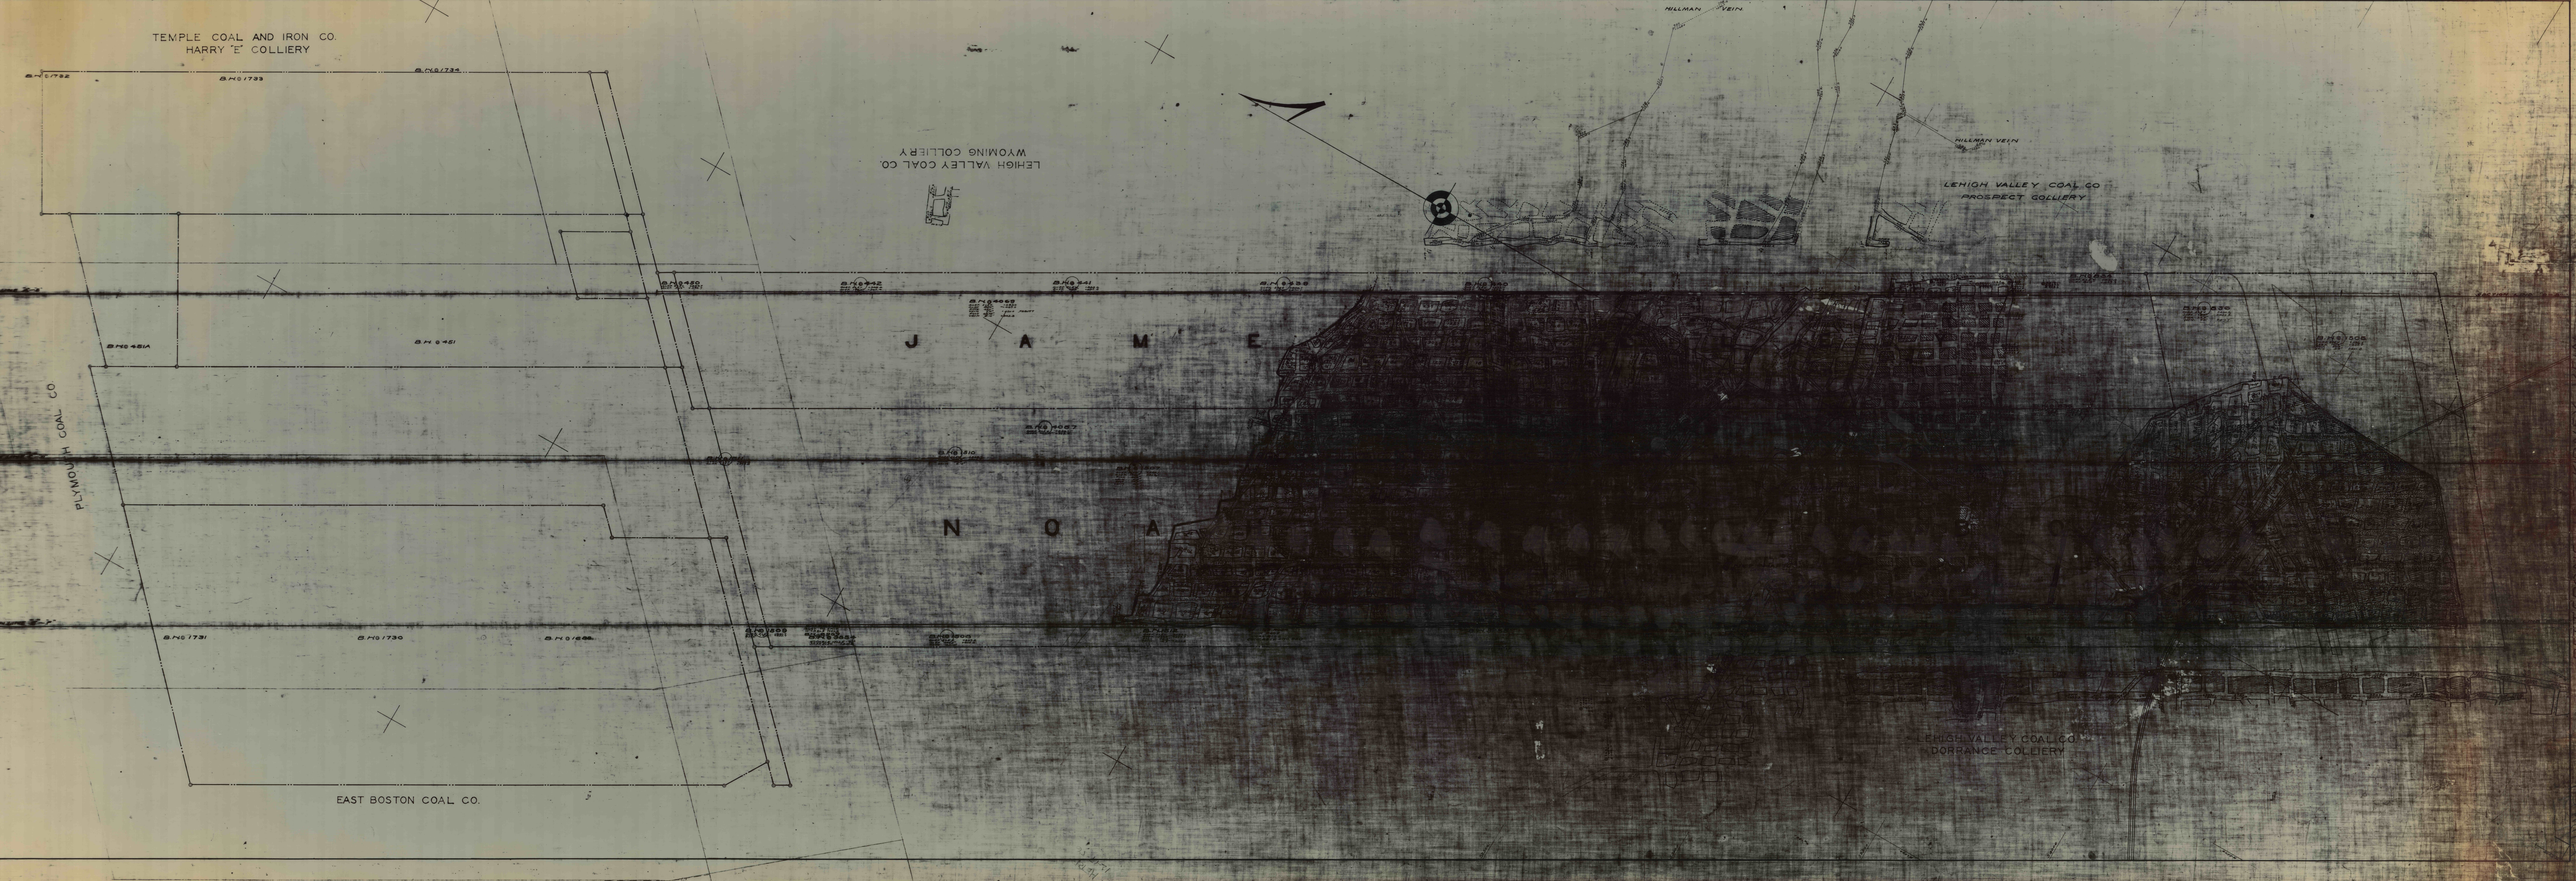
TEMPLE COAL AND IRON CO.
HARRY 'E' COLLIERY
LEHIGH VALLEY COAL CO.
WYOMING COLLIERY
HILLMAN VEIN
HILLMAN VEIN
LEHIGH VALLEY COAL CO
PROSPECT COLLIERY
PLYMOUTH COAL CO
EAST BOSTON COAL CO.
LEHIGH VALLEY COAL CO
DORRANCE COLLIERY