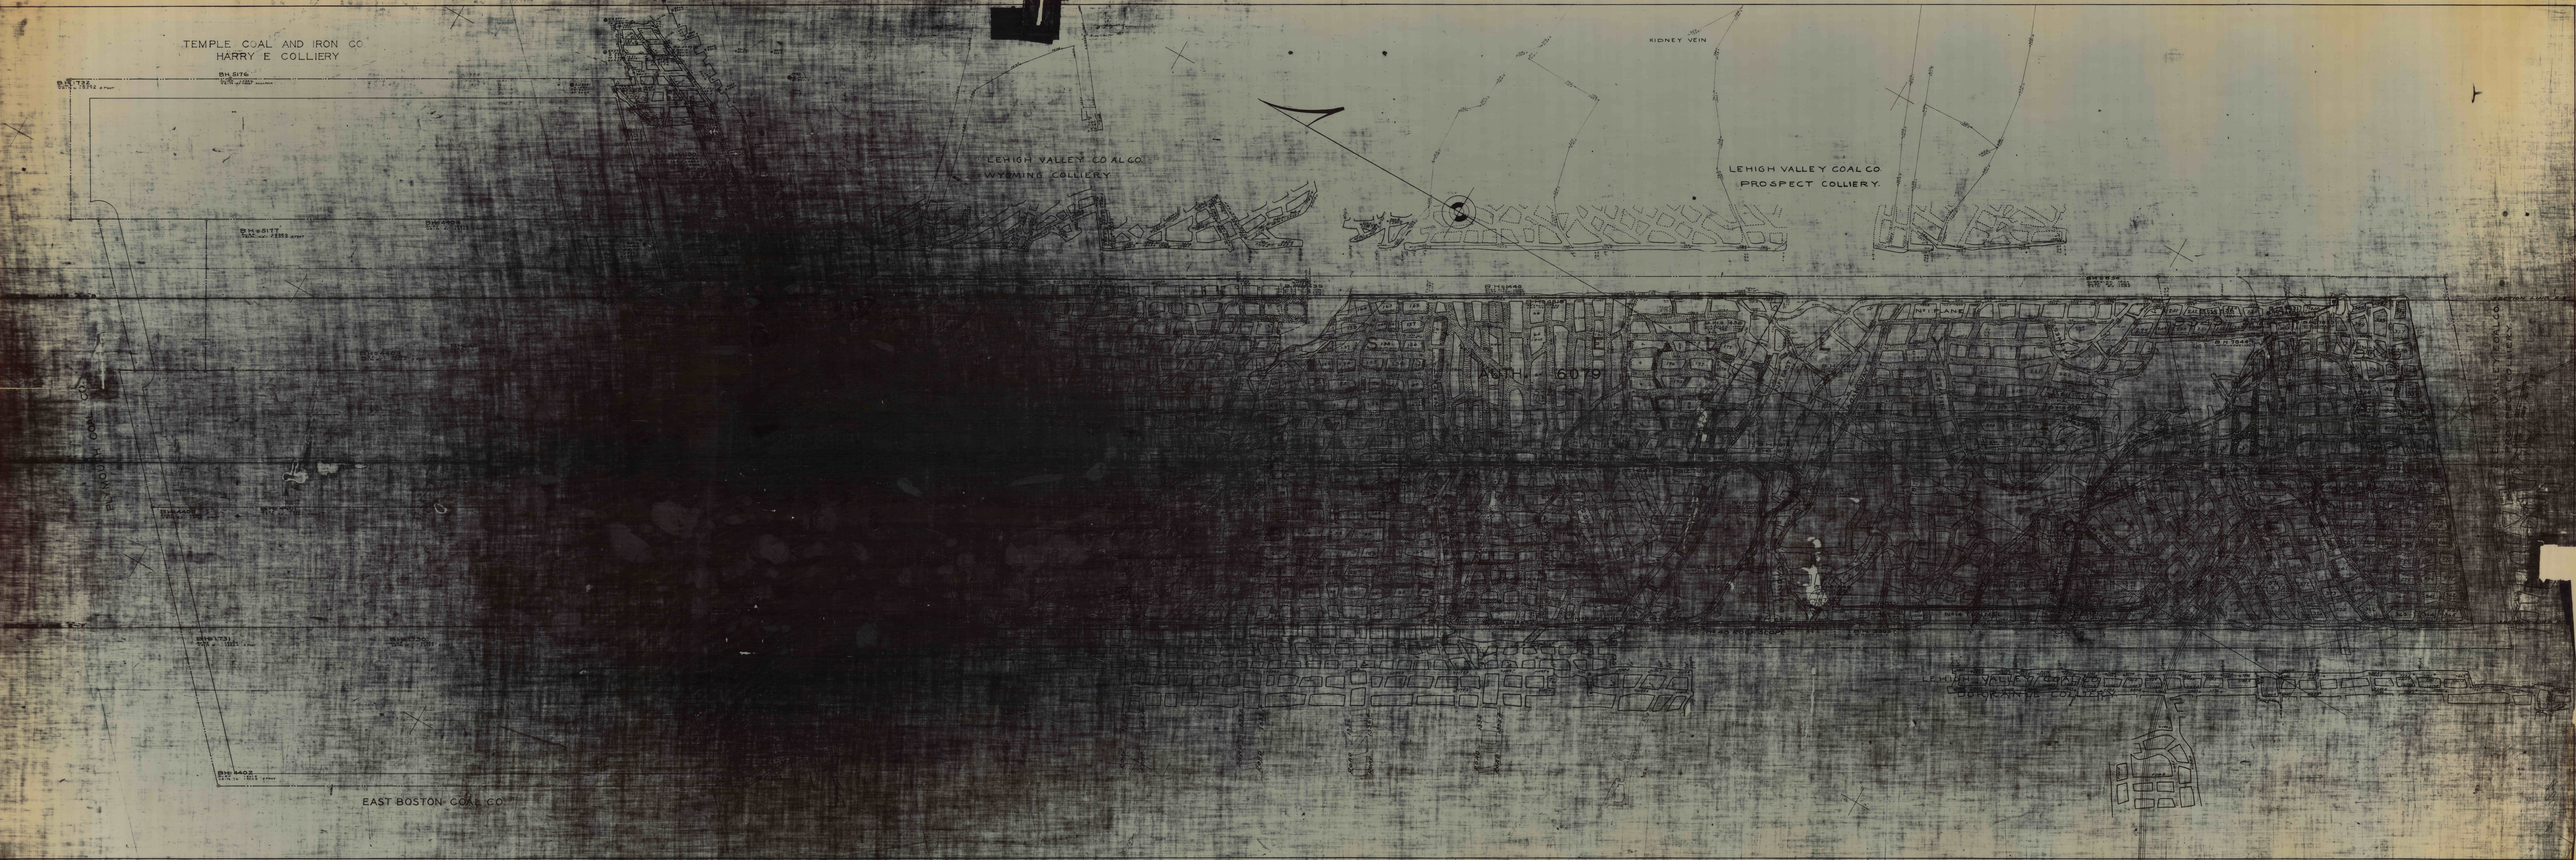
TEMPLE COAL AND IRON CO
HARRY E COLLIERY
LEHIGH VALLEY COAL CO
WYOMING COLLIERY
KIDNEY VEIN
LEHIGH VALLEY COAL CO
PROSPECT COLLIERY
AUTH. 6079
EAST BOSTON COAL CO