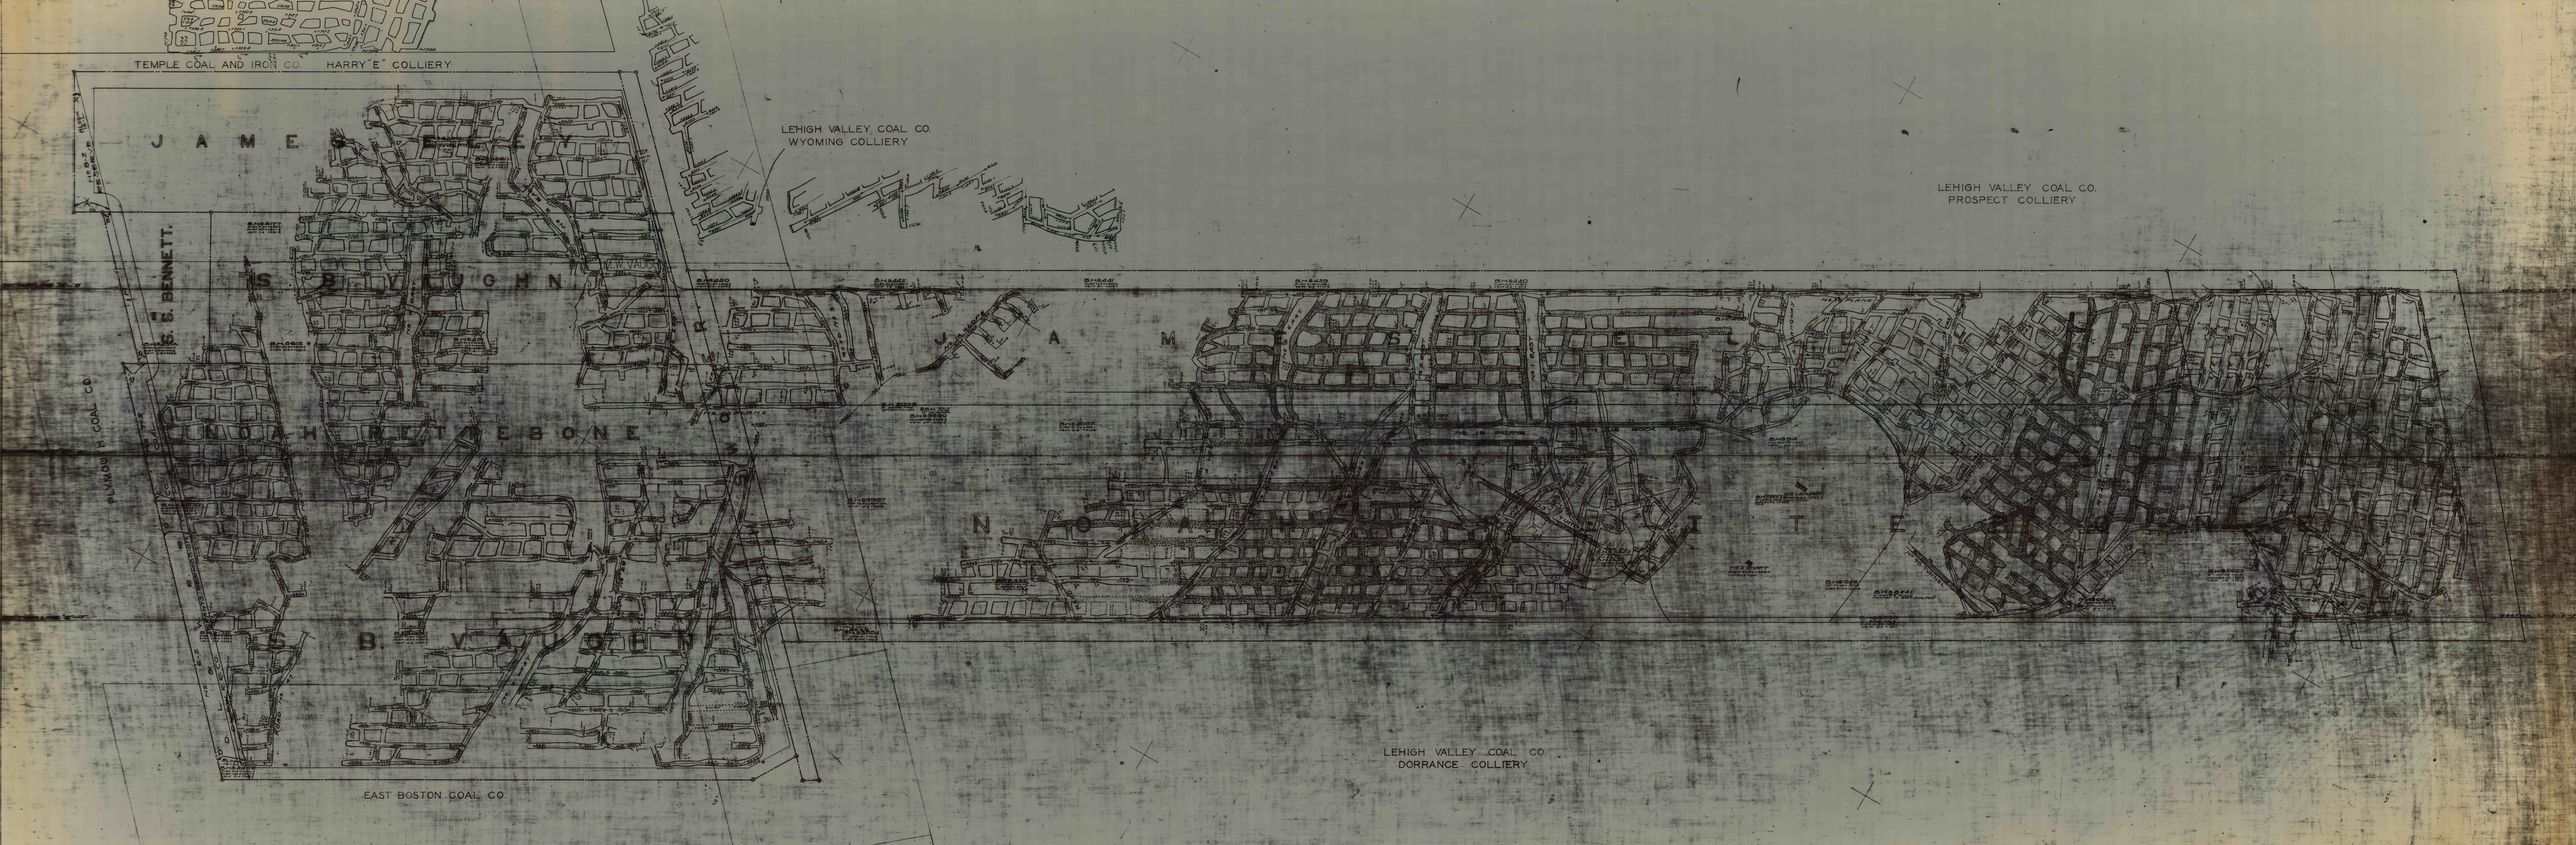
TEMPLE COAL AND IRON CO. HARRY E. COLLIERY
LEHIGH VALLEY COAL CO. WYOMING COLLIERY
LEHIGH VALLEY COAL CO. PROSPECT COLLIERY
J A M E S
E L L Y
S B U C H N
U N H R T O E B O N E
S B V A U E N
J A M E S
N O A H
U.S. BENNETT.
PLYMOUTH COAL CO.
EAST BOSTON COAL CO.
LEHIGH VALLEY COAL CO. DORRANCE COLLIERY