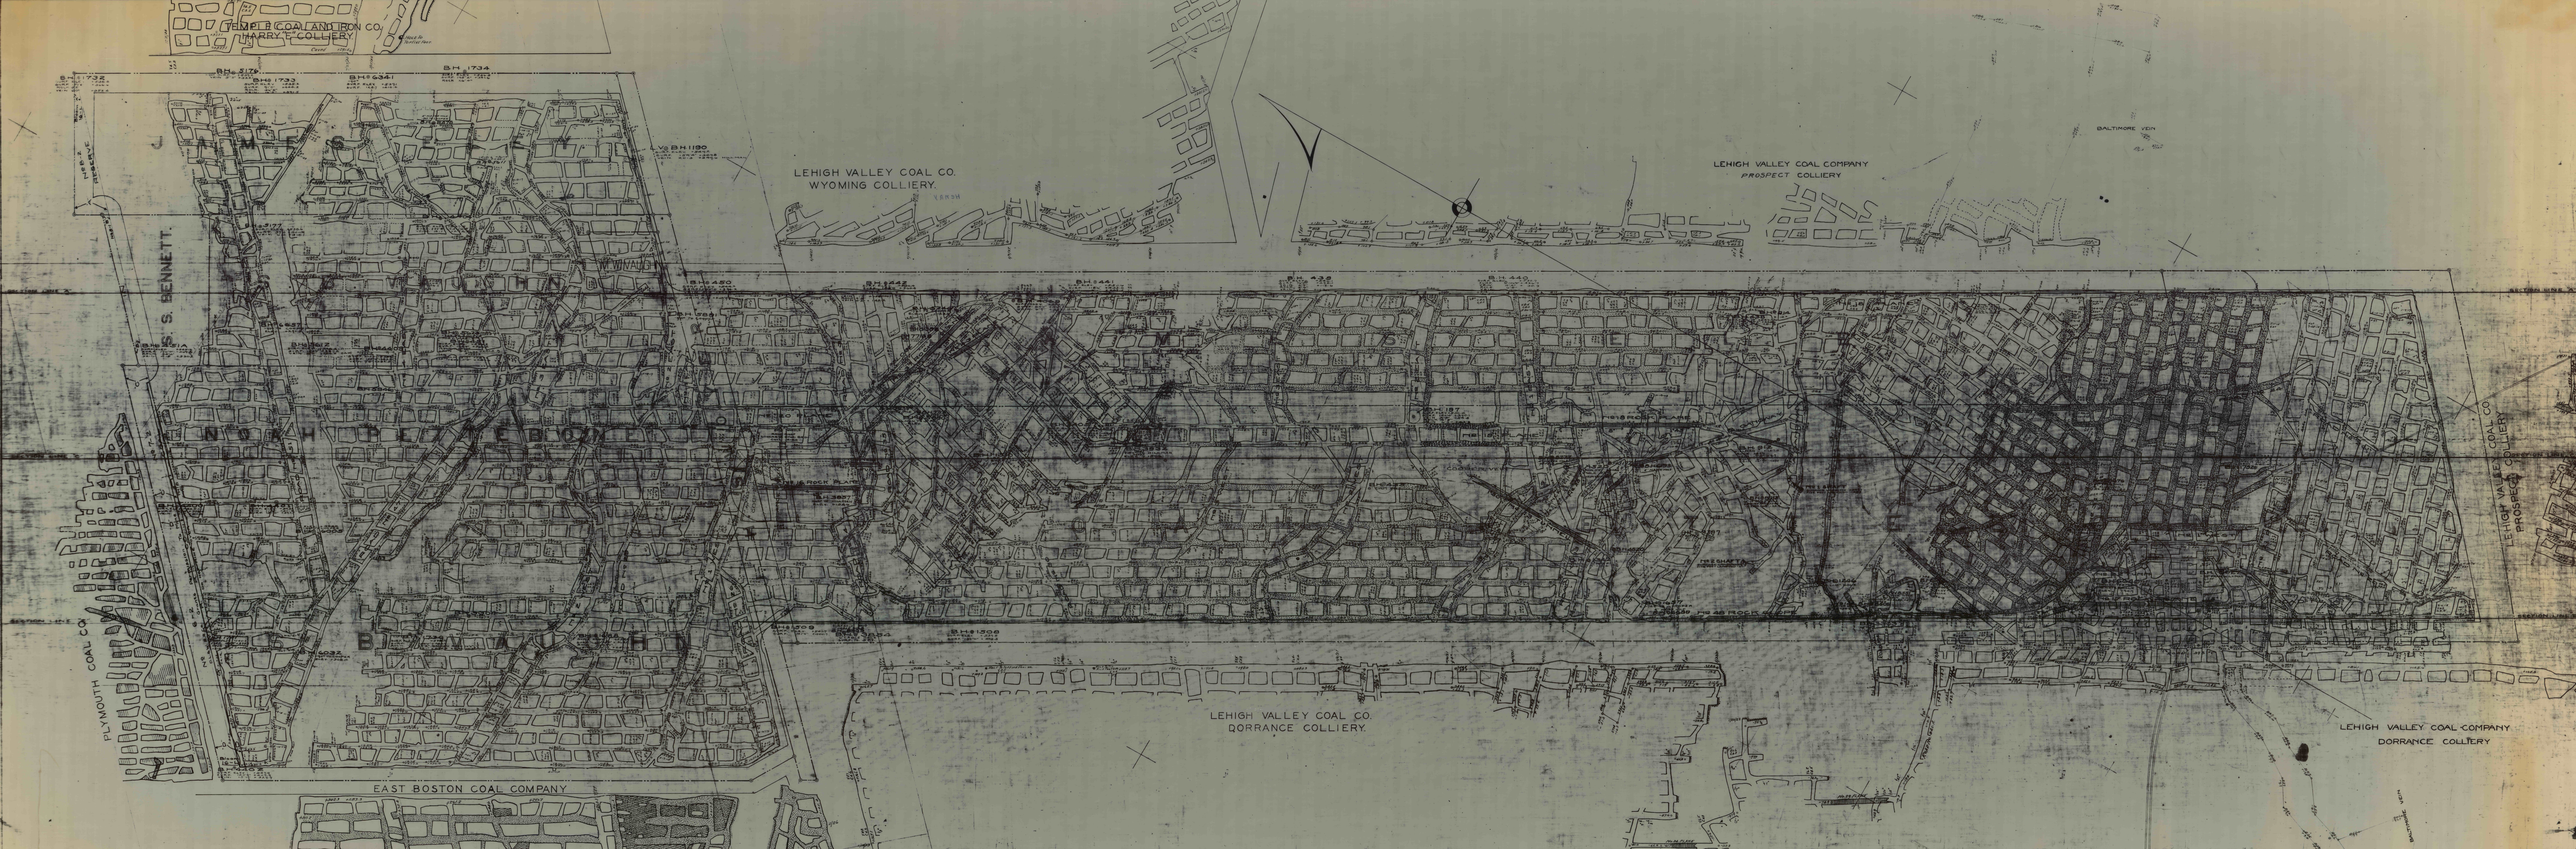
TEMPLE COAL AND IRON CO.
HARRY E. COLLIERY
LEHIGH VALLEY COAL CO.
WYOMING COLLIERY.
LEHIGH VALLEY COAL COMPANY
PROSPECT COLLIERY
BALTIMORE VEIN
S. S. BENNETT.
PLYMOUTH COAL CO.
EAST BOSTON COAL COMPANY
LEHIGH VALLEY COAL CO.
DORRANCE COLLIERY.
LEHIGH VALLEY COAL COMPANY
DORRANCE COLLIERY
LEHIGH VALLEY COAL CO.
PROSPECT COLLIERY