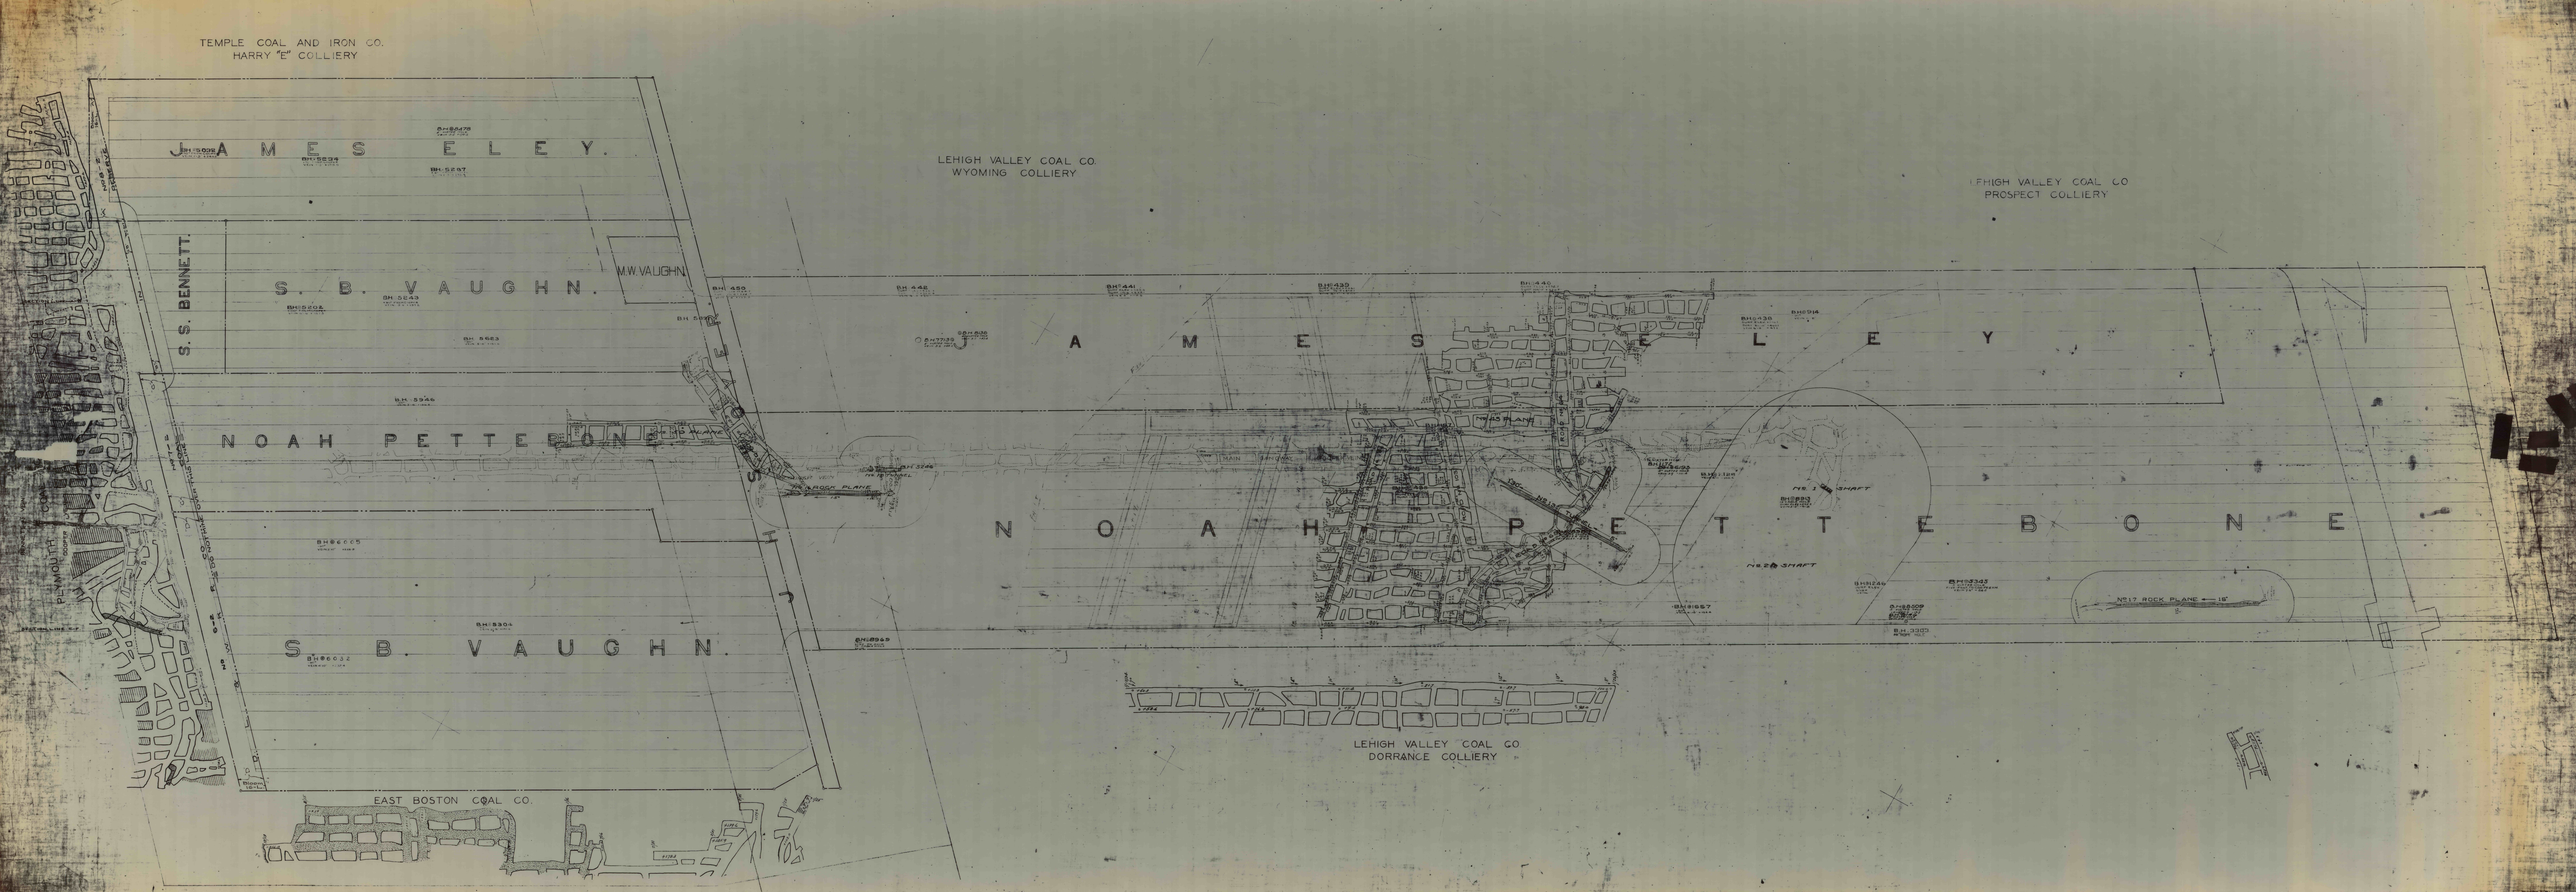
TEMPLE COAL AND IRON CO.
HARRY "E" COLLIERY
JAMES ELEY.
S. S. BENNETT.
S. B. VAUGHN.
M.W. VAUGHN.
NOAH PETTEBONE
S. B. VAUGHN.
LEHIGH VALLEY COAL CO.
WYOMING COLLIERY
JAMES ELEY
NOAH PETTEBONE
LEHIGH VALLEY COAL CO
PROSPECT COLLIERY
LEHIGH VALLEY COAL CO
DORRANCE COLLIERY
EAST BOSTON COAL CO.
PLYMOUTH