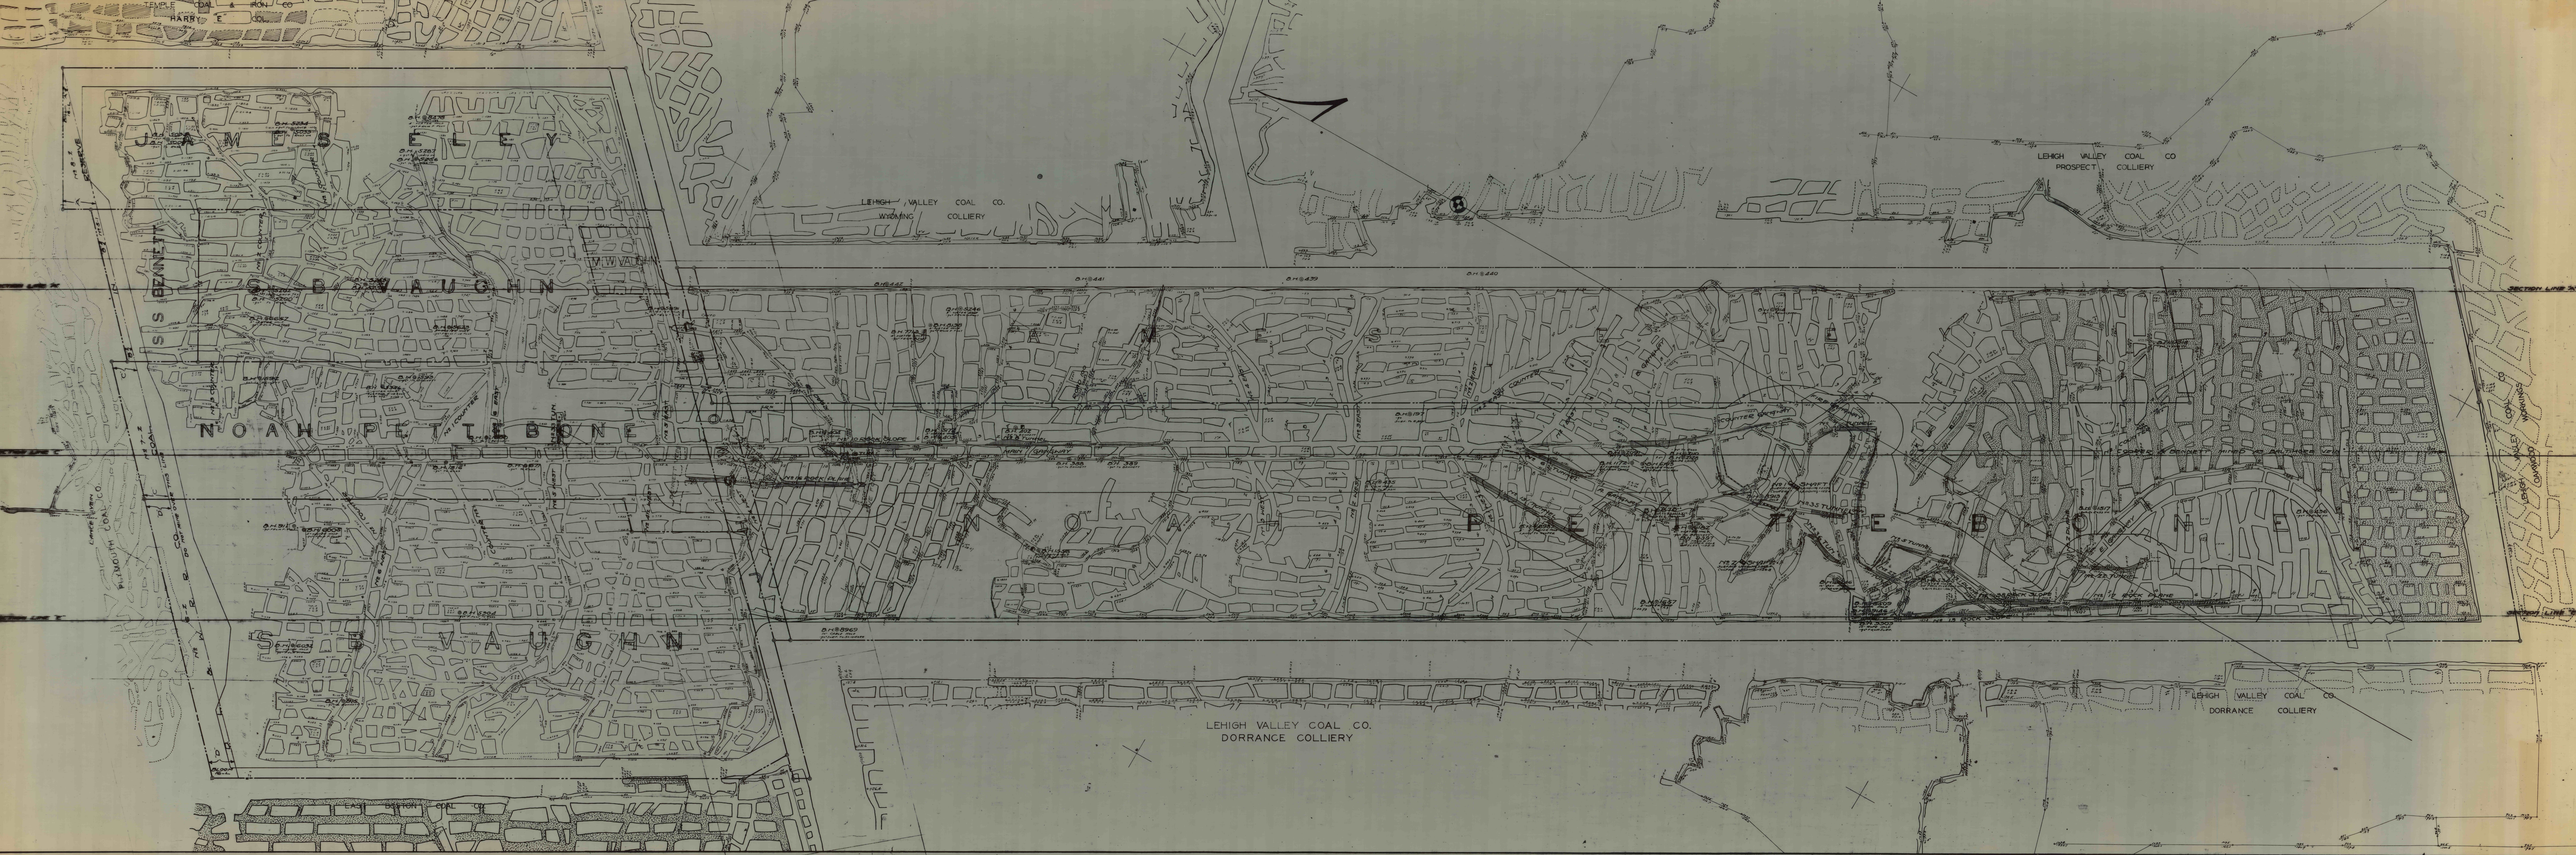
TEMPLE IRON CO.
HARRY E. COX
JAMES ELLEY
S. B. VAUGHN
S. S. BENNETT
NOAH PETTEBONE
S. E. VAUGHN
LEHIGH VALLEY COAL CO.
WYOMING COLLIERY
LEHIGH VALLEY COAL CO
PROSPECT COLLIERY
LEHIGH VALLEY COAL CO.
DORRANCE COLLIERY
LEHIGH VALLEY COAL CO.
DORRANCE COLLIERY