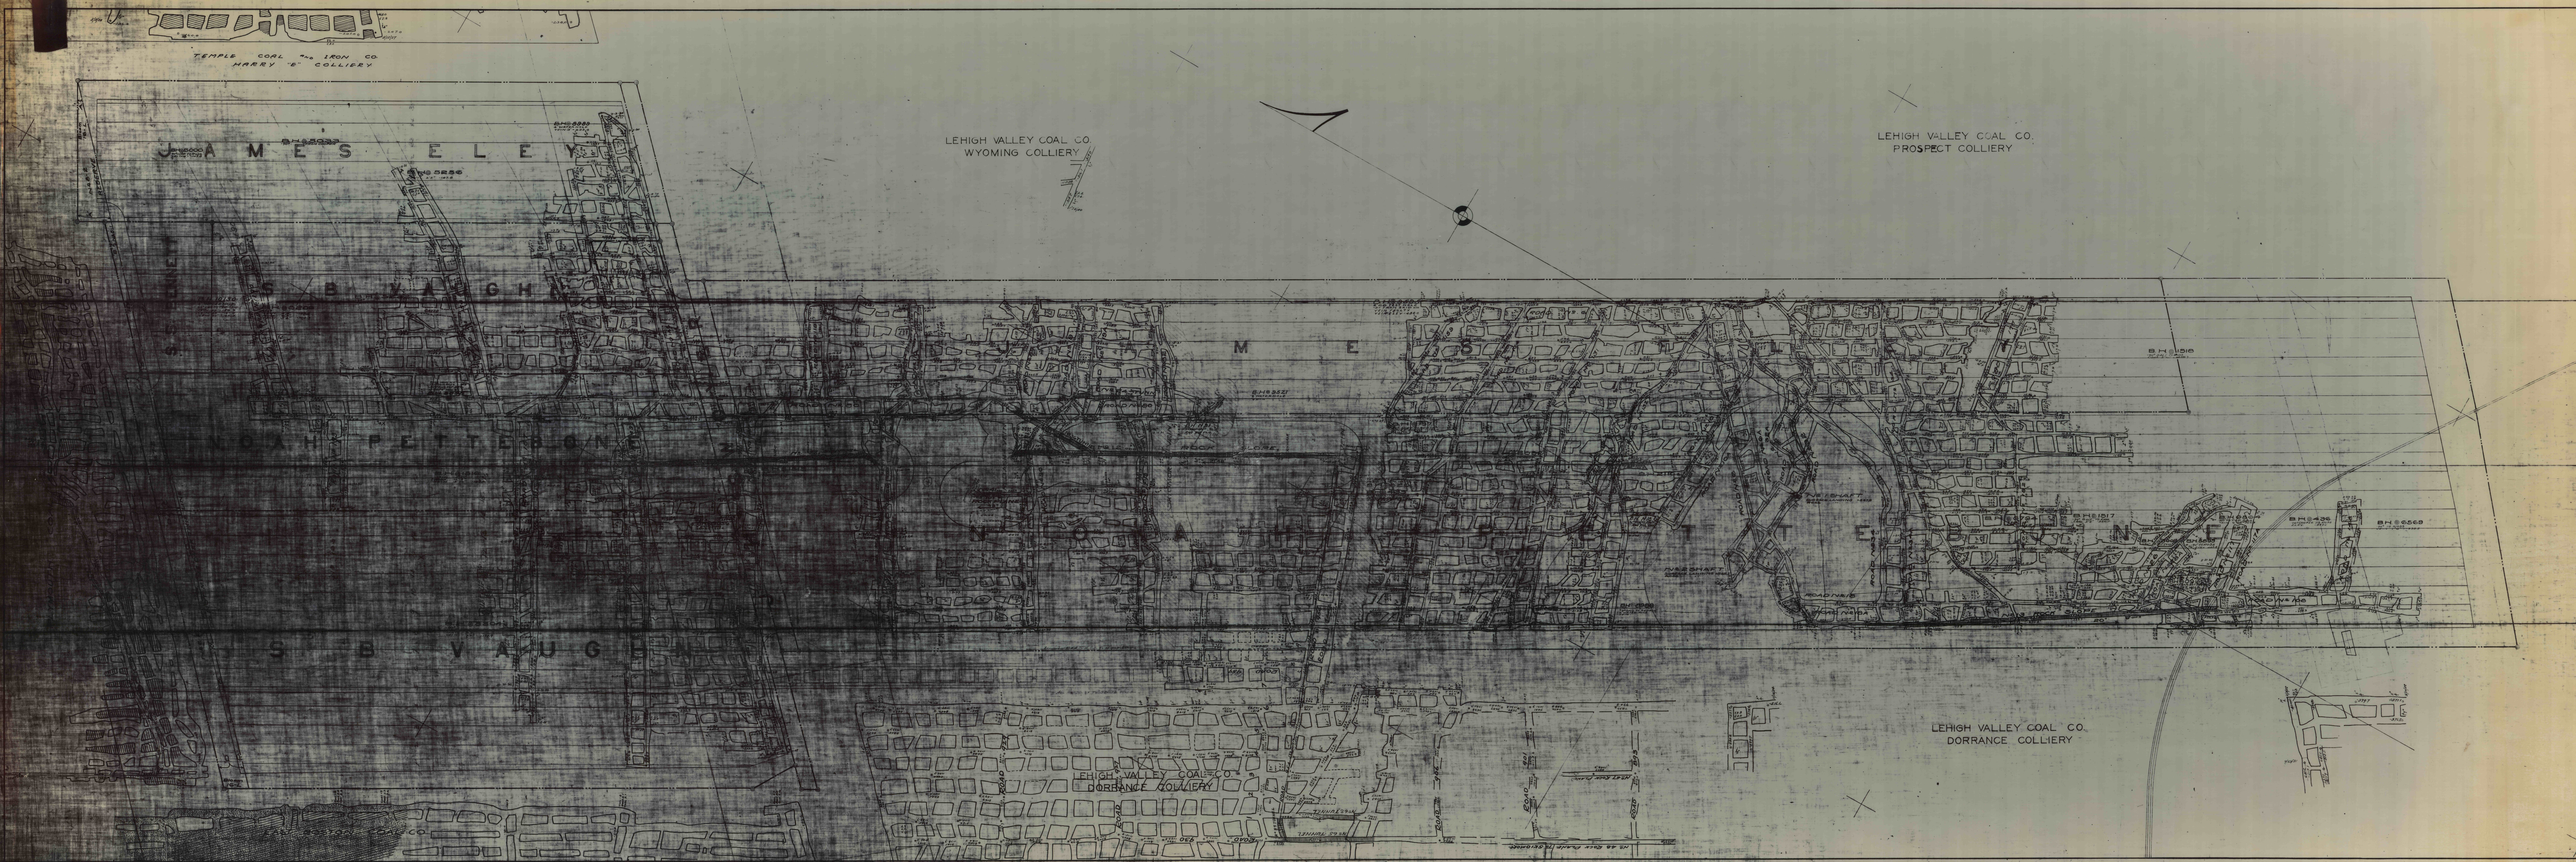
TEMPLE COAL & IRON CO.
HARRY "B" COLLIERY
LEHIGH VALLEY COAL CO.
WYOMING COLLIERY
LEHIGH VALLEY COAL CO.
PROSPECT COLLIERY
A M E S E L E Y
S B V A U G H N
N O A H P E T T E B O N E
S B V A U G H N
LEHIGH VALLEY COAL CO.
DORRANCE COLLIERY
LEHIGH VALLEY COAL CO.
DORRANCE COLLIERY