

PARRISH ST.


HIGH ST.

PROP. LINE

TOP of CONC. 596.87

Fin Flr. Eleu.
598.5

Fin Flr. Eleu.
598

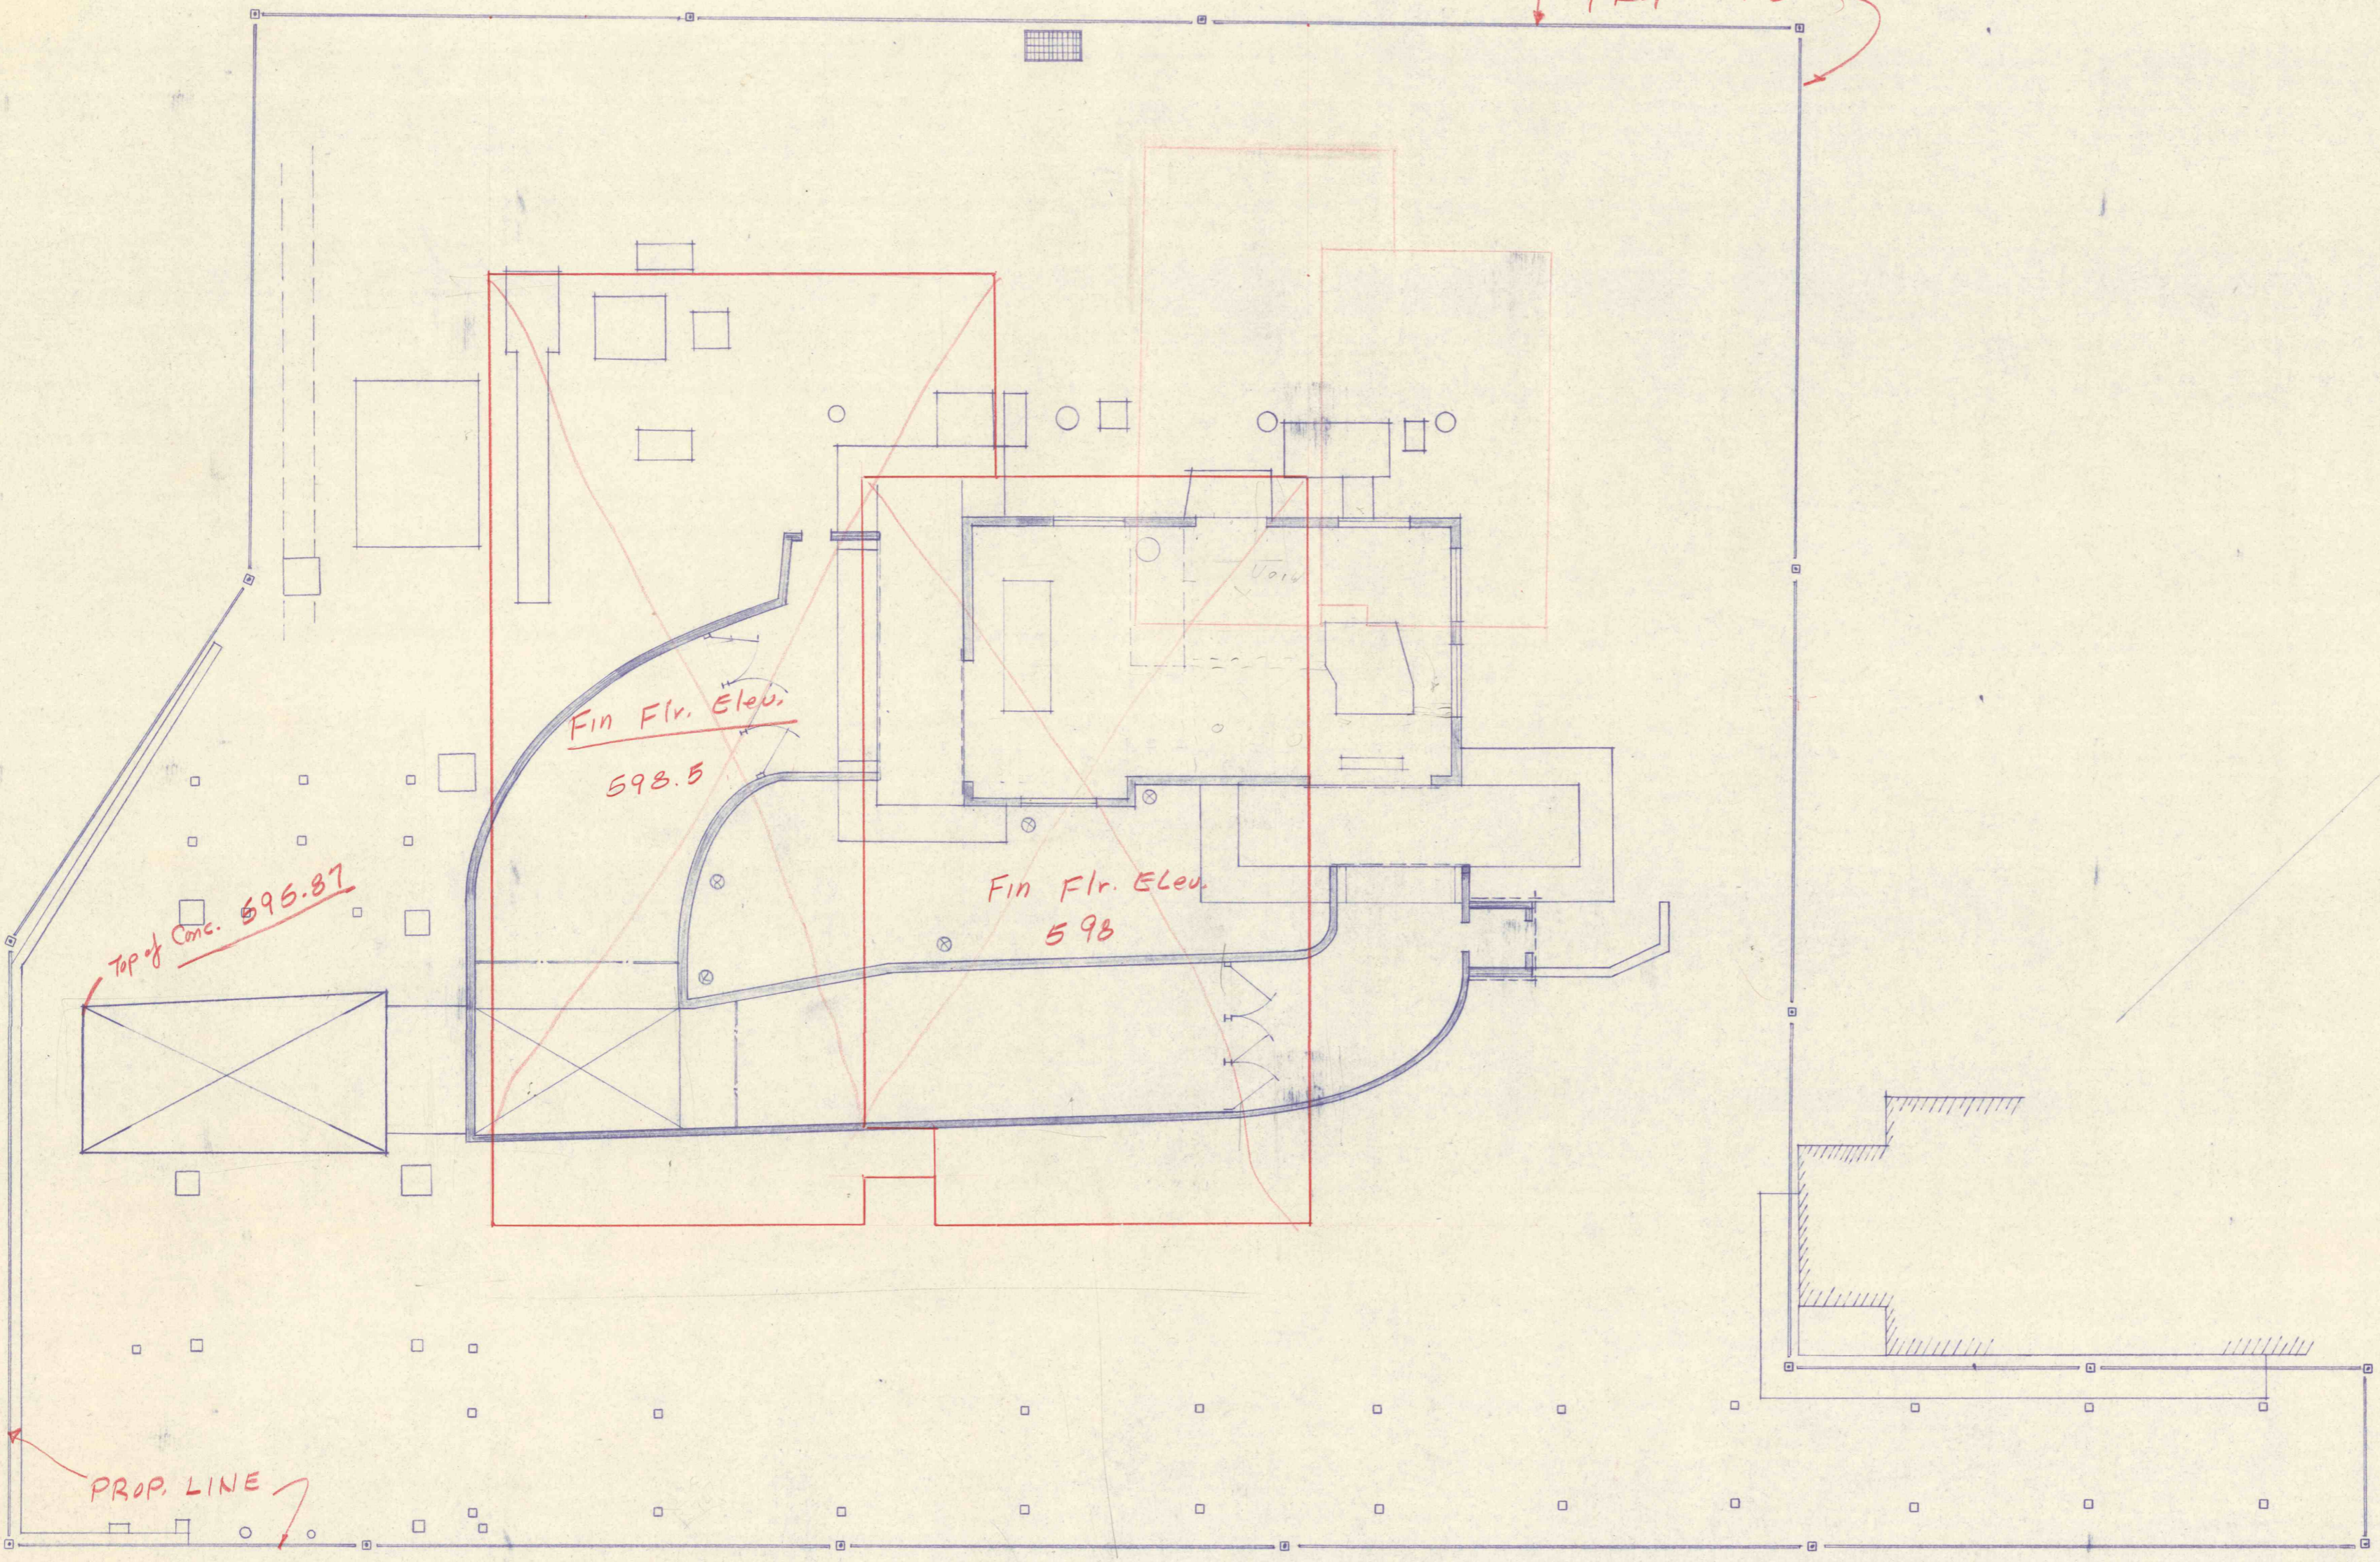

60
 1500
 920
 3000
 10500
 121000

REVISIONS:		
SCALE:		
DATE:		
DWN BY:		
CHK BY:		
JOB NO:		
CARL J. SCHMITT ASSOCIATES REGISTERED ARCHITECTS 138 NORTH MAIN STREET WILKES-BARRE, PENNSYLVANIA		DWG. NO: D-1