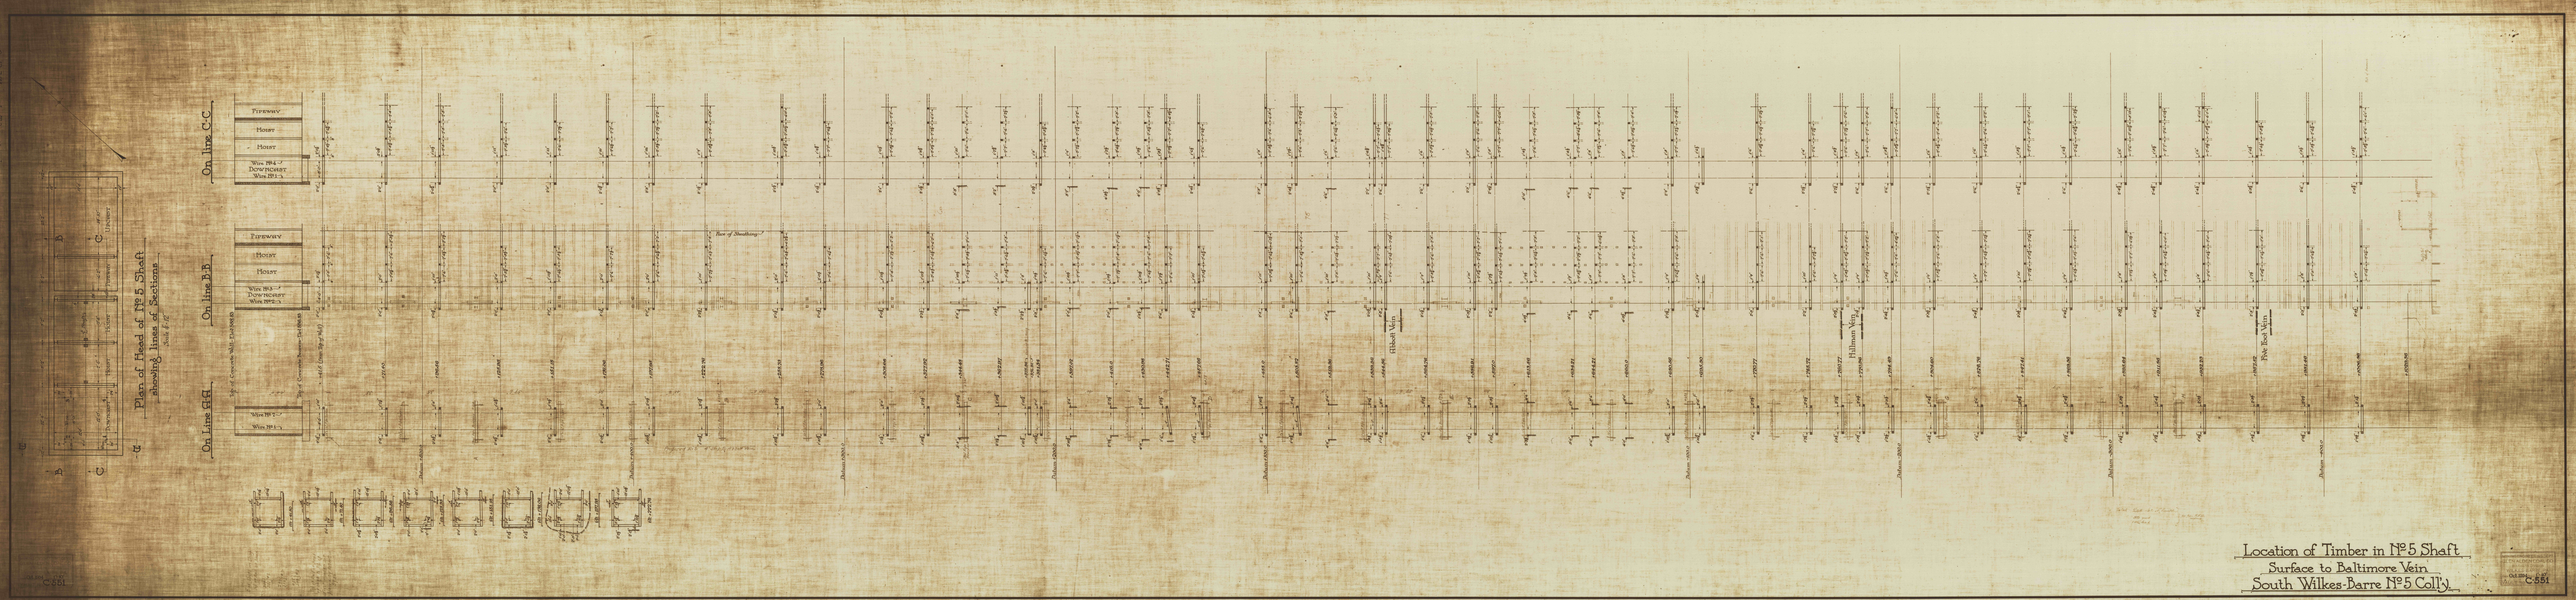
Plan of Head of No 5 Shaft
showing lines of Sections
Scale 1/16"
On line C-C
On line B-B
Fireway
Hoist
Hoist
Wire 184 of Downcast Wire 151
Wire 183 of Downcast Wire 152
Wire 181
Wire 180
Top of Concrete Wall protected
Top of Concrete Floor 1/2" thick
Level Line Wire 143
Floor of Shaftway
Baltimore Vein
Hillman Vein
Pike Bed Vein
Baltimore 1000
Baltimore 1100
Baltimore