



AUCHINCLOSS N°1

ELEV +720.73

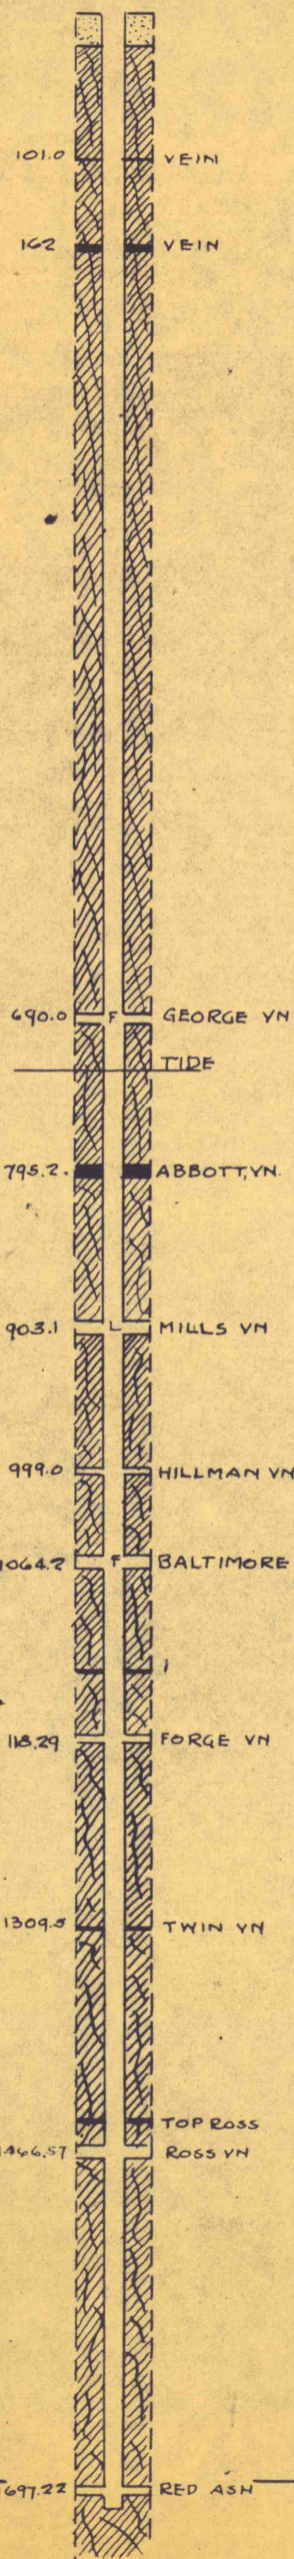


AUCHINCLOSS N°2

ELEV +721.51

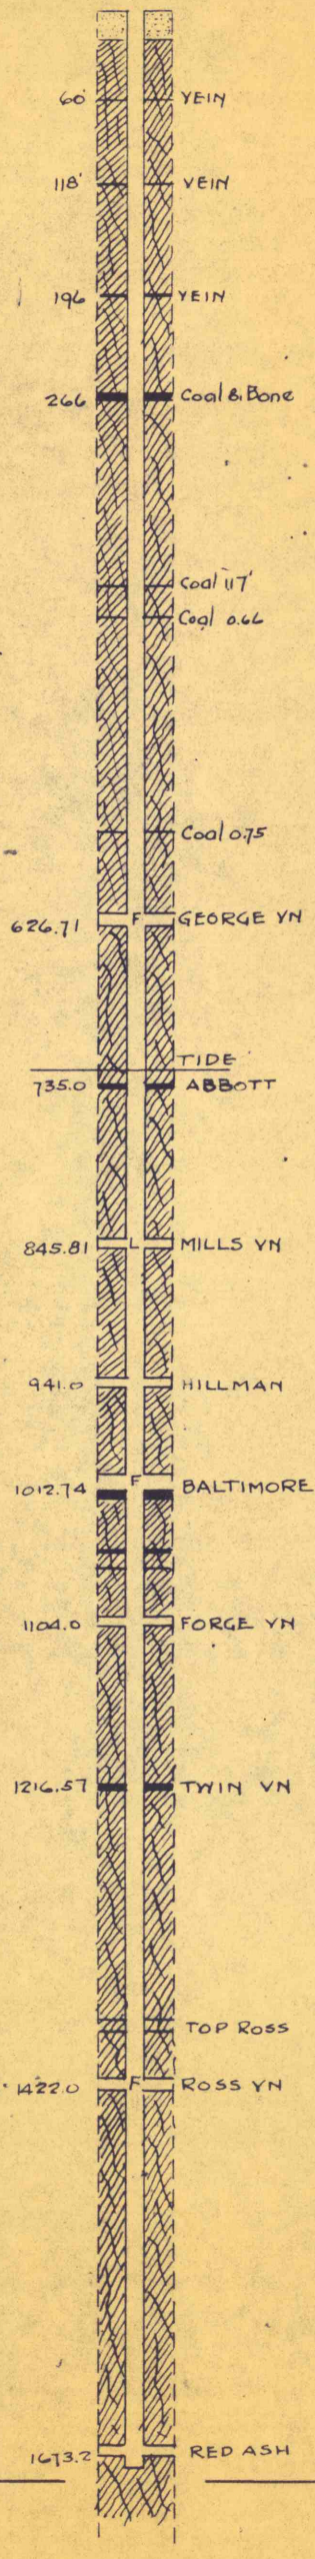


BLISS N°1

ELEV +744.82

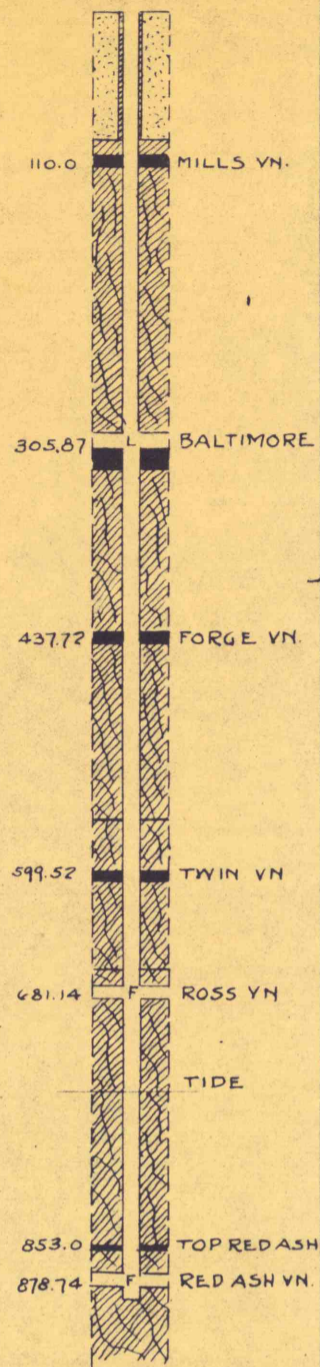


BLISS N°2

ELEV +742.7

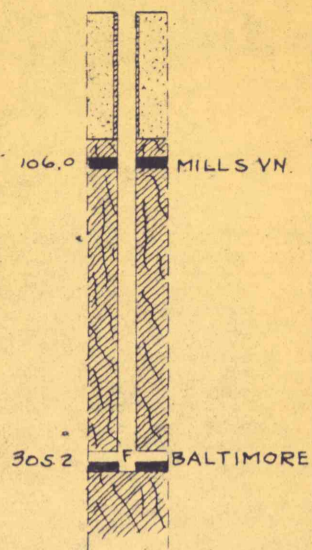


TRUESDALE N°1

ELEV +723.45

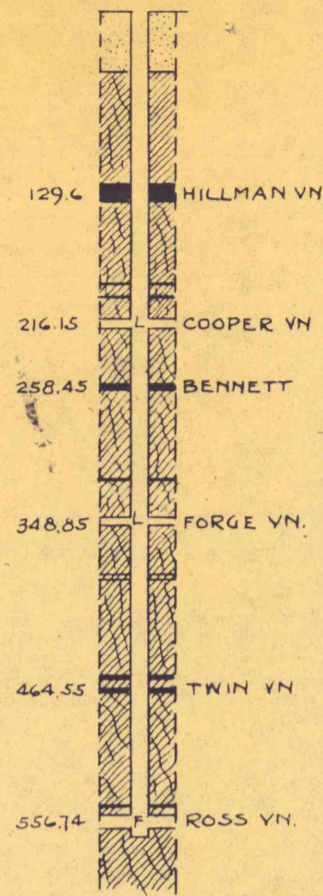

TRUESDALE N°2

ELEV +722.5

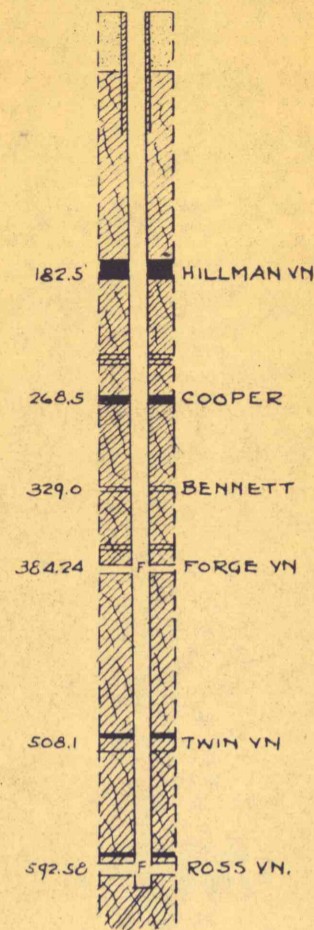

ASKAM

ELEV +620.64

