



B.H. S-468
+577.5

1000 N





COMMON SHAFES

B.H. 8470
+609.0

B.H. 6655
+654.7

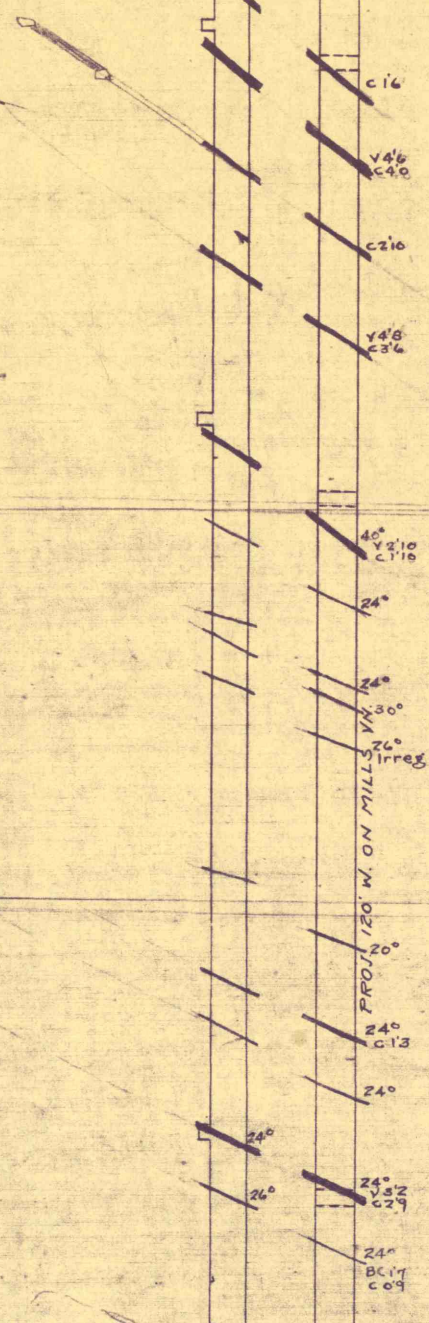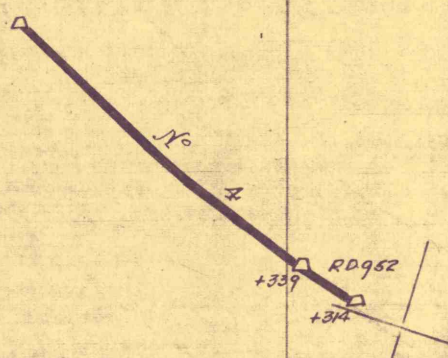

1000 East

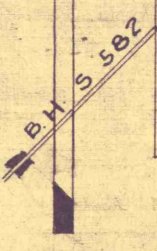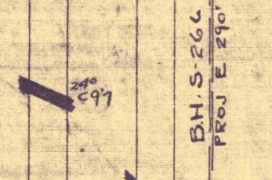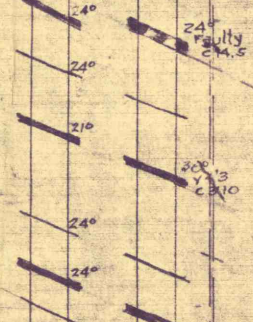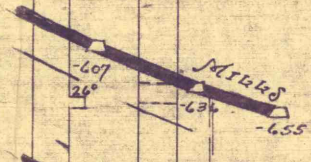

BH. S-586
TO RED SHALE

